


PERSONNEL	TITLE	PERSONNEL	TITLE	COUNTY	DATE
MENNITT		AMBROSE		LUCAS	3/28/62
BECK	T			S. R. U.S. # 24	WEATHER clear
LEE				SEC.	TEMP. 60°
ANDO					JOB NO. 02477

DESCRIPTION STAKING \pm

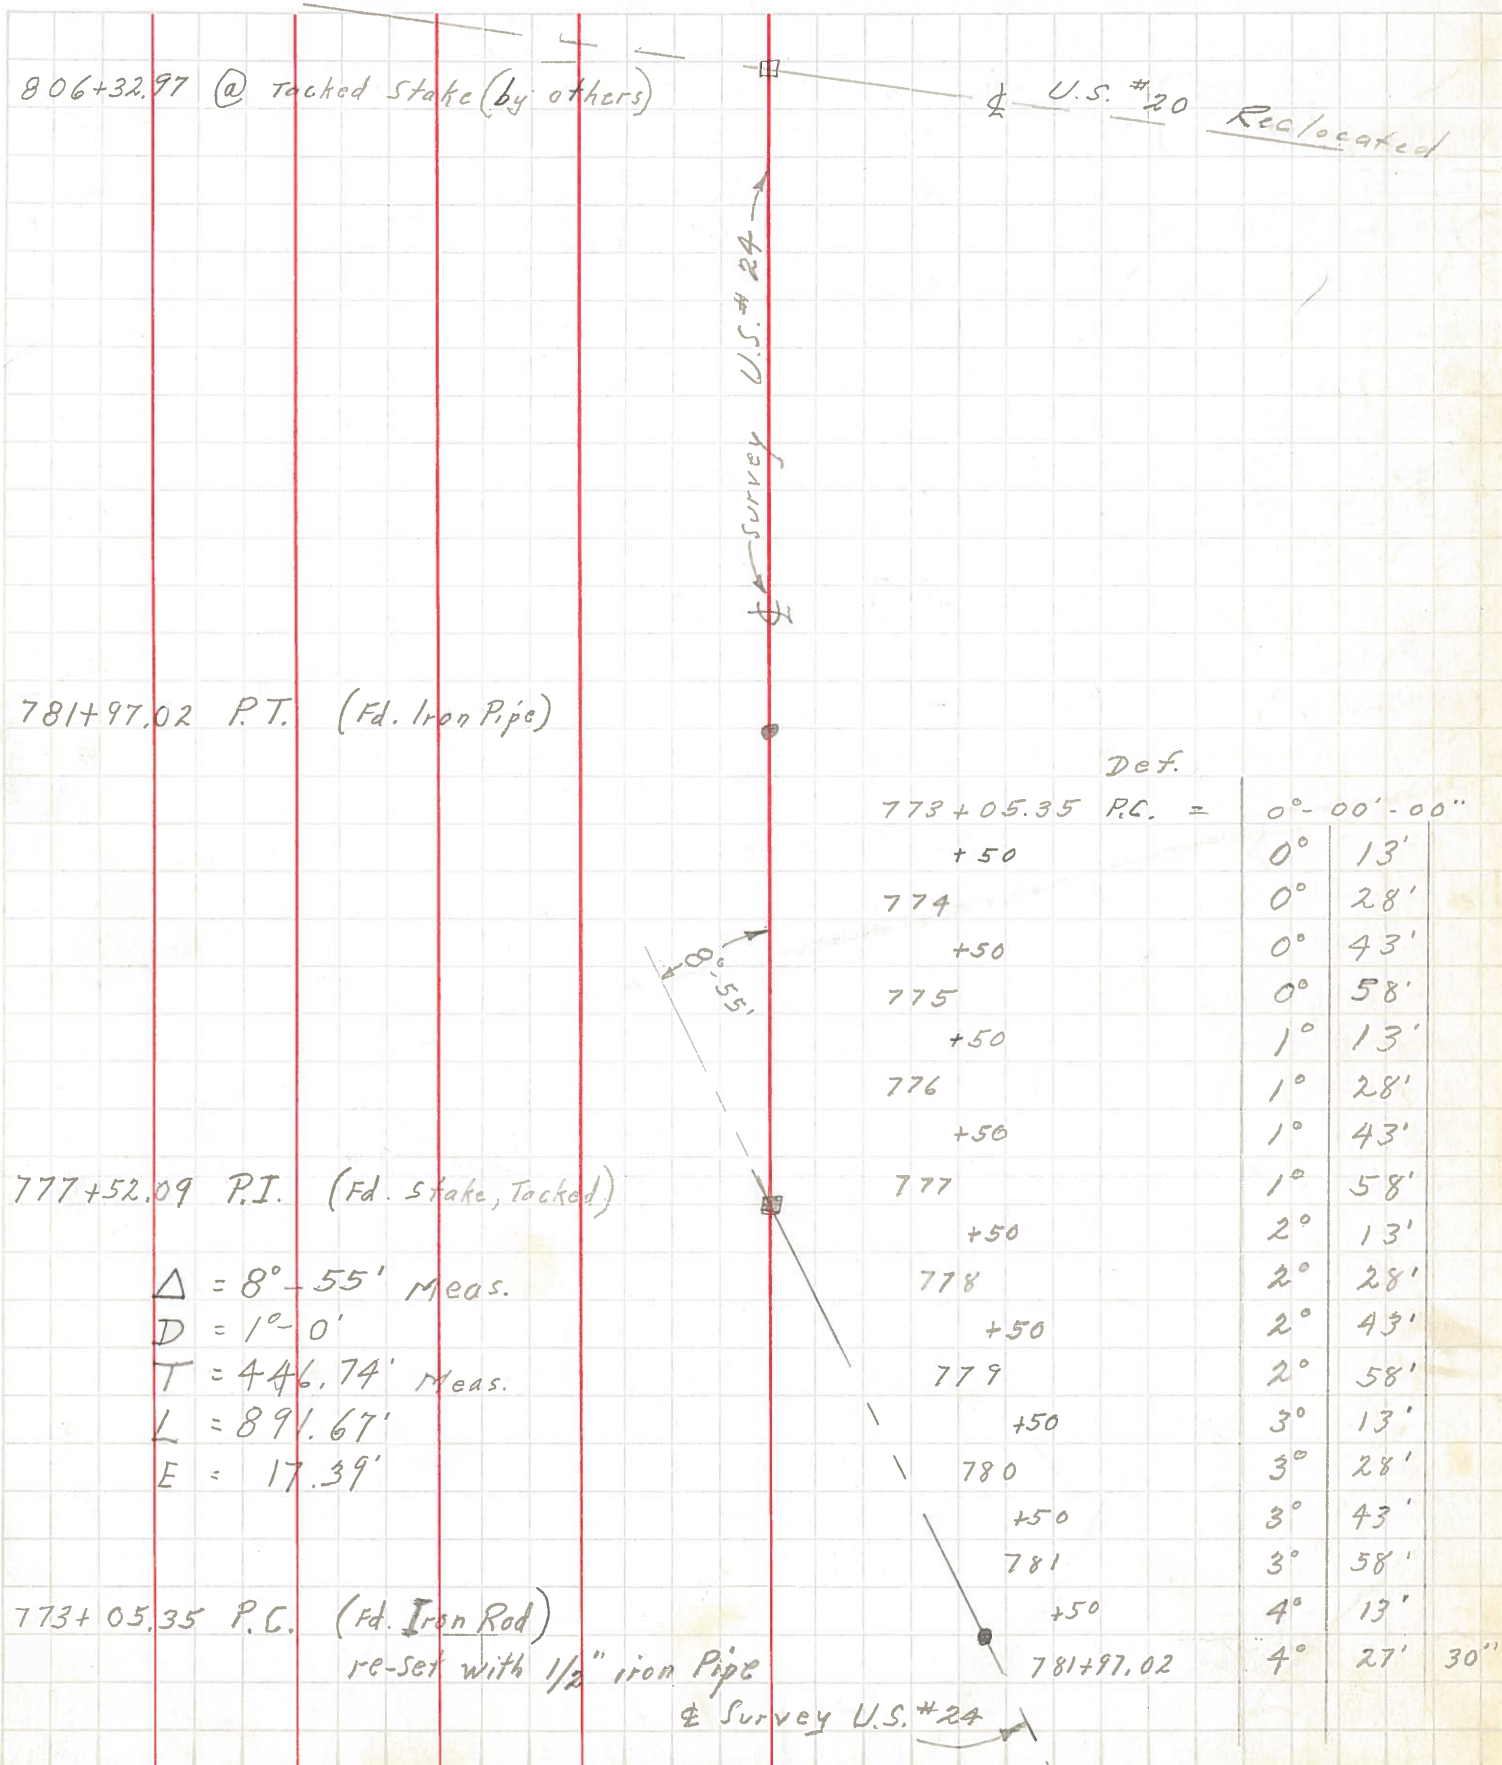

781+97.02 P.T. (Fd. Iron Pipe)

777+52.09 P.I. (Fd. Stake, Tacked)

$\Delta = 8^{\circ}-55'$ Meas.
 $D = 1^{\circ}-0'$
 $T = 446.74'$ Meas.
 $L = 891.67'$
 $E = 17.39'$

773+05.35 P.C. (Fd. Iron Rod)
 re-set with 1/2" iron Pipe

\pm Survey U.S. # 24