


O.D.O.T. DISTRICT 2 SURVEY OFFICE (USE ONLY)

PERSONNEL	REFERENCE NO.	68	SHEET	2	OF	4
NOTES	HOMAN	DATE	6/29/04	ROUTE	US 24	
H.C.	HUSS	WEATHER	SUNNY	COUNTY	LUCAS	
R.C.	NUHFER	TEMP.	60°	TOWNSHIP	MAUMEE	
				SECTION	2	
				T	1	N
				R		E


TYPE MONUMENT BENT 1" IPIPE
 ON SURFACE - BELOW 4"
 LEFT - ☉ PAV'T - RIGHT ON
- TO - EDGE PAVEMENT
 S.L.M. 871+99

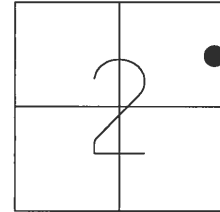

GRID: NORTHING: - EASTING: -

RECORD:
 SET MAG/WASHER
 8/25/04, DCH

NOTE:
 8.5' EAST OF
 ☉ FORD ST SOUTH

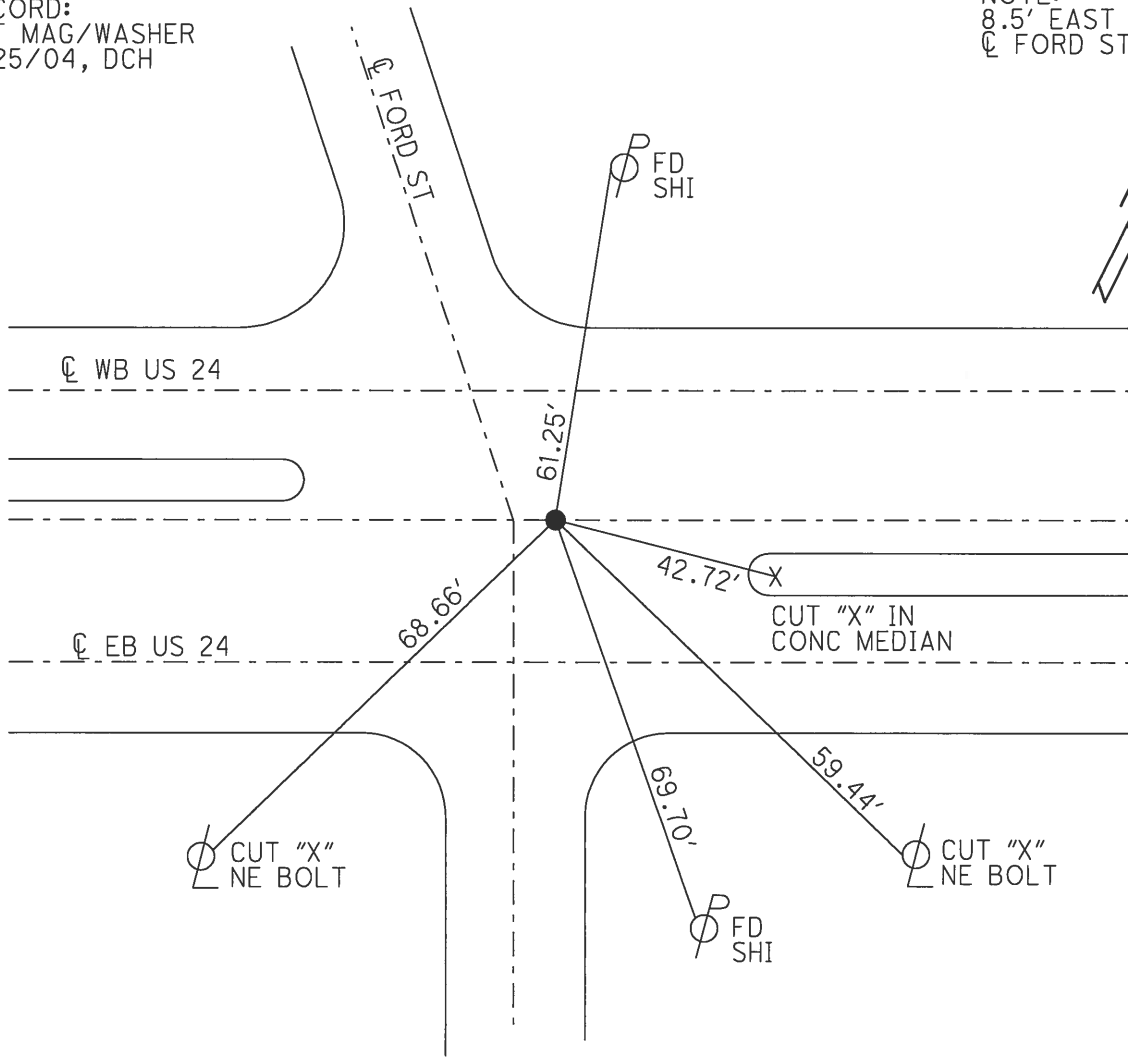

O.D.O.T. DISTRICT 2 SURVEY OFFICE

PERSONNEL

REFERENCE NO. 68

SHEET 2 OF 4

NOTES HOMAN

DATE 6-29-04

ROUTE US SR 24

H.C. HUSS

WEATHER SUNNY

COUNTY LUCAS

R.C. NUHFER

TEMP. 60°

TOWNSHIP moreland

SECTION R.T. 23

T N R E

City of maumee

TYPE MONUMENT FD BENT 1 1/2" PIPE


~~ON SURFACE~~ - BELOW 4"

~~LEFT~~ - Q PAV'T - ~~RIGHT~~ ON


TO EDGE PAVEMENT

S.L.M. 871+99

8.5' EAST OF Q FORD ST SOUTH

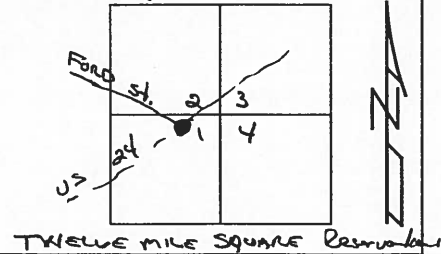


RESET MAG NAIL
& WASHER
8-25-04
DCH

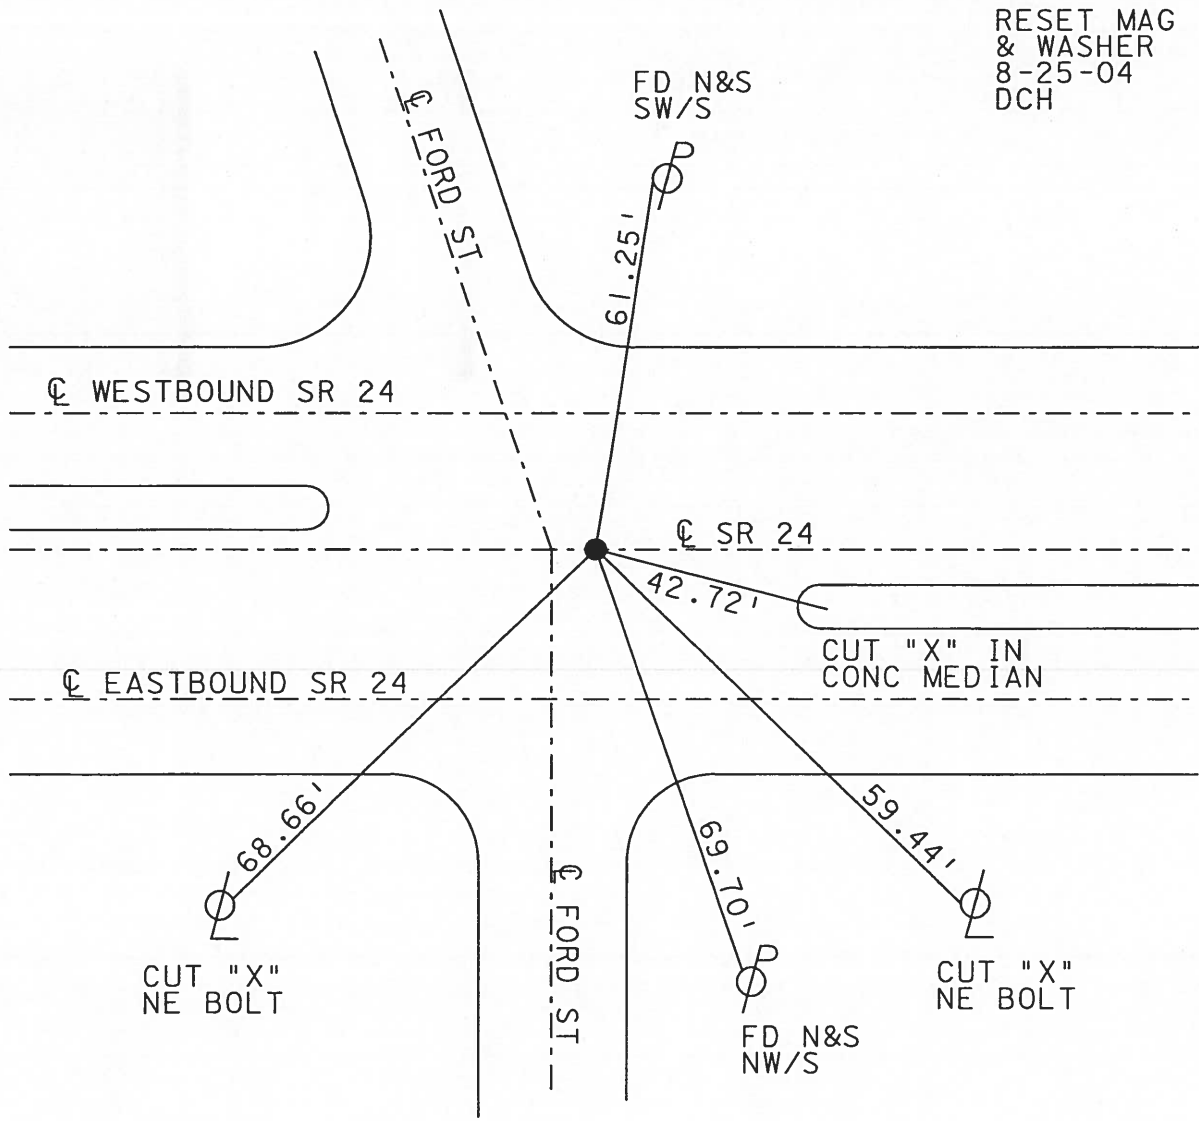

PERSONNEL	TITLE	PERSONNEL	TITLE	COUNTY	DATE
Stone	Notes			Lucas	5 June 68
Beck	Flag			S. R. # 24	WEATHER Warm
Michalek	Tape			SEC. Maumee	TEMP. 80°
Schroder	Tape				

DESCRIPTION References to Control Points JOB NO. _____

LEFT CENTER LINE RIGHT

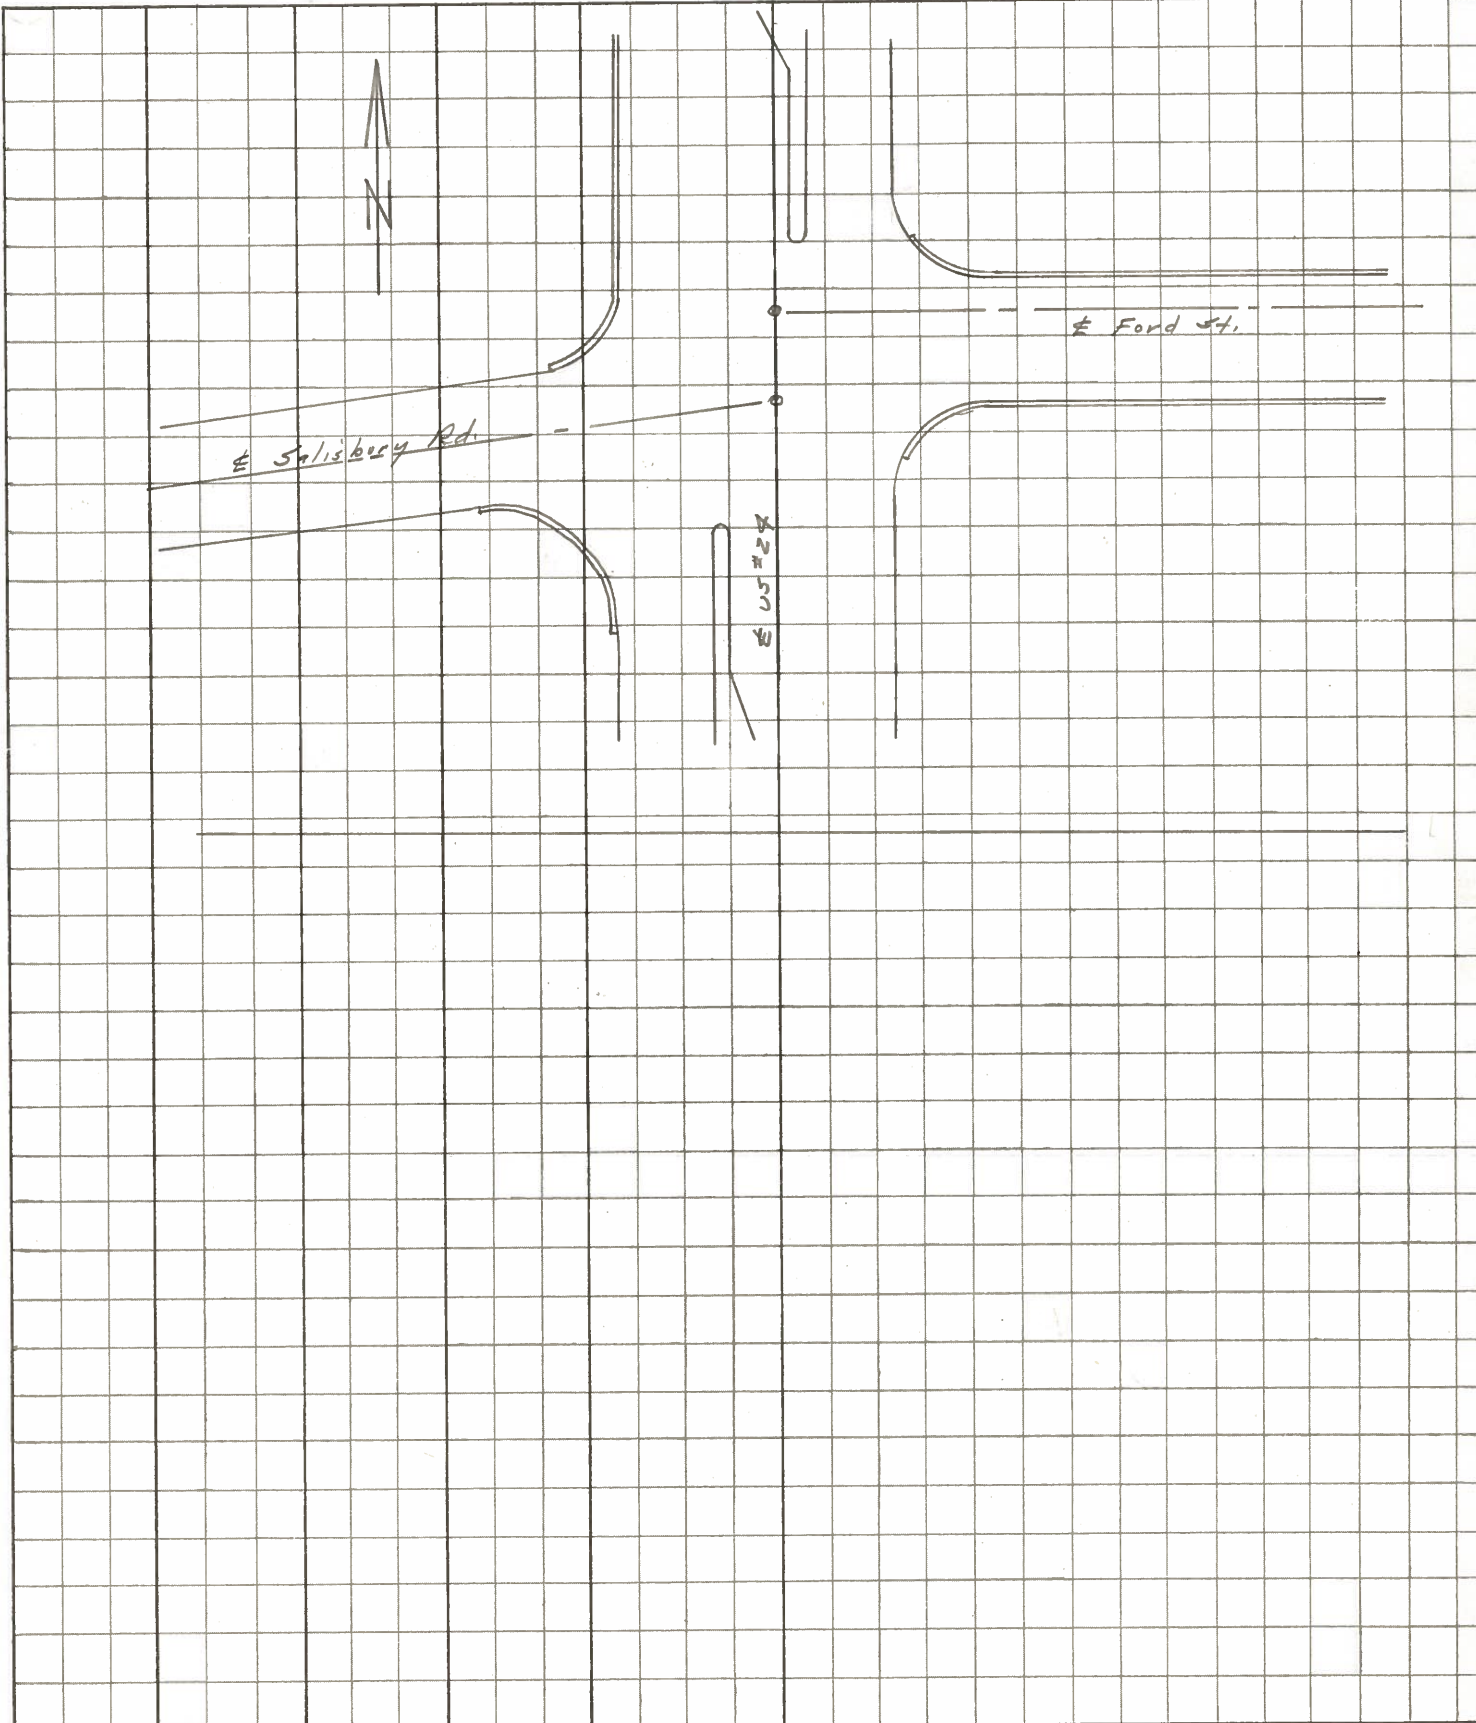

PERSONNEL TITLE PERSONNEL TITLE

COUNTY Lucas DATE 21 Feb. 66

Slane _____

S. R. #24 WEATHER Cool

Beck _____


SEC. Mounce TEMP. 28°

Crindley _____

Schroder _____

DESCRIPTION Acts To Control Pts. JOB NO. _____

LEFT CENTER LINE RIGHT

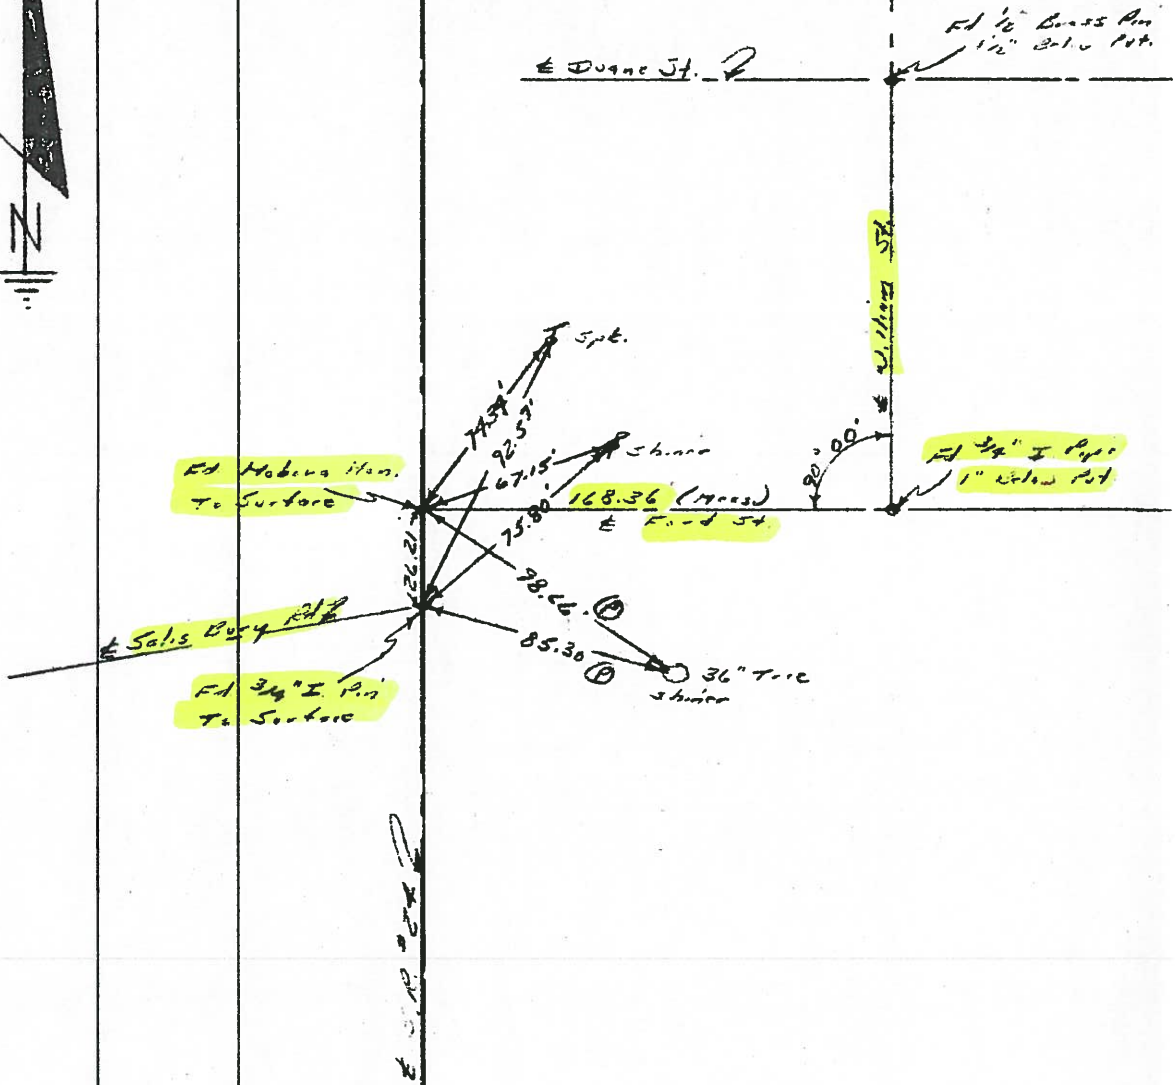

Ed Hobens item.
To Surface

Ed 3/4" I. Pipe
To Surface

168.36 (Hess)
E Field St.

Ed 3/4" I. Pipe
1" below Pot

Ed 1/2" Brass Pin
1/2" below Pot.

E. 11th St.

PERSONNEL TITLE PERSONNEL TITLE

Tomsic _____ COUNTY LUCAS DATE Dec. 1-1960


Neuser _____ S. R. 24 WEATHER Cloudy

Orluk _____ SEC. _____ TEMP. 25°

Norris _____


DESCRIPTION Alignment From Monclova To New U.S. #20 JOB NO. _____

LEFT CENTER LINE RIGHT

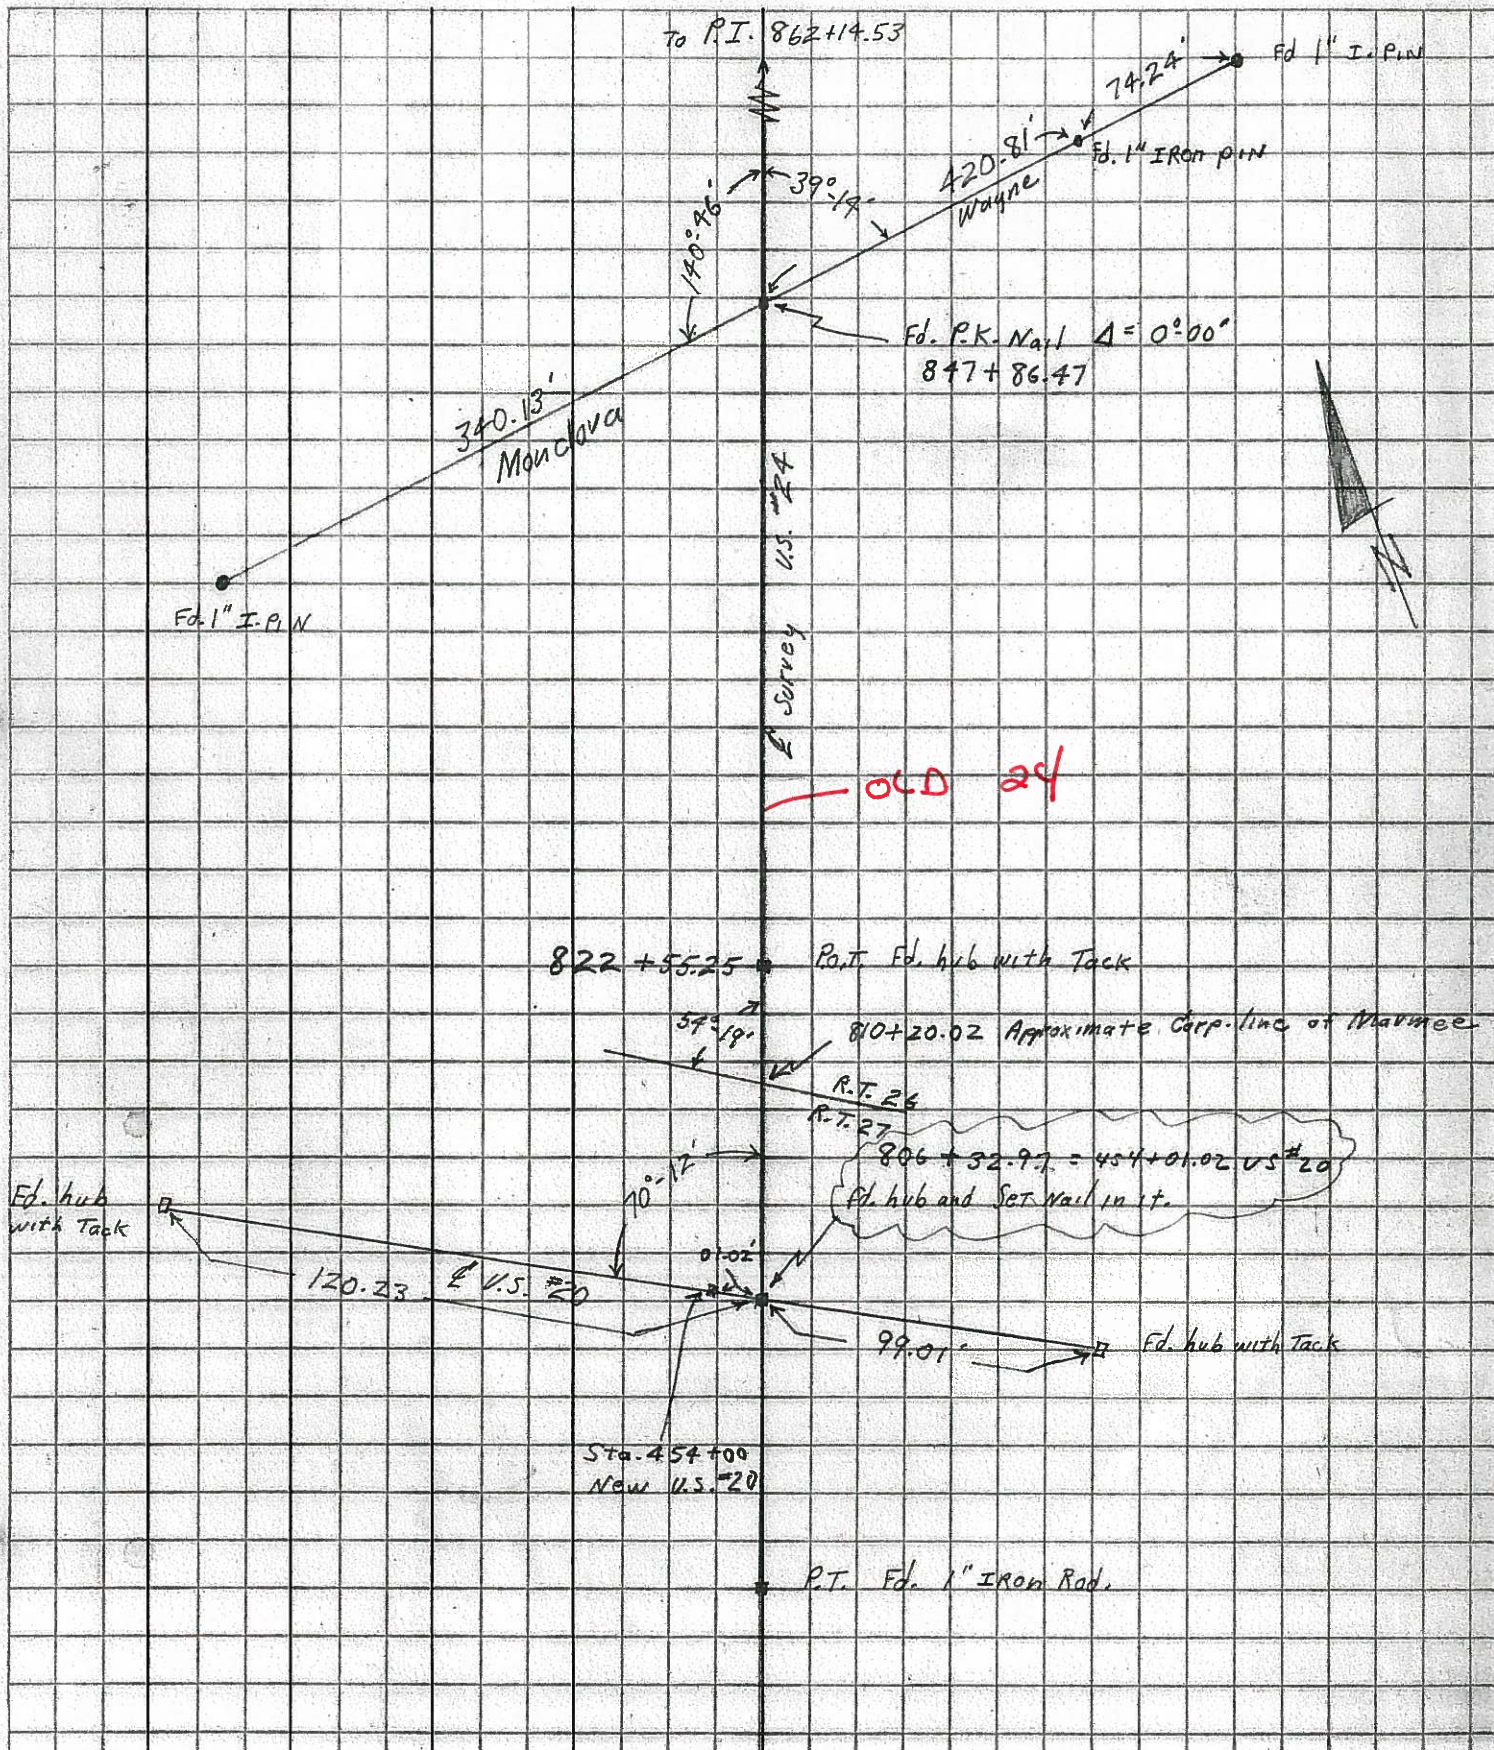

PERSONNEL	TITLE	PERSONNEL	TITLE	COUNTY	DATE	WEATHER	TEMP.
Stone				Lucas	21 Feb. 66	Cool	28°
Beck				S. R. #24			
Brindley				SEC. Maumec			
Schroder							

DESCRIPTION Rds. To Control Pts. JOB NO. _____

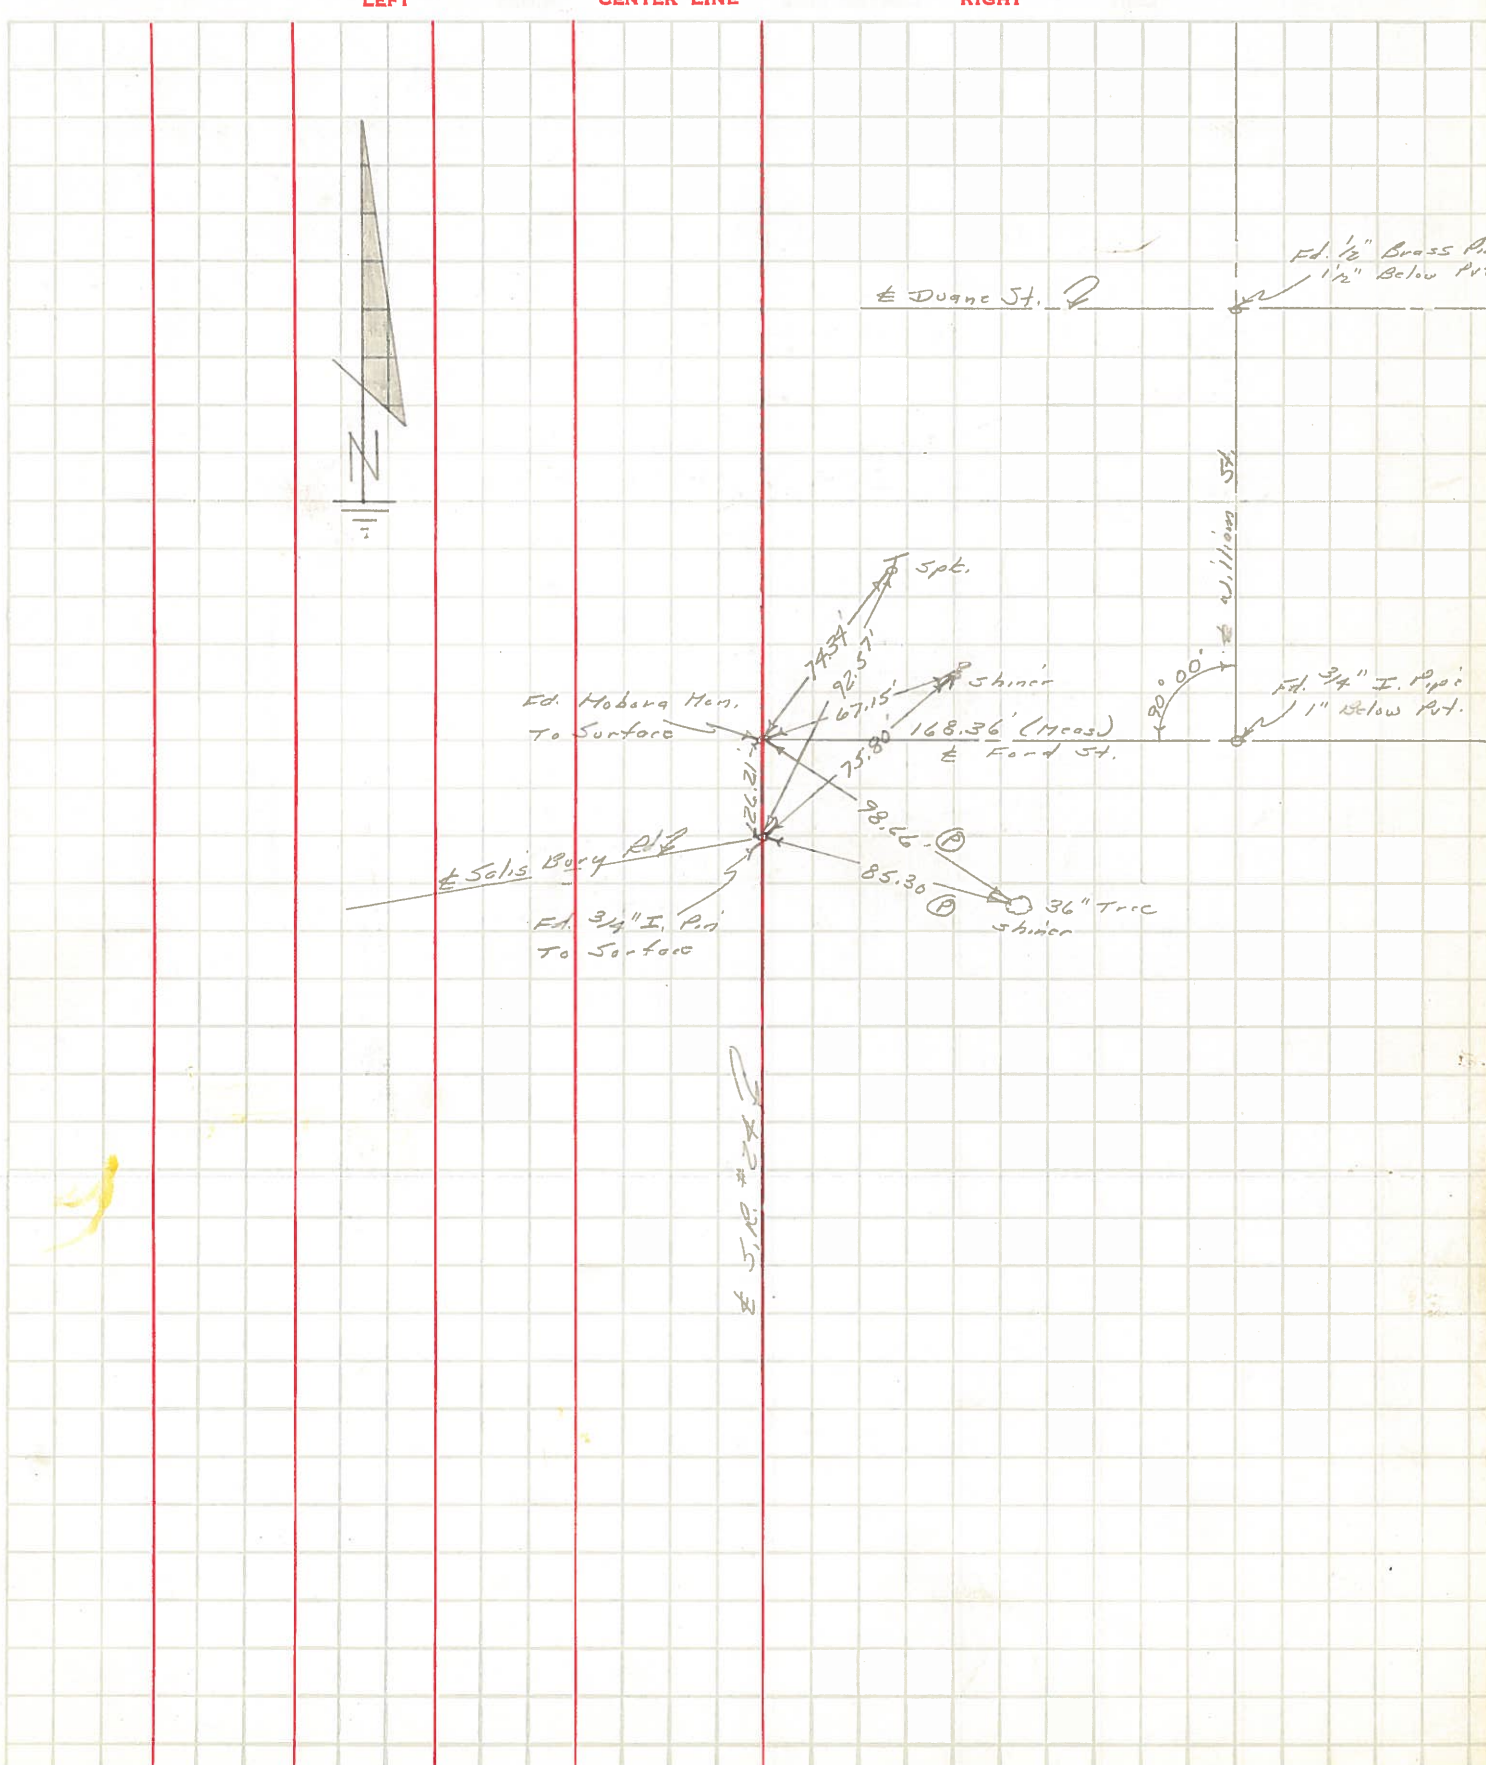

PERSONNEL	TITLE	PERSONNEL	TITLE	COUNTY	DATE
Mennitt				Lucas	9/19/51
Jackson				S. R. 24	WEATHER clear
				SEC.	TEMP. 68

DESCRIPTION Mon. Ref. JOB NO. _____

