


PERSONNEL	TITLE	PERSONNEL	TITLE	COUNTY	DATE
Merritt				Lucas	9-25-51
Jackson				S. R. Luc. 24	WEATHER
Gulyas				SEC.	TEMP.


DESCRIPTION Morr. Location JOB NO. _____

SET NEW MON

P.T. 43+61.83

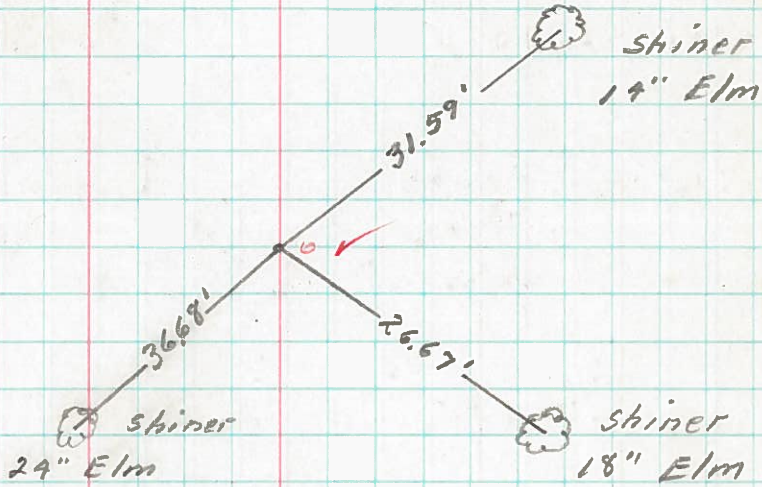




P.C. 41+28.91

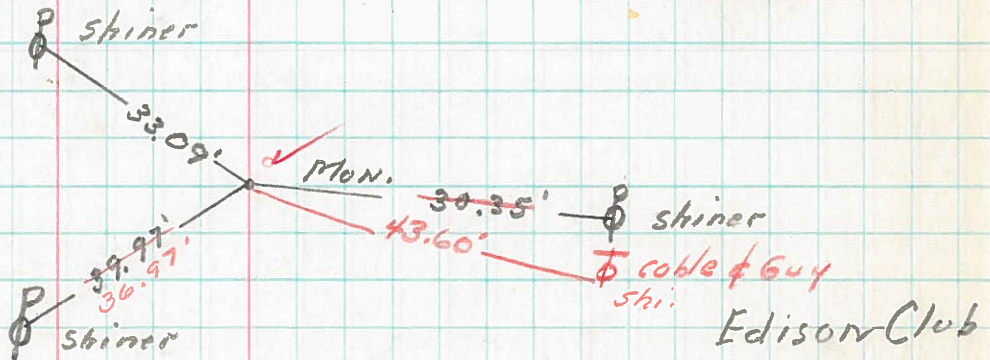

PERSONNEL	TITLE	PERSONNEL	TITLE	COUNTY	DATE	WEATHER	TEMP.
Merritt				Lucas	9/19/51		
Jackson				S. R. 24 (Maumee)			
				SEC.			

DESCRIPTION Mon. Ref. JOB NO. _____

LEFT CENTER LINE RIGHT

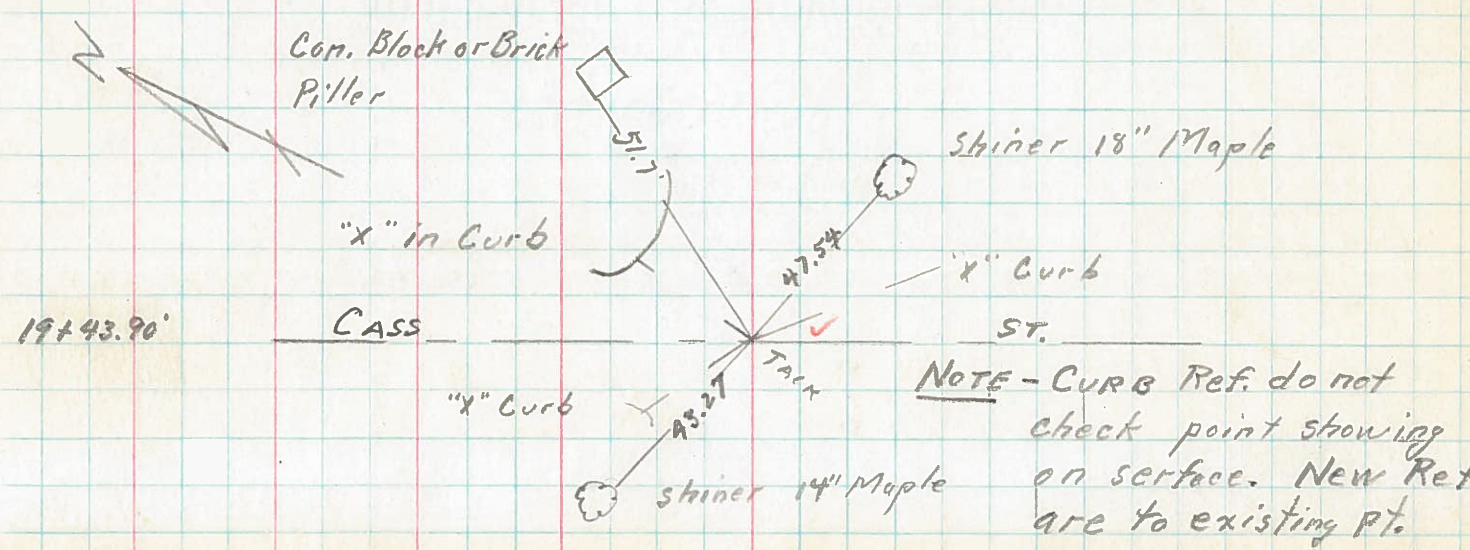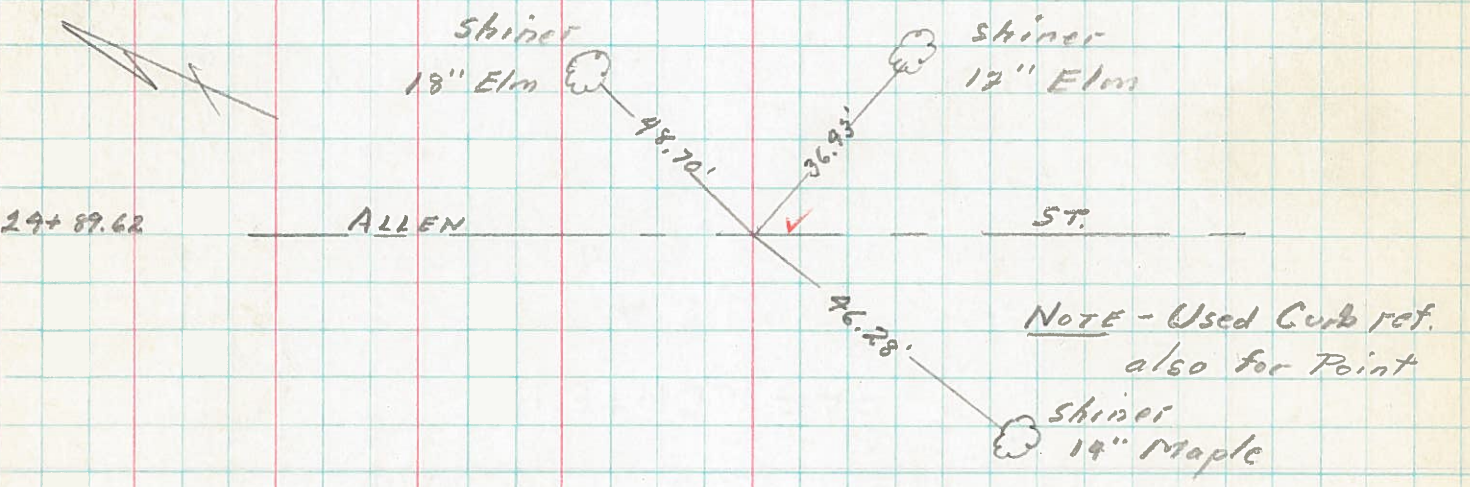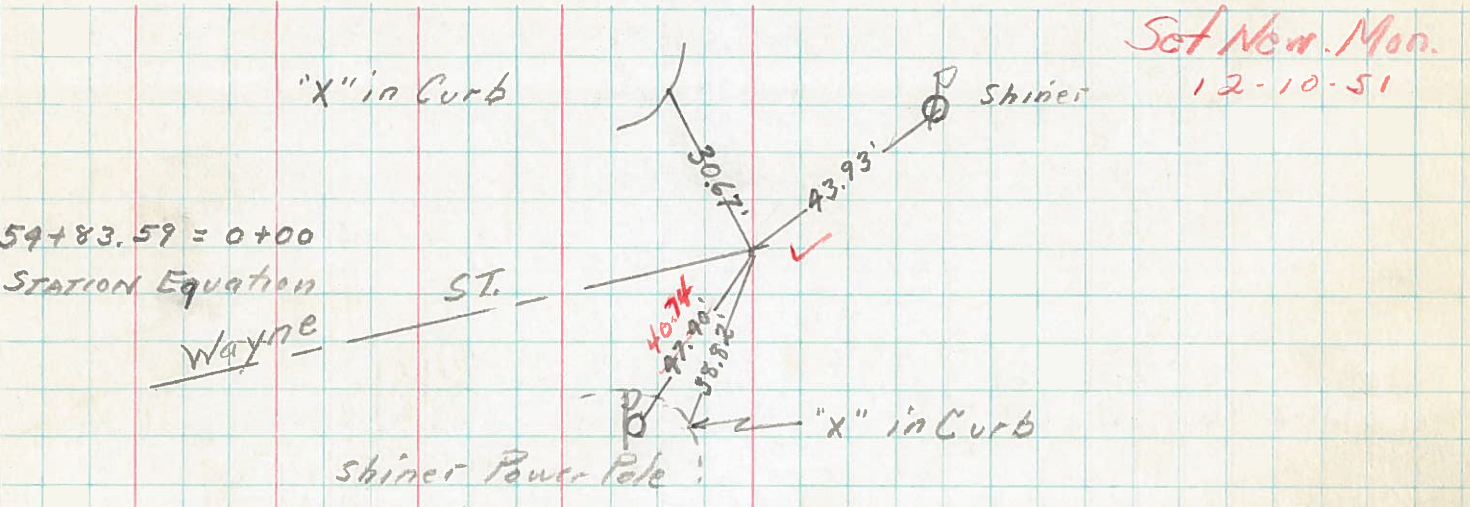

PERSONNEL	TITLE	PERSONNEL	TITLE	PERSONNEL	TITLE
Merritt					
Jackson					

COUNTY Lucas DATE 9/19/51

S. R. 29 (Mormer) WEATHER

SEC. TEMP.

DESCRIPTION Mon. Ref. JOB NO.

LEFT CENTER LINE RIGHT

