
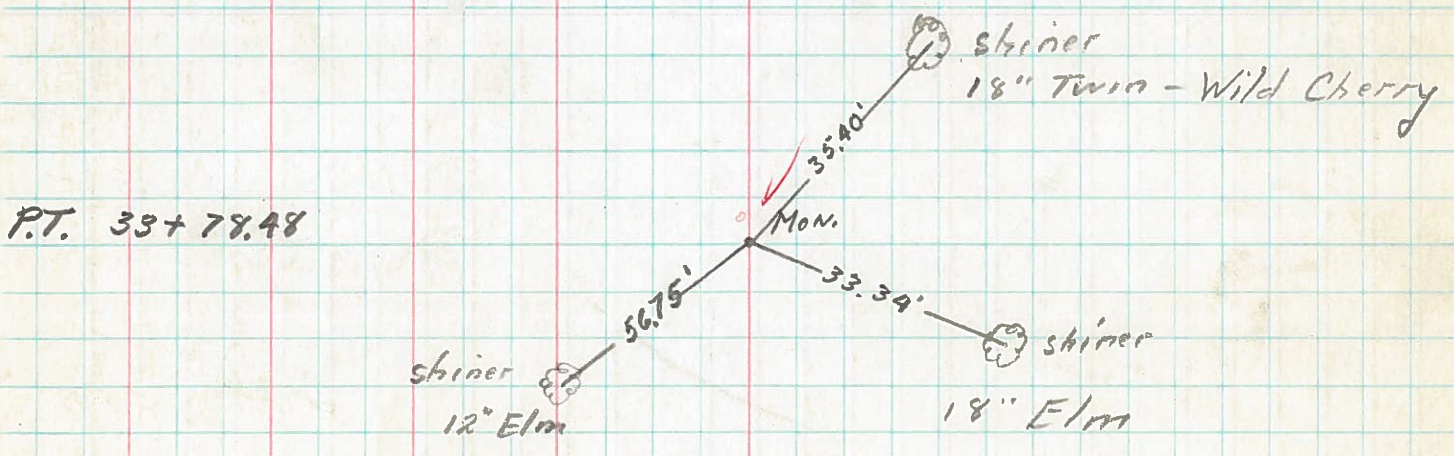



PERSONNEL	TITLE	PERSONNEL	TITLE	PERSONNEL	TITLE
Merritt				COUNTY	Lucas
Jackson				S. R.	Luc. 24
Gulyas				SEC.	
DESCRIPTION				DATE	9-25-51
Mon. Ref.				WEATHER	
				TEMP.	
JOB NO.					

Set New Mon
12-12-51

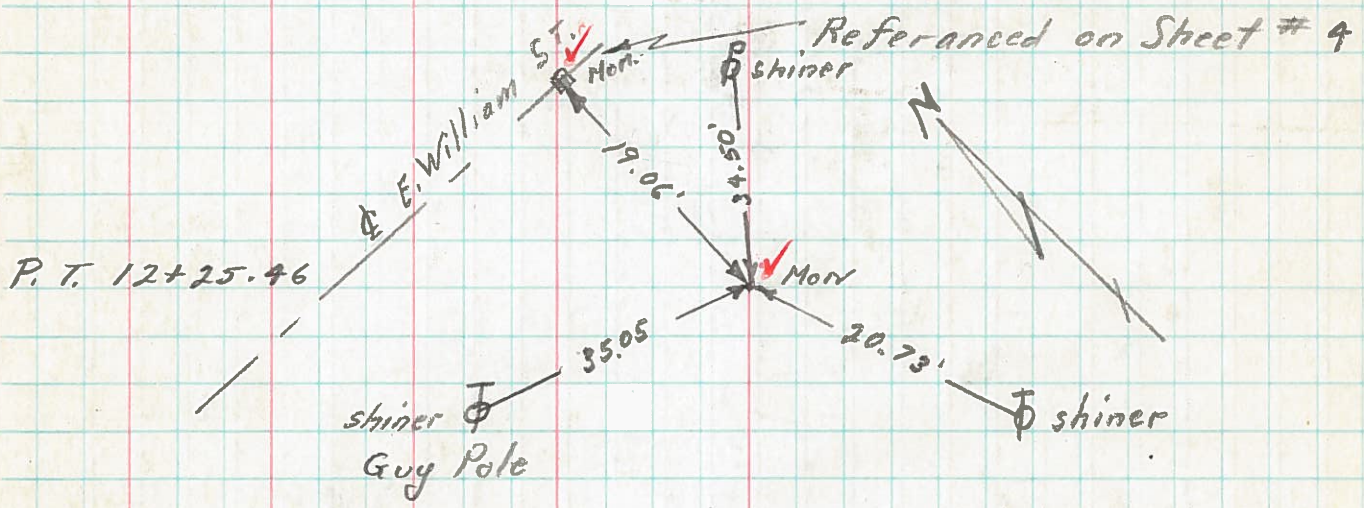

PERSONNEL	TITLE	PERSONNEL	TITLE	PERSONNEL	TITLE	PERSONNEL	TITLE
Mennitt				COUNTY	LUCAS	DATE	9/19/51
Jackson				S. R.	24 (Maumee)	WEATHER	
				SEC.		TEMP.	

DESCRIPTION Mon. Ref. JOB NO. _____

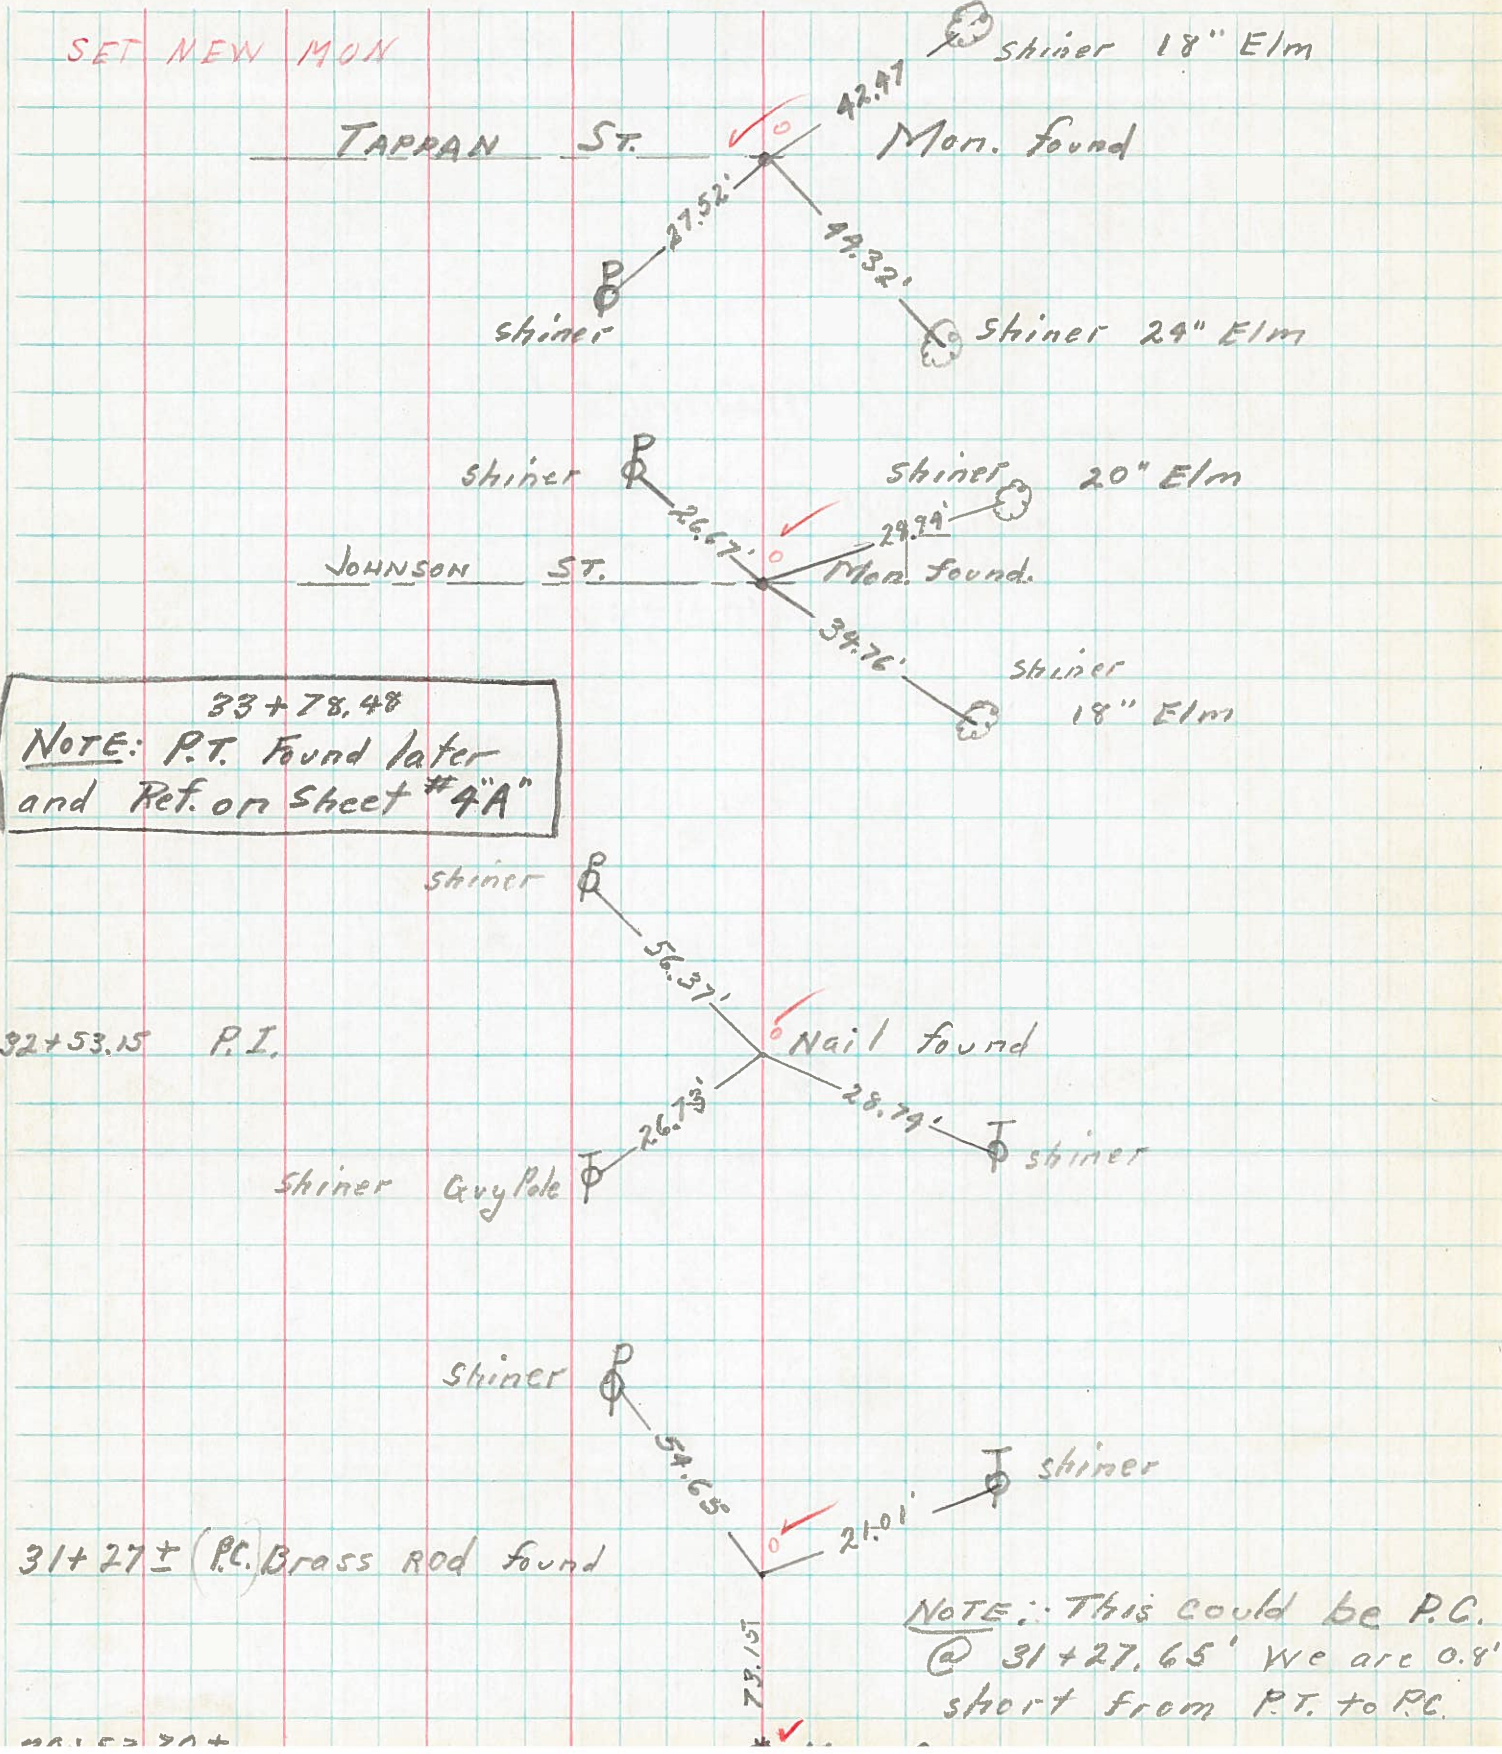

33+78.48
NOTE: P.T. Found later and Ref. on Sheet #4A

NOTE: This could be P.C. @ 31+27.65' We are 0.8' short from P.T. to P.C.

PERSONNEL TITLE PERSONNEL TITLE
 Mennitt _____
 Jackson _____

COUNTY Lucas DATE 9-19-51
 S. R. 24 (Mauvee) WEATHER _____
 SEC. _____ TEMP. _____

DESCRIPTION Mon Ref. JOB NO. _____
 LEFT CENTER LINE RIGHT

SET NEW MDN.

