

O.D.O.T. DISTRICT 2 SURVEY OFFICE (USE ONLY)

PERSONNEL _____

REFERENCE NO. 71

SHEET 1 OF 18

NOTES MENNIT

DATE 7/18/60

ROUTE US 24

H.C. _____

WEATHER CLEAR

COUNTY LUCAS

R.C. _____

TEMP. 83°

TOWNSHIP PRIVATE GRANT

DWG BY RHOADES

PID _____

SECTION 581

TYPE MONUMENT P.K.NAIL

ON SURFACE - ~~BELOW~~ ON

OFFSET Q PAVEMENT ON _____ LT : RT

TO _____ EDGE PAVEMENT



STATION: 985+77

HORIZ.DATUM: _____

GEOID: _____

GRID: NORTHING: _____

EASTING: _____

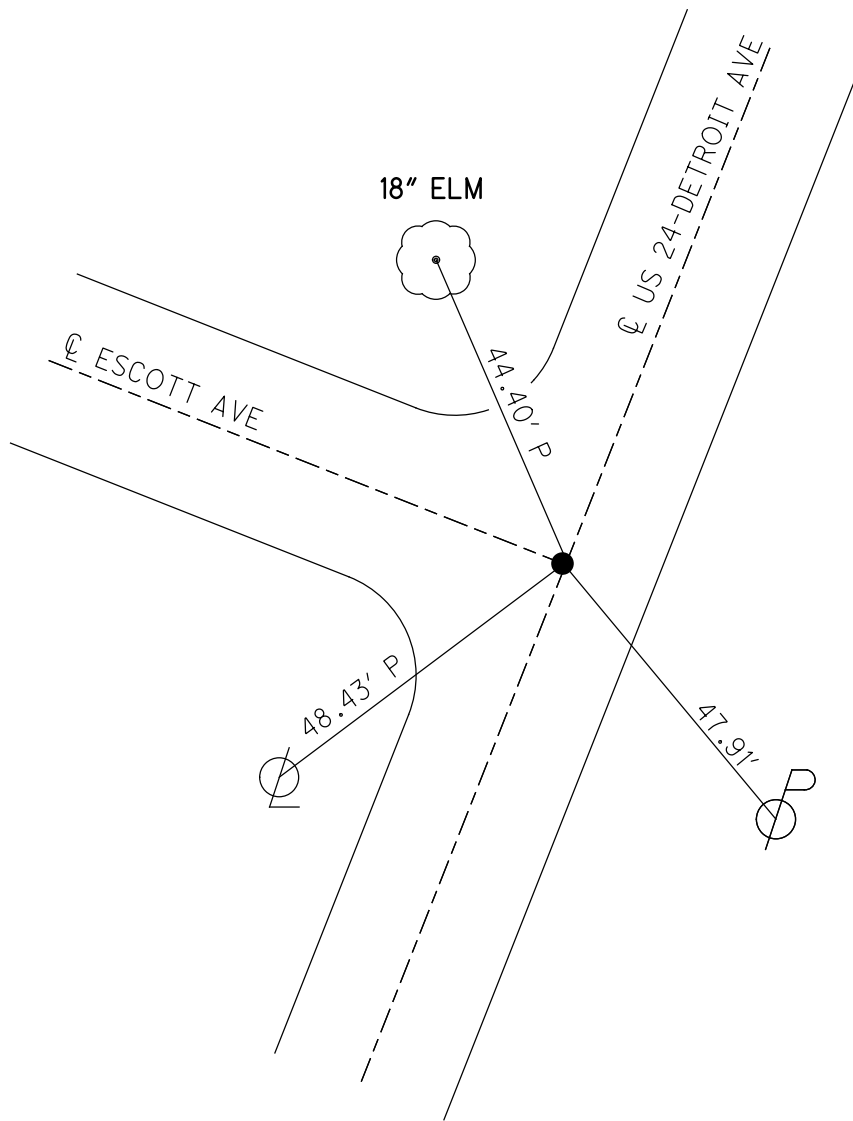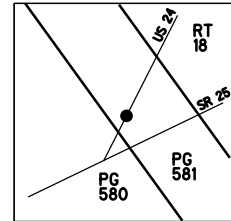

PERSONNEL	TITLE	PERSONNEL	TITLE	COUNTY	DATE
Mennitt				Lucas	7-18-60
				S. R. 10-25-24	WEATHER clear
				SEC. Bel. Bu. & A.D. (or Cont. Points @ side sts.)	TEMP. 83°
DESCRIPTION	MON. Ref.			JOB NO.	

