

O.D.O.T. DISTRICT 2 SURVEY OFFICE (USE ONLY)

PERSONNEL \_\_\_\_\_

REFERENCE NO. 74

SHEET 5 OF 18

NOTES MENNIT

DATE 7/18/60

ROUTE US 24

H.C. \_\_\_\_\_

WEATHER CLEAR

COUNTY LUCAS

R.C. \_\_\_\_\_

TEMP. 83°

TOWNSHIP PRIVATE GRANT

SECTION 581

DWG BY RHOADES

PID \_\_\_\_\_

TYPE MONUMENT P.K.NAIL

ON SURFACE - ~~BELOW~~ ON

OFFSET  $\text{C}$  PAVEMENT ON \_\_\_\_\_ LT : RT

- TO - EDGE PAVEMENT



STATION: 1000+03

HORZ.DATUM: \_\_\_\_\_

GEOID: \_\_\_\_\_

GRID: NORTHING: \_\_\_\_\_

EASTING: \_\_\_\_\_

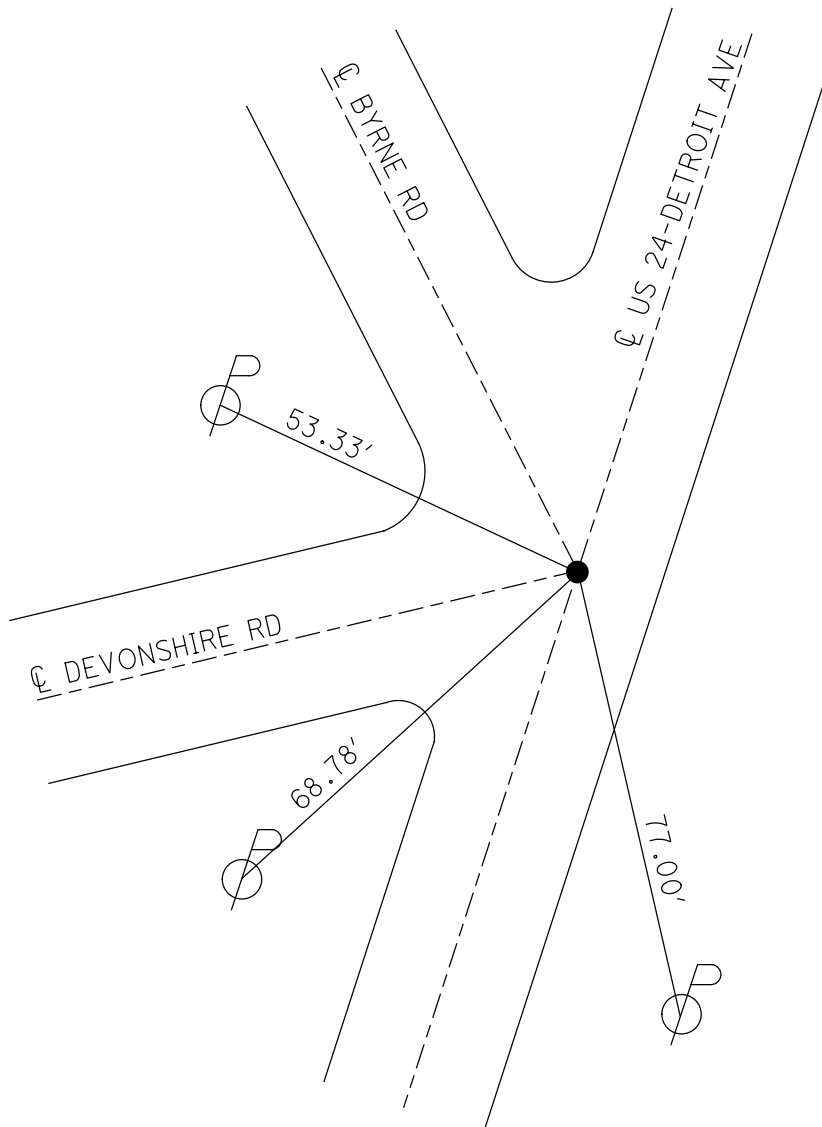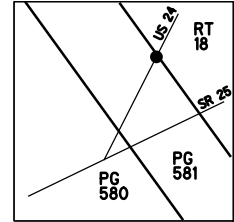

PERSONNEL TITLE PERSONNEL TITLE

Merritt

COUNTY Lucas

DATE

S. R. 25 24

WEATHER

SEC. Burne to A.W. Trail

TEMP.

DESCRIPTION Reference - Control Points on Detroit

JOB NO.


LEFT

CENTER LINE

RIGHT


6+92.78 P.T.

Right Curb  
3' off

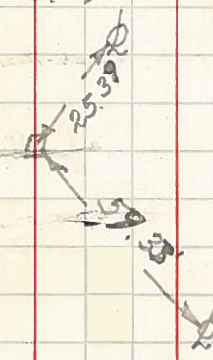



6+92.87 P.T. Left Curb

3' off

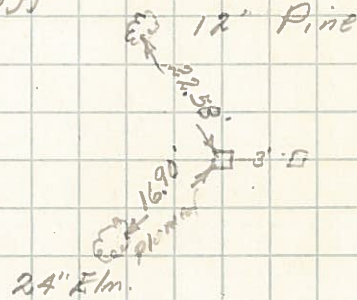


9+21.31 P.C. Right Curb

3' off.

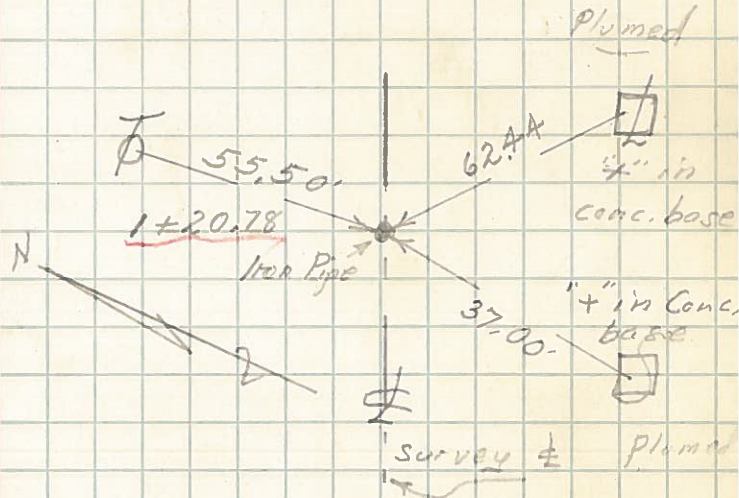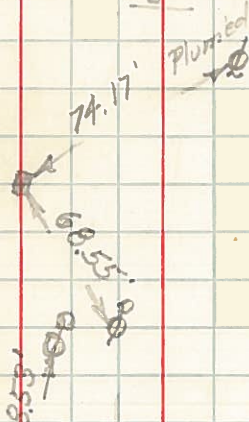


3' off -  
of P.T. 2+89.02  
24.89' RT.

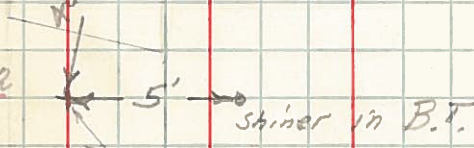

"+" in Conc. Drive.

18+00.10'

"Iron Pipe"  
in Conc.

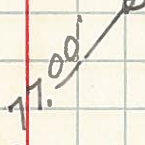


DETROIT

DEVONSHIRE

BYRNE

6+00

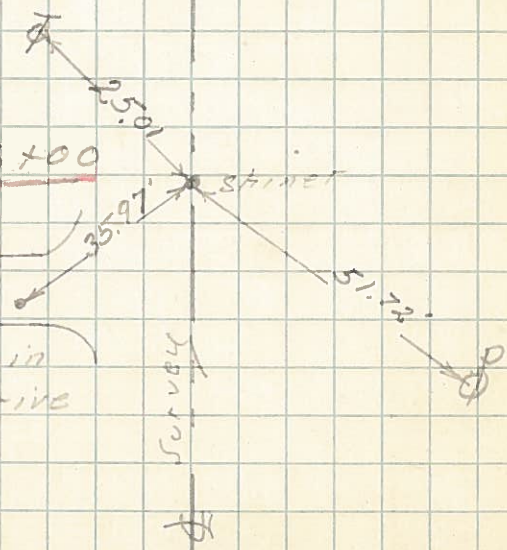

Shiner in  
B.T. Drive

Survey