

O.D.O.T. DISTRICT 2 SURVEY OFFICE (USE ONLY)

PERSONNEL

REFERENCE NO. 79 C

SHEET 17 OF 18

NOTES HOHENBERGER

DATE 10/31/77

ROUTE US 24

H.C. WILLIAMS

WEATHER \_\_\_\_\_

COUNTY LUCAS

R.C. GERDZINSKI

TEMP. \_\_\_\_\_

TOWNSHIP USR

DWG BY RHOADES

PID \_\_\_\_\_

SECTION 26

T 9 N R 7 E

TYPE MONUMENT MONBOX

ON SURFACE - ~~BELOW~~ ON \_\_\_\_\_

OFFSET  $\text{\textcircled{C}}$  PAVEMENT ON \_\_\_\_\_ LT : RT

\_\_\_\_\_ TO \_\_\_\_\_ EDGE PAVEMENT



STATION: 1353+26

HORZ.DATUM: \_\_\_\_\_

GEOID: \_\_\_\_\_

GRID: NORTHING: \_\_\_\_\_

EASTING: \_\_\_\_\_

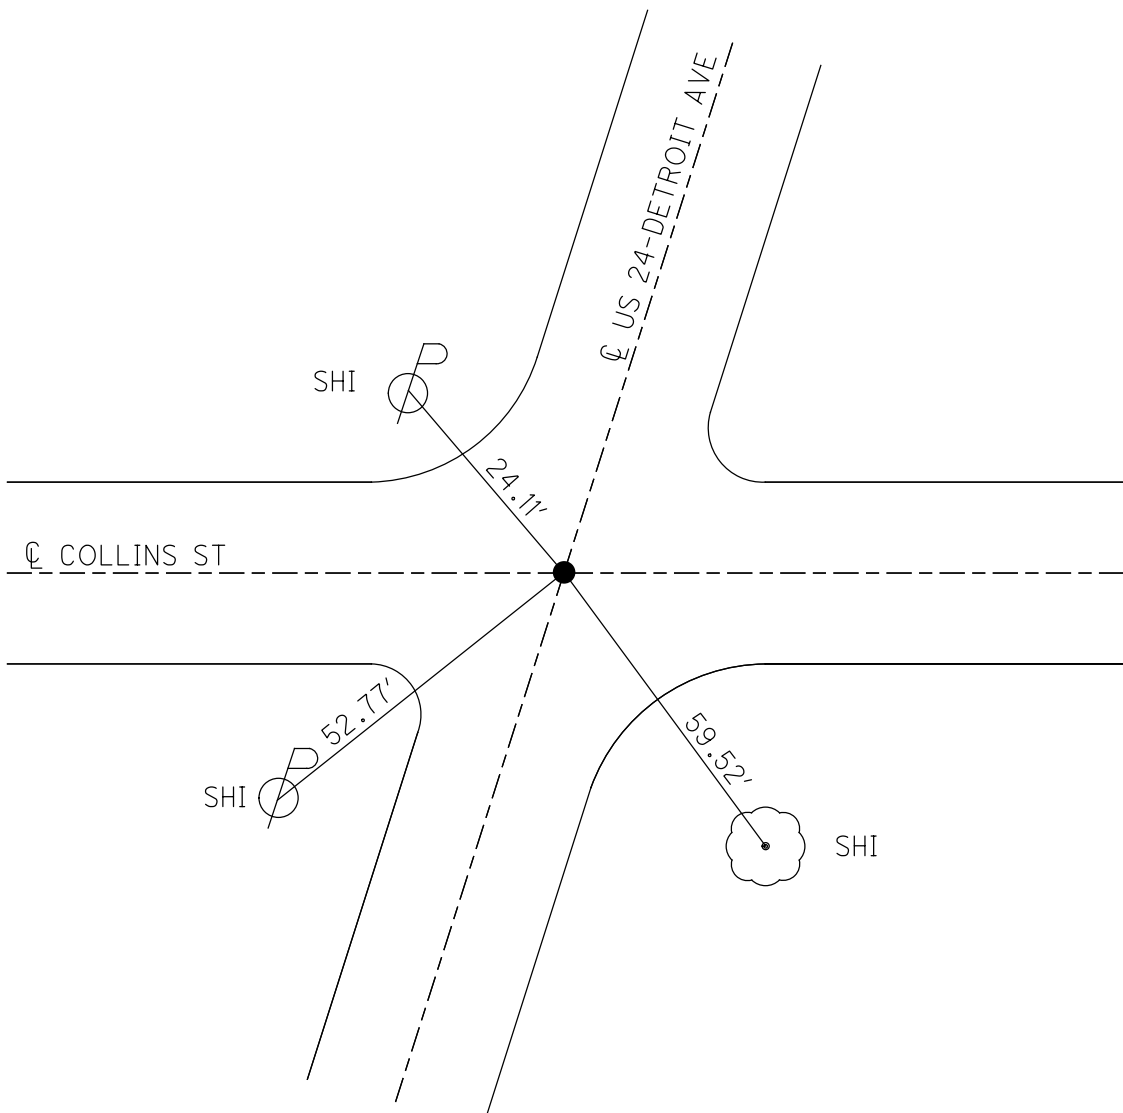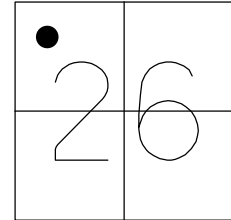

PERSONNEL TITLE PERSONNEL TITLE

PROJECT \_\_\_\_\_ DATE \_\_\_\_\_

PROJECT LIMITS \_\_\_\_\_ WEATHER \_\_\_\_\_

FROM STA. \_\_\_\_\_ TO STA. \_\_\_\_\_ TEMP. ② \_\_\_\_\_

DESCRIPTION MON. REF. DETROIT AVE RESURF. (LAWSON TO CENTRAL)

