

O.D.O.T. DISTRICT 2 SURVEY OFFICE

PERSONNEL _____

REFERENCE NO. 81

SHEET 2 OF 6

NOTES CITY

3-31-94

H.C. OF

DATE 1-15-92

ROUTE 24

R.C. TOLEDO

WEATHER RAID

COUNTY LUCAS

TEMP. +40

TOWNSHIP _____

SECTION _____

T _____ R _____


TYPE MONUMENT Man

ON SURFACE - BELOW

LEFT - C PAV'T. - RIGHT 2.4

TO _____ EDGE PAVEMENT

S.L.M. 1417+07.85 + 1417+09.45 / SLM-26.84

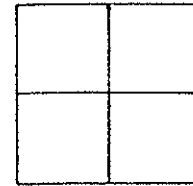

TOLEDO PLAN Luc-24-26.70


PLAN STA. 7+31.85 + 7+33.45

19.2 to RT EP

23.0 to RT EP

7+31.85

Between
Not Measured

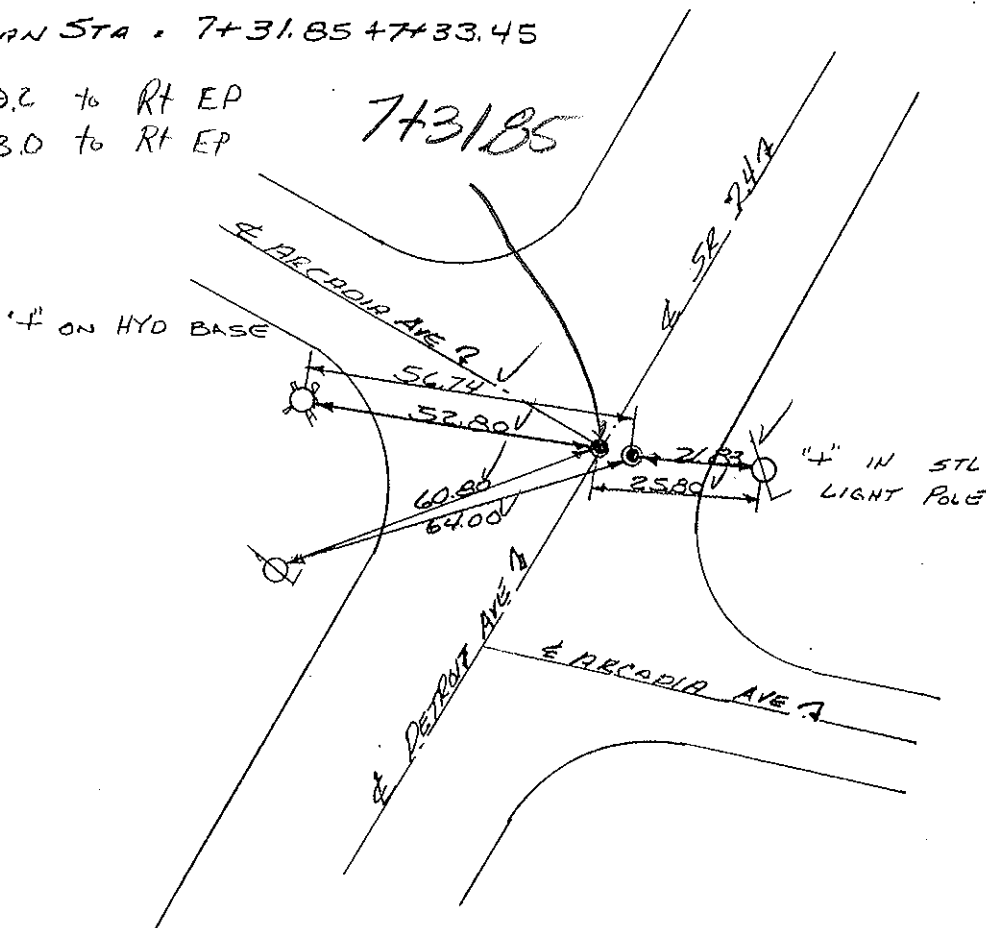

L-6-97
Set 5/8" Iron
Rods in BOTH
MONUMENT BOXES
M.R.C.

O.D.O.T. DISTRICT 2 SURVEY OFFICE

PERSONNEL _____

REFERENCE NO. 81

SHEET 2 OF 6

NOTES CITY

H.C. OF

R.C. TOLEDO

DATE 1-15-92

WEATHER _____

TEMP. _____

ROUTE 24

COUNTY LUCAS

TOWNSHIP _____

SECTION _____

T _____ R _____


TYPE MONUMENT Mon

ON SURFACE - BELOW _____

LEFT - & PAV'T. - RIGHT _____

TO _____ EDGE PAVEMENT

S.L.M. 1417+07.85 + 1417+09.45

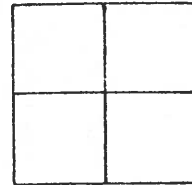

TOLEDO PLAN Luc-24-26.70

PLAN STA = 7+31.85 + 7+33.45

