

O.D.O.T. DISTRICT 2 SURVEY OFFICE

PERSONNEL _____ REFERENCE NO. 82 SHEET 3 OF 6

NOTES CITY

H.C. OF DATE 1-15-92 ROUTE 24

R.C. TOLEDO WEATHER _____ COUNTY LUCAS

TOWNSHIP _____

SECTION _____

T _____ R _____


TYPE MONUMENT Mon

ON SURFACE - ~~BELOW~~ C SURFACE

LEFT - C PAV'T. - RIGHT 2,8

23.1 TO RT EDGE PAVEMENT

S.L.M. 1418+17.03 / SLM 26.86

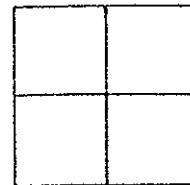


TOLEDO PLAN LUC-SP-24-26.70

PLAN STA: 8+41.03

DRAWN BY Wm LUCE

1-6-97
 Set 5/8" Iron Rod
 IN MONUMENT BOX
 M.R.C.

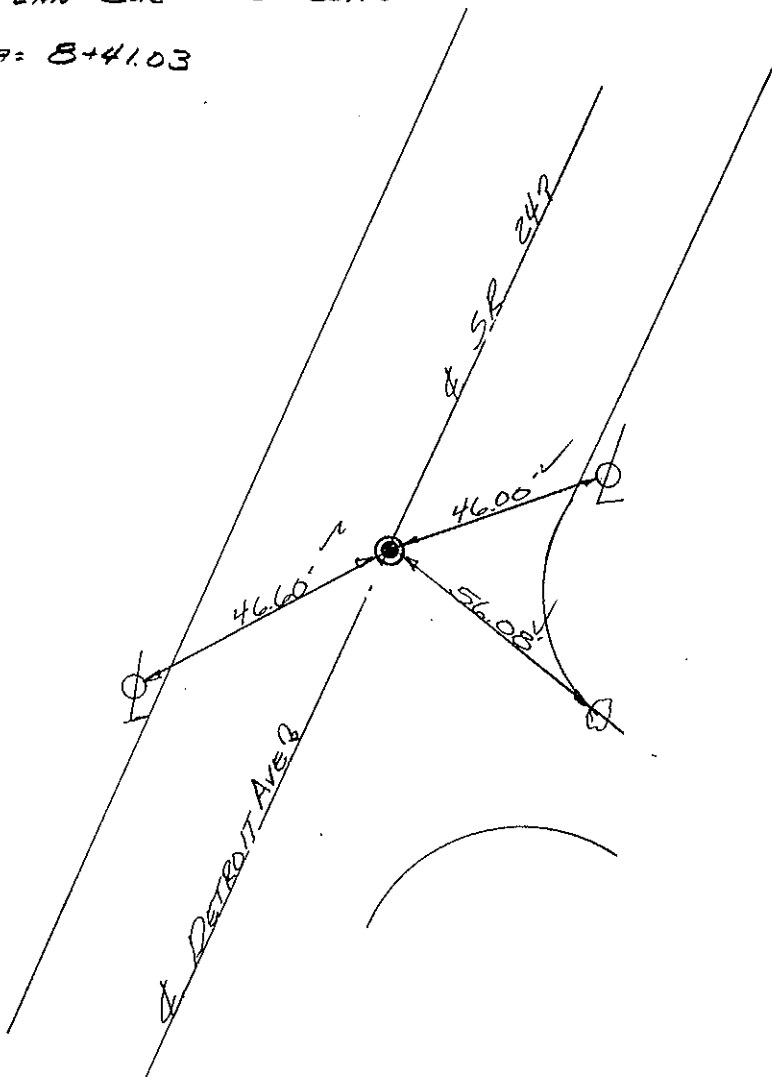

O.D.O.T. DISTRICT 2 SURVEY OFFICE

PERSONNEL

REFERENCE NO. 82

SHEET 3 OF 6

NOTES CITY

H.C. OF

R.C. TOLEDO

DATE 1-15-92

WEATHER _____

TEMP. _____

ROUTE 24

COUNTY LUCAS

TOWNSHIP _____

SECTION _____

T _____ R _____


TYPE MONUMENT MON

ON SURFACE - BELOW C SURFACE

LEFT- & PAV'T. - RIGHT _____

_____ TO _____ EDGE PAVEMENT

S.L.M. 1418+17.03

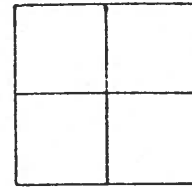

TOLEDO PLAN LUC-SR-24-26.70

DRAWN BY Wm LUCE

PLAN STA: 8+41.03

