

O.D.O.T. DISTRICT 2 SURVEY OFFICE

PERSONNEL _____ REFERENCE NO. 83 SHEET 4 OF 6

NOTES CITY

H.C. OF DATE 4-5-92 ROUTE SR-24

R.C. TOLEDO WEATHER _____ COUNTY LUCAS

TOWNSHIP _____

SECTION _____

T. _____ R. _____


TYPE MONUMENT Mon

ON SURFACE - BELOW @ SURFACE

LEFT - @ PAV'T. - RIGHT 2.6

23.0 TO RT EDGE PAVEMENT

S.L.M. 1426+08.40 1426+43.34 SLM/27.00

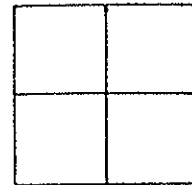


TOLEDO PLAN LUC-SR-24-2670

PLAN STA = 16+32.48

16+67.34

1.6-97
Set 5/8" Iron Rod
in BOTH monument
boxes, M.R.S.

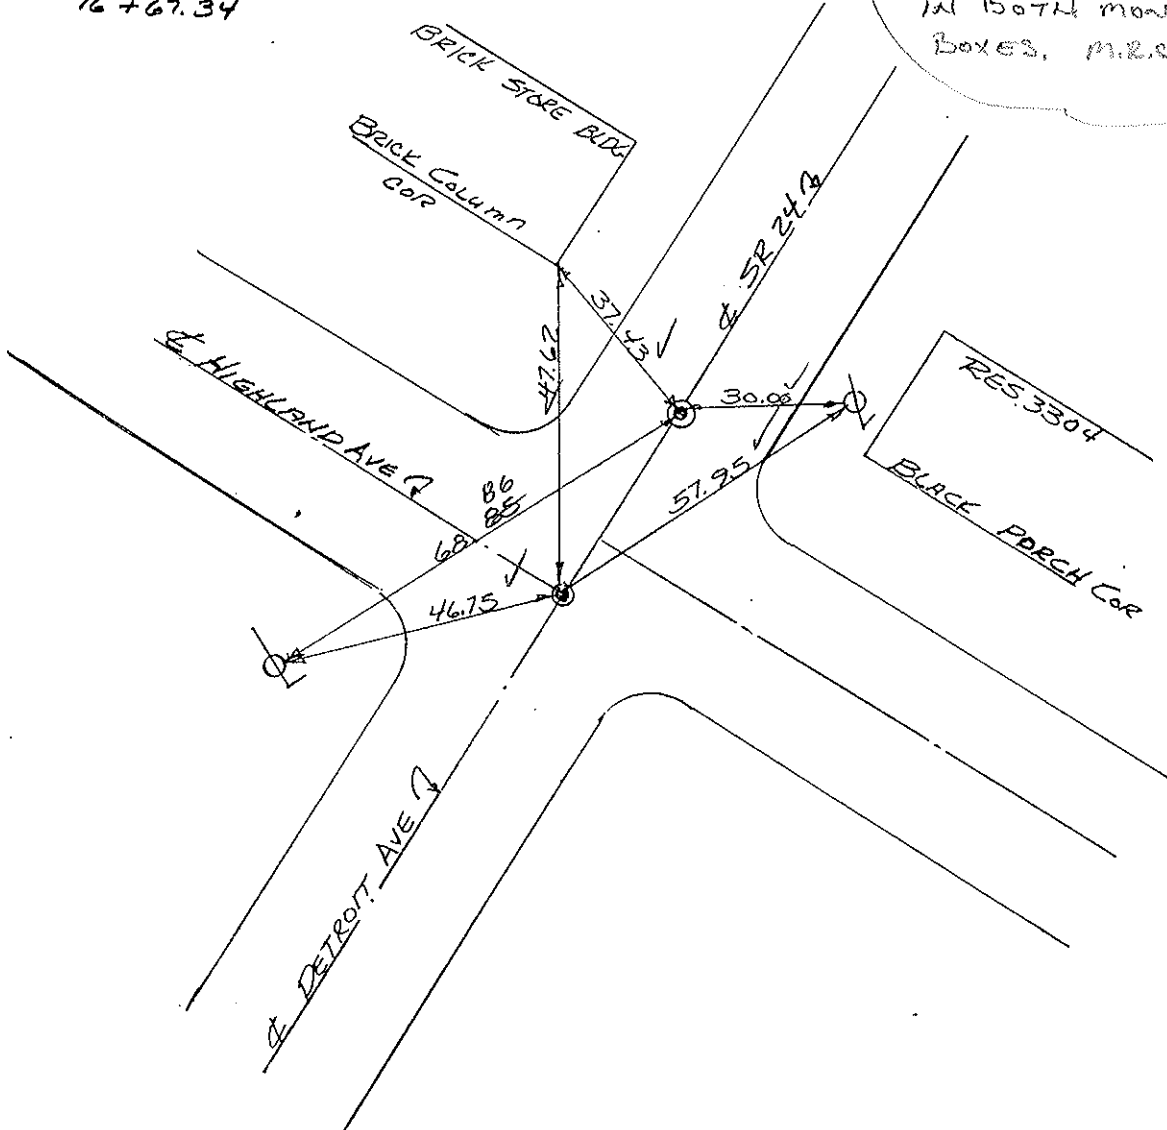

O.D.O.T. DISTRICT 2 SURVEY OFFICE

PERSONNEL _____

REFERENCE NO. 83

SHEET 4 OF 6

NOTES CITY

H.C. OF

R.C. TOLEDO

DATE 4-5-92

WEATHER _____

TEMP. _____

ROUTE SR-24

COUNTY LUCAS

TOWNSHIP _____

SECTION _____

T _____ R _____


TYPE MONUMENT Mon

ON SURFACE - BELOW @ SURFACE

LEFT - & PAV'T. - RIGHT _____

_____ TO _____ EDGE PAVEMENT

S.L.M. 1426+08.40 1426+43.34

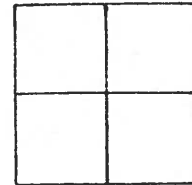

TOLEDO PLAN Luc-SR-24-2670

PLAN STA = 16+32.48
16+67.34

