

PERSONNEL TITLE PERSONNEL TITLE

COUNTY Lucas

DATE \_\_\_\_\_

S. R. \_\_\_\_\_

U.S. 24

WEATHER \_\_\_\_\_

SEC. \_\_\_\_\_

TEMP. \_\_\_\_\_

DESCRIPTION


LEFT

CENTER LINE


RIGHT

JOB NO. \_\_\_\_\_


"A" Mich. line

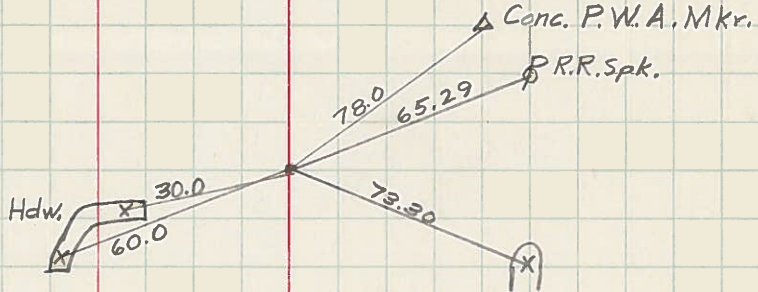

"B" 1/4 Cor. 1 & 2  
200 S. of "A"

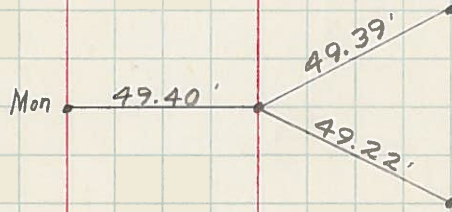

Syl. Alexis

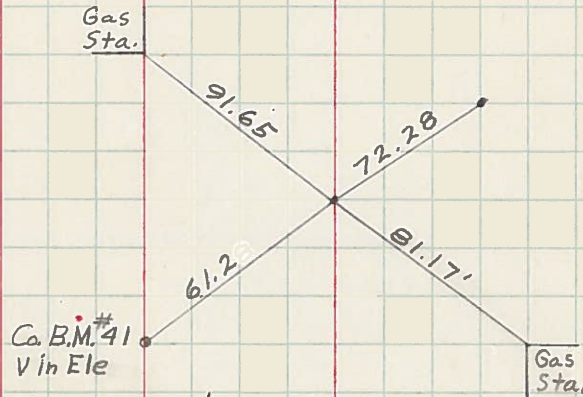

Northgate Pkwy

