



PERSONNEL	TITLE	PERSONNEL	TITLE	PROJECT	DATE
HORNBERGER	DT				10/31/22
WILLIAMS	A			PROJECT LIMITS	WEATHER
GREENBERG	T			FROM STA.	TO STA.
					TEMP

DESCRIPTION DETROIT AVE. RESURFACING (BROADWAY TO DORR) REFERENCE LINES

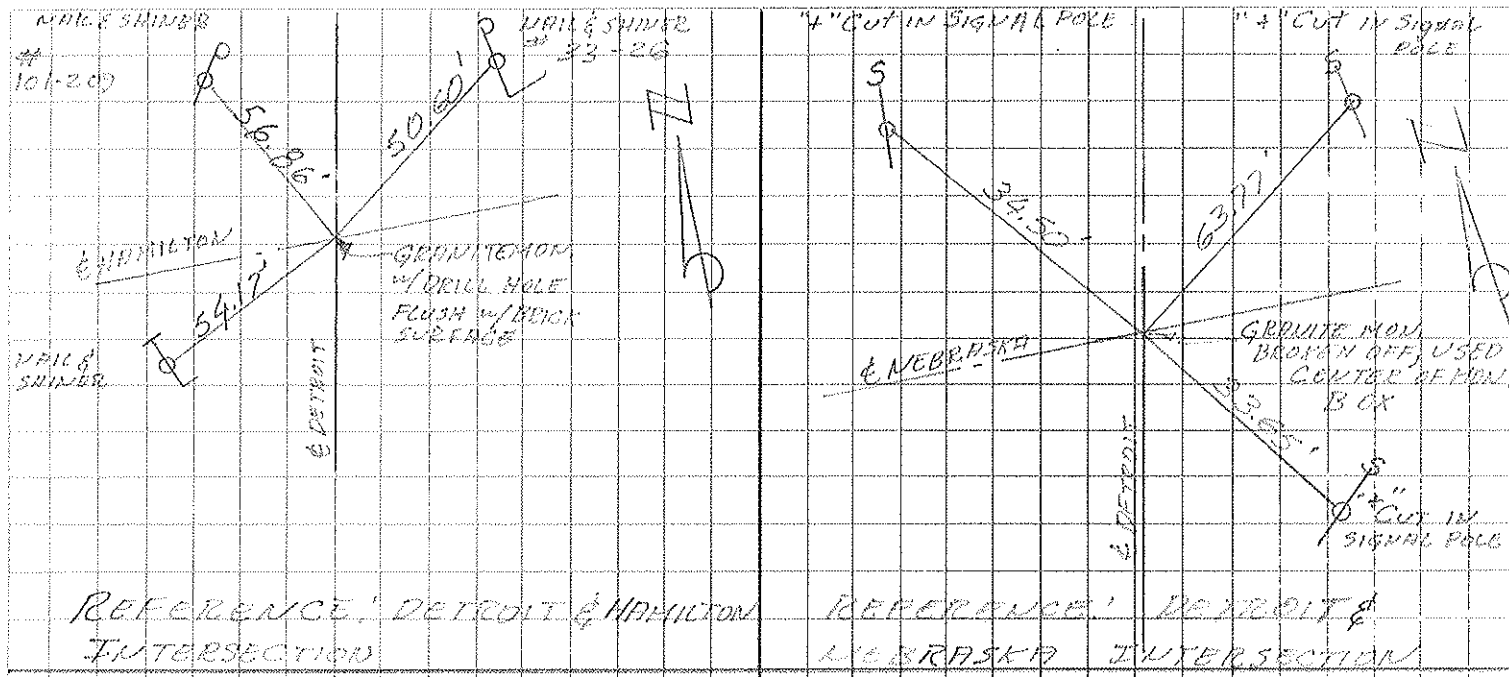


REFERENCE: DETROIT & HAMILTON INTERSECTION

REFERENCE: DETROIT & NEBRASKA INTERSECTION

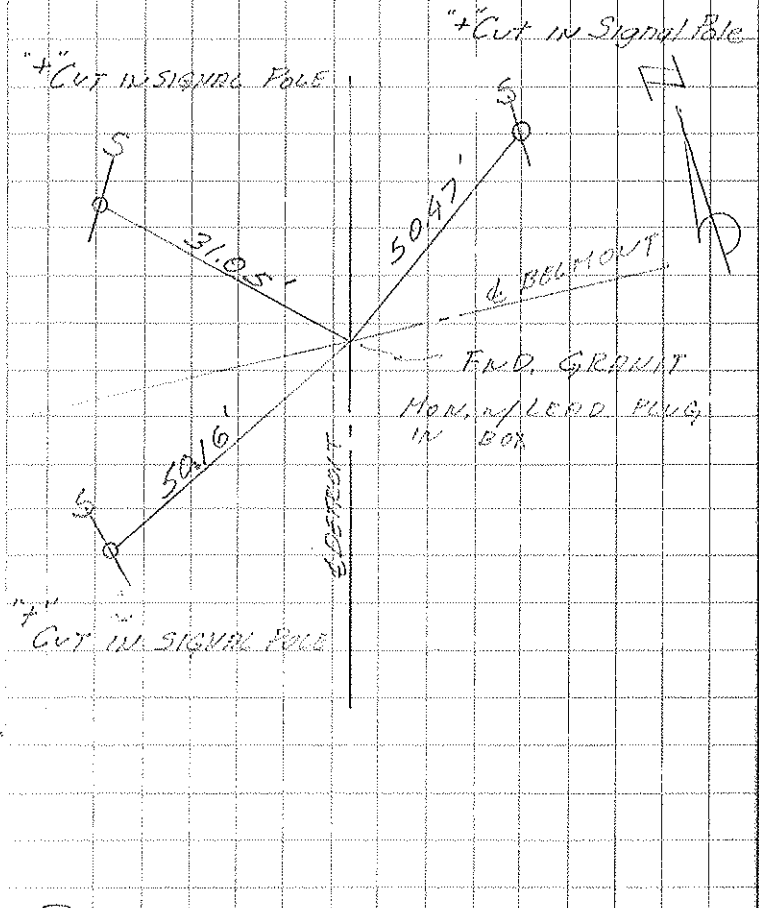

REFERENCE: INTERSECTION OF DETROIT & BELMONT

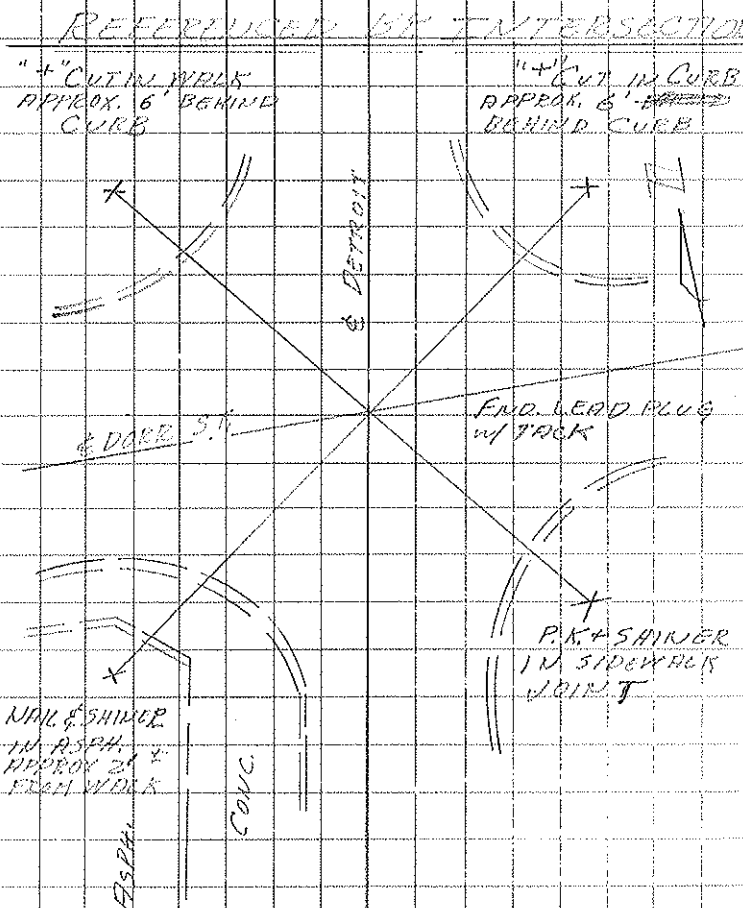

REFERENCE: INTERSECTION OF DETROIT & DORR


PERSONNEL TITLE PERSONNEL TITLE

PROJECT _____ DATE _____

PROJECT LIMITS _____ WEATHER _____

FROM STA. _____ TO STA. _____ TEMP $\text{\textcircled{2}}$

DESCRIPTION MON. REF. DETROIT AVE RESURF. (LAWSON TO CENTRAL)

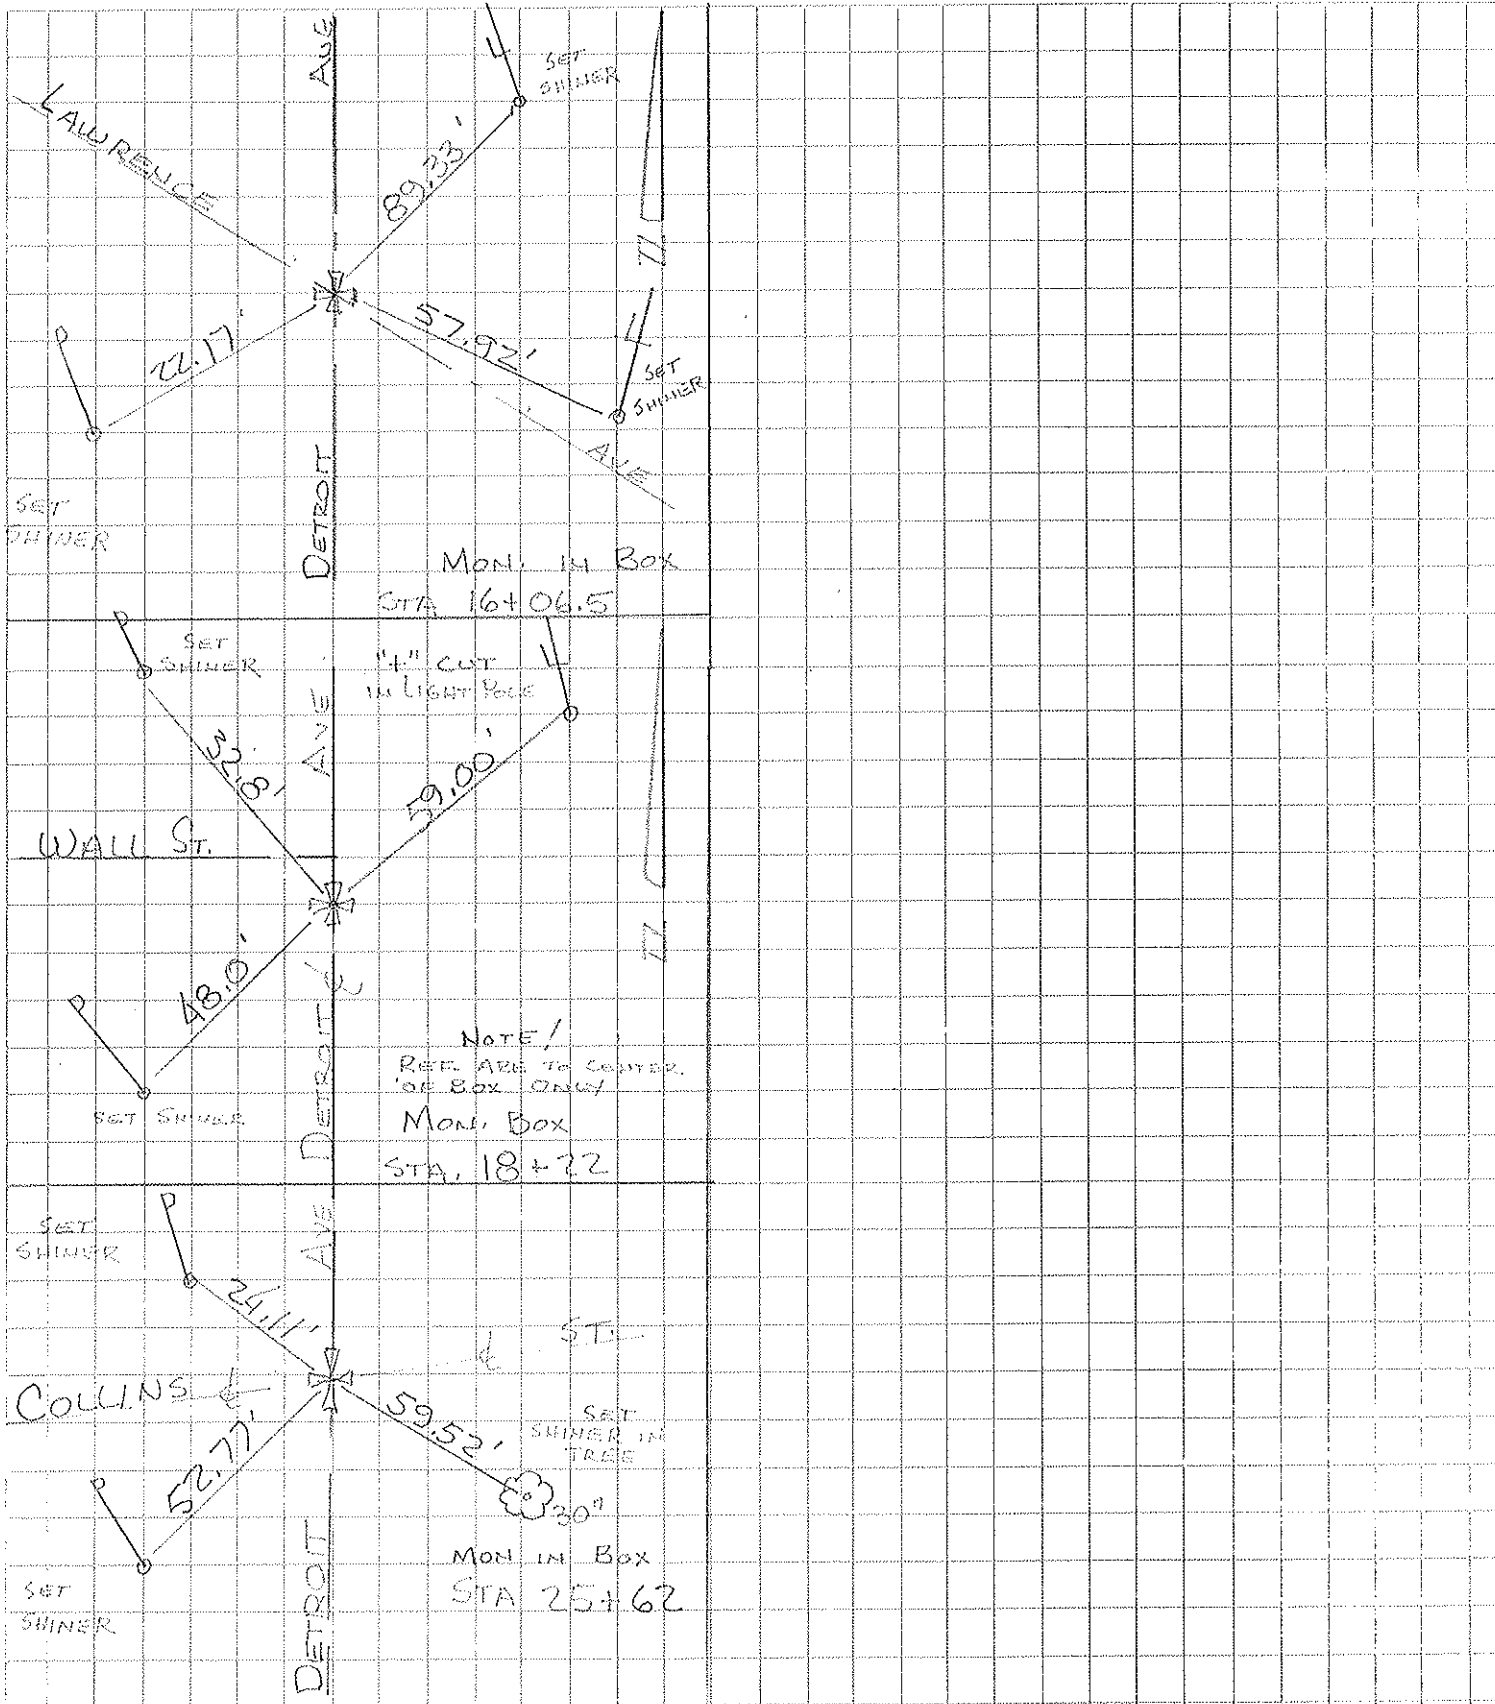

PERSONNEL TITLE PERSONNEL TITLE

PROJECT _____ DATE _____

PROJECT LIMITS _____ WEATHER _____

FROM STA. _____ TO STA. _____ TEMP _____

DESCRIPTION REF. MON. DETROIT AVE RESUME, CAMRON TO CENTRAL

