



PERSONNEL	TITLE	PERSONNEL	TITLE	PROJECT	DATE
HORNBERGER	DT				10/31/22
WILLIAMS	A			PROJECT LIMITS	WEATHER
GREENBERG	T			FROM STA.	TO STA.
					TEMP


DESCRIPTION DETROIT AVE. RESURFACING (BROADWAY TO DORR) REFERENCE LINES

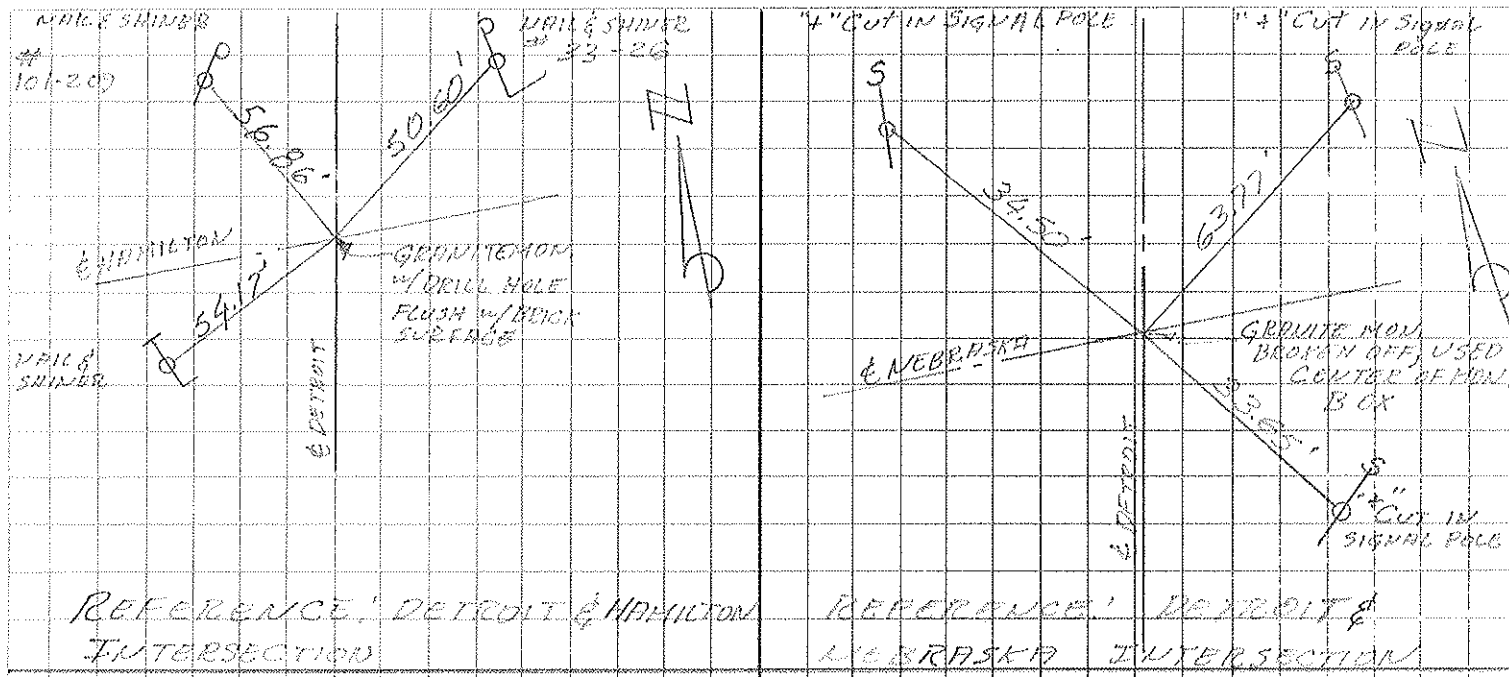


REFERENCE: DETROIT & HAMILTON INTERSECTION

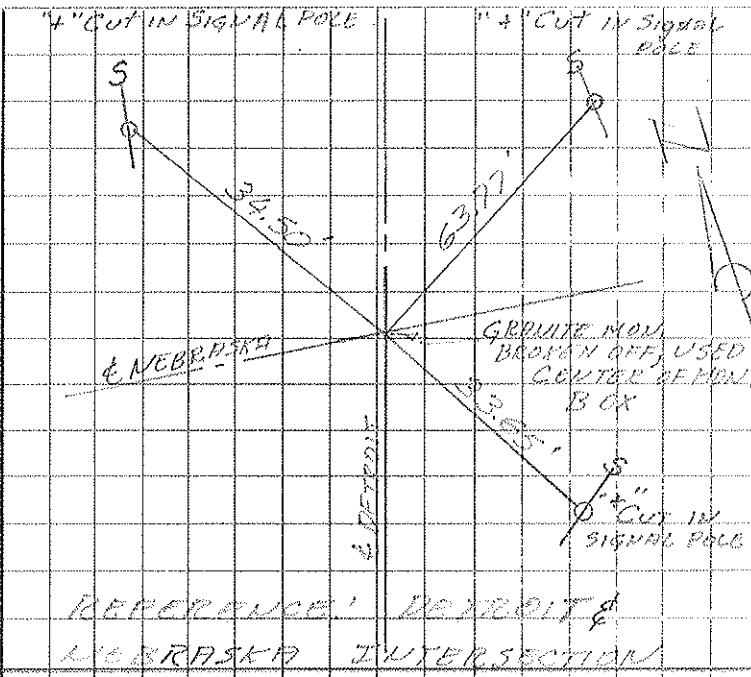

REFERENCE: DETROIT & NEBRASKA INTERSECTION

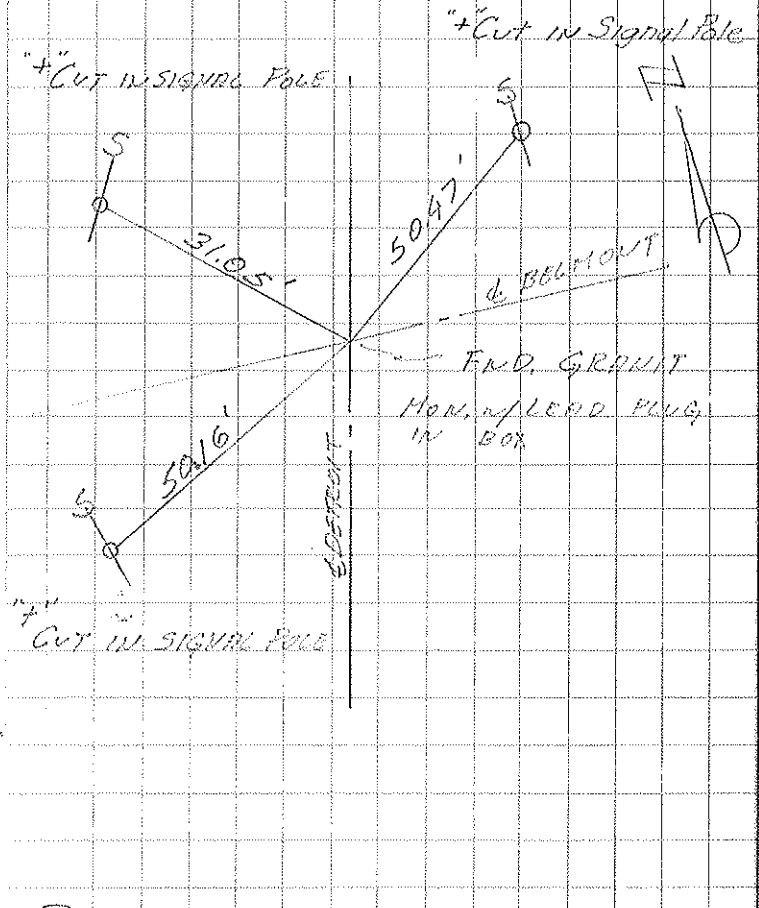

REFERENCE: INTERSECTION OF DETROIT & BELMONT

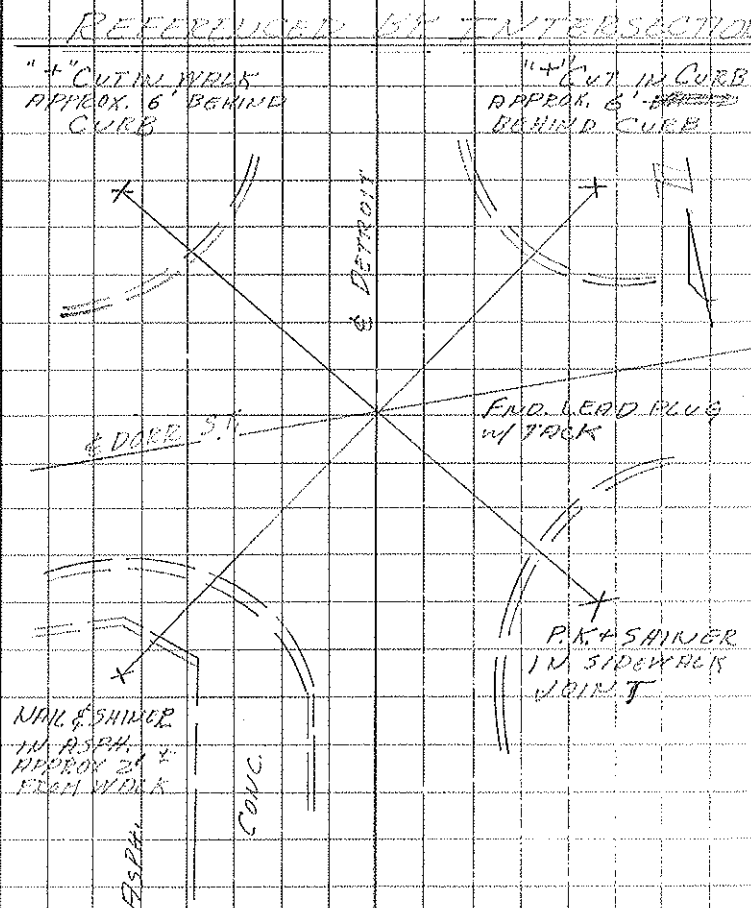

REFERENCE: INTERSECTION OF DETROIT & DORR