

Notes to: B. Rosebrook 1/5/95

Crew

PRIORITY NO. _____ PART 2 OF 2 SHEET 1 OF 12
 COUNTY Lucas ROUTE 51 SECTION 1.12
 BEGIN LOG (SLM) 1.12 ⁵⁹⁺¹⁴ TERMINII Toledo/Oregon Corp Line
 END LOG (SLM) 1.95 ^{CALC 102+96} _{meas. 102+42} TERMINII SR 2
 TOTAL LENGTH 0.83 MILES
 MUNICIPALITY Toledo BEGIN LOG (SLM) 1.12 END LOG (SLM) 1.95
 MUNICIPALITY _____ BEGIN LOG (SLM) _____ END LOG (SLM) _____

PROPOSED WORK: Grind entire pavement to concrete, repair bad part. joint, resurface
 PAVEMENT 1 3/4" 402 - 1 1/4" 404 SHOULDER curb
 OTHER rigid removal & rigid replacement of bad part. joints

STATION ESTABLISHED FROM: Fd City's Mon @ Line ±25' West of G TRACKS
Called Mon 59+14 (1.12 slm) measure to N.W. from there.
PAINTED ON S. SIDEWALK

STRUCTURES: NONE

NUMBER	STATION	WIDTH	LENGTH	PROPOSED WORK

RAILROAD CROSSING:

NAME CSX? CONRAIL? STATION 72+90 VERY POOR COND. (NO WORK)
 NO. TRACKS 2 LENGTH ALONG C L 35 FT
 NAME _____ STATION _____ NO. TRACKS _____ LENGTH ALONG C L _____ FT

MISCELLANEOUS:

NO RAISED PAVEMENT MARKERS; EDGE OF PAVEMENT N/A CENTERLINE _____
 NO. MAILBOX APPROACHES N/A MAILBOX SUPPORTS N/A

REMARKS: scuff existing concrete part. 1/4" min., use rubberized tack,
use polymer modified 402 & 404.


DATE _____
SHEET 2 OF 12

L - PROP PAVT DEPTH (IN) X 10; W - WIDTH @ MOUTH; W-I - WIDTH @ THROAT

[illegible]


PERSONNEL	TITLE	PERSONNEL	TITLE	COUNTY	DATE
LOEHRKE				LUCAS	12-30-94
E				S. R. 51	WEATHER FAIR
CREW				SEC. 1.12	TEMP. +36

DESCRIPTION		JOB NO.
<i>PAVT MARKINGS.</i>		
<i>LEFT</i>	<i>CENTER LINE</i>	<i>RIGHT</i>

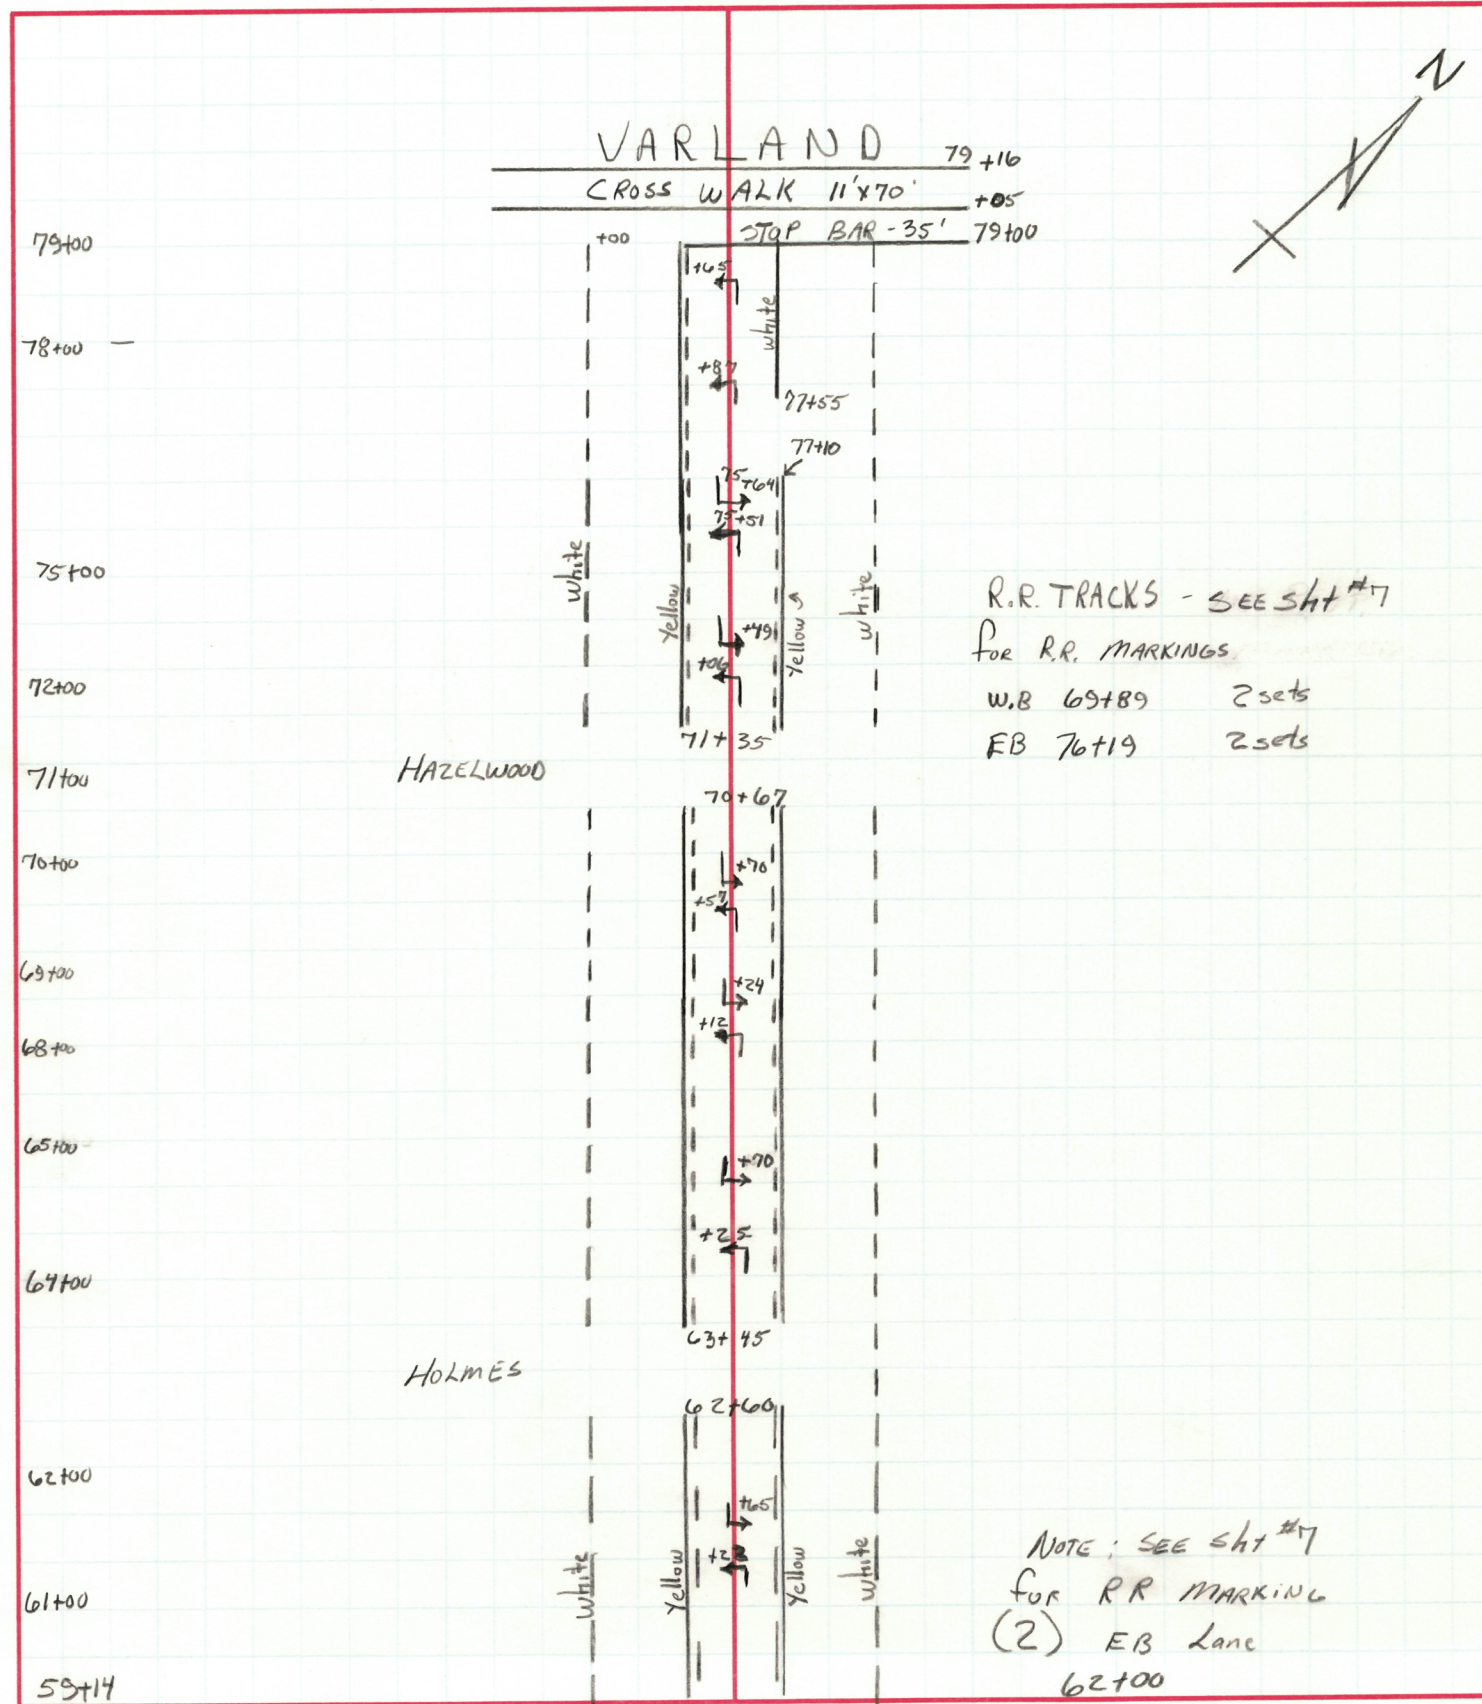

PERSONNEL	TITLE	PERSONNEL	TITLE	COUNTY	DATE	WEATHER	TEMP.
LOEHRKE				LUCAS	1-3-95	FLURRIES	+18
E				S. R. S.R. 51			
CREW				SEC. 1.12			

DESCRIPTION	PAVT	MARKINGS	JOB NO.

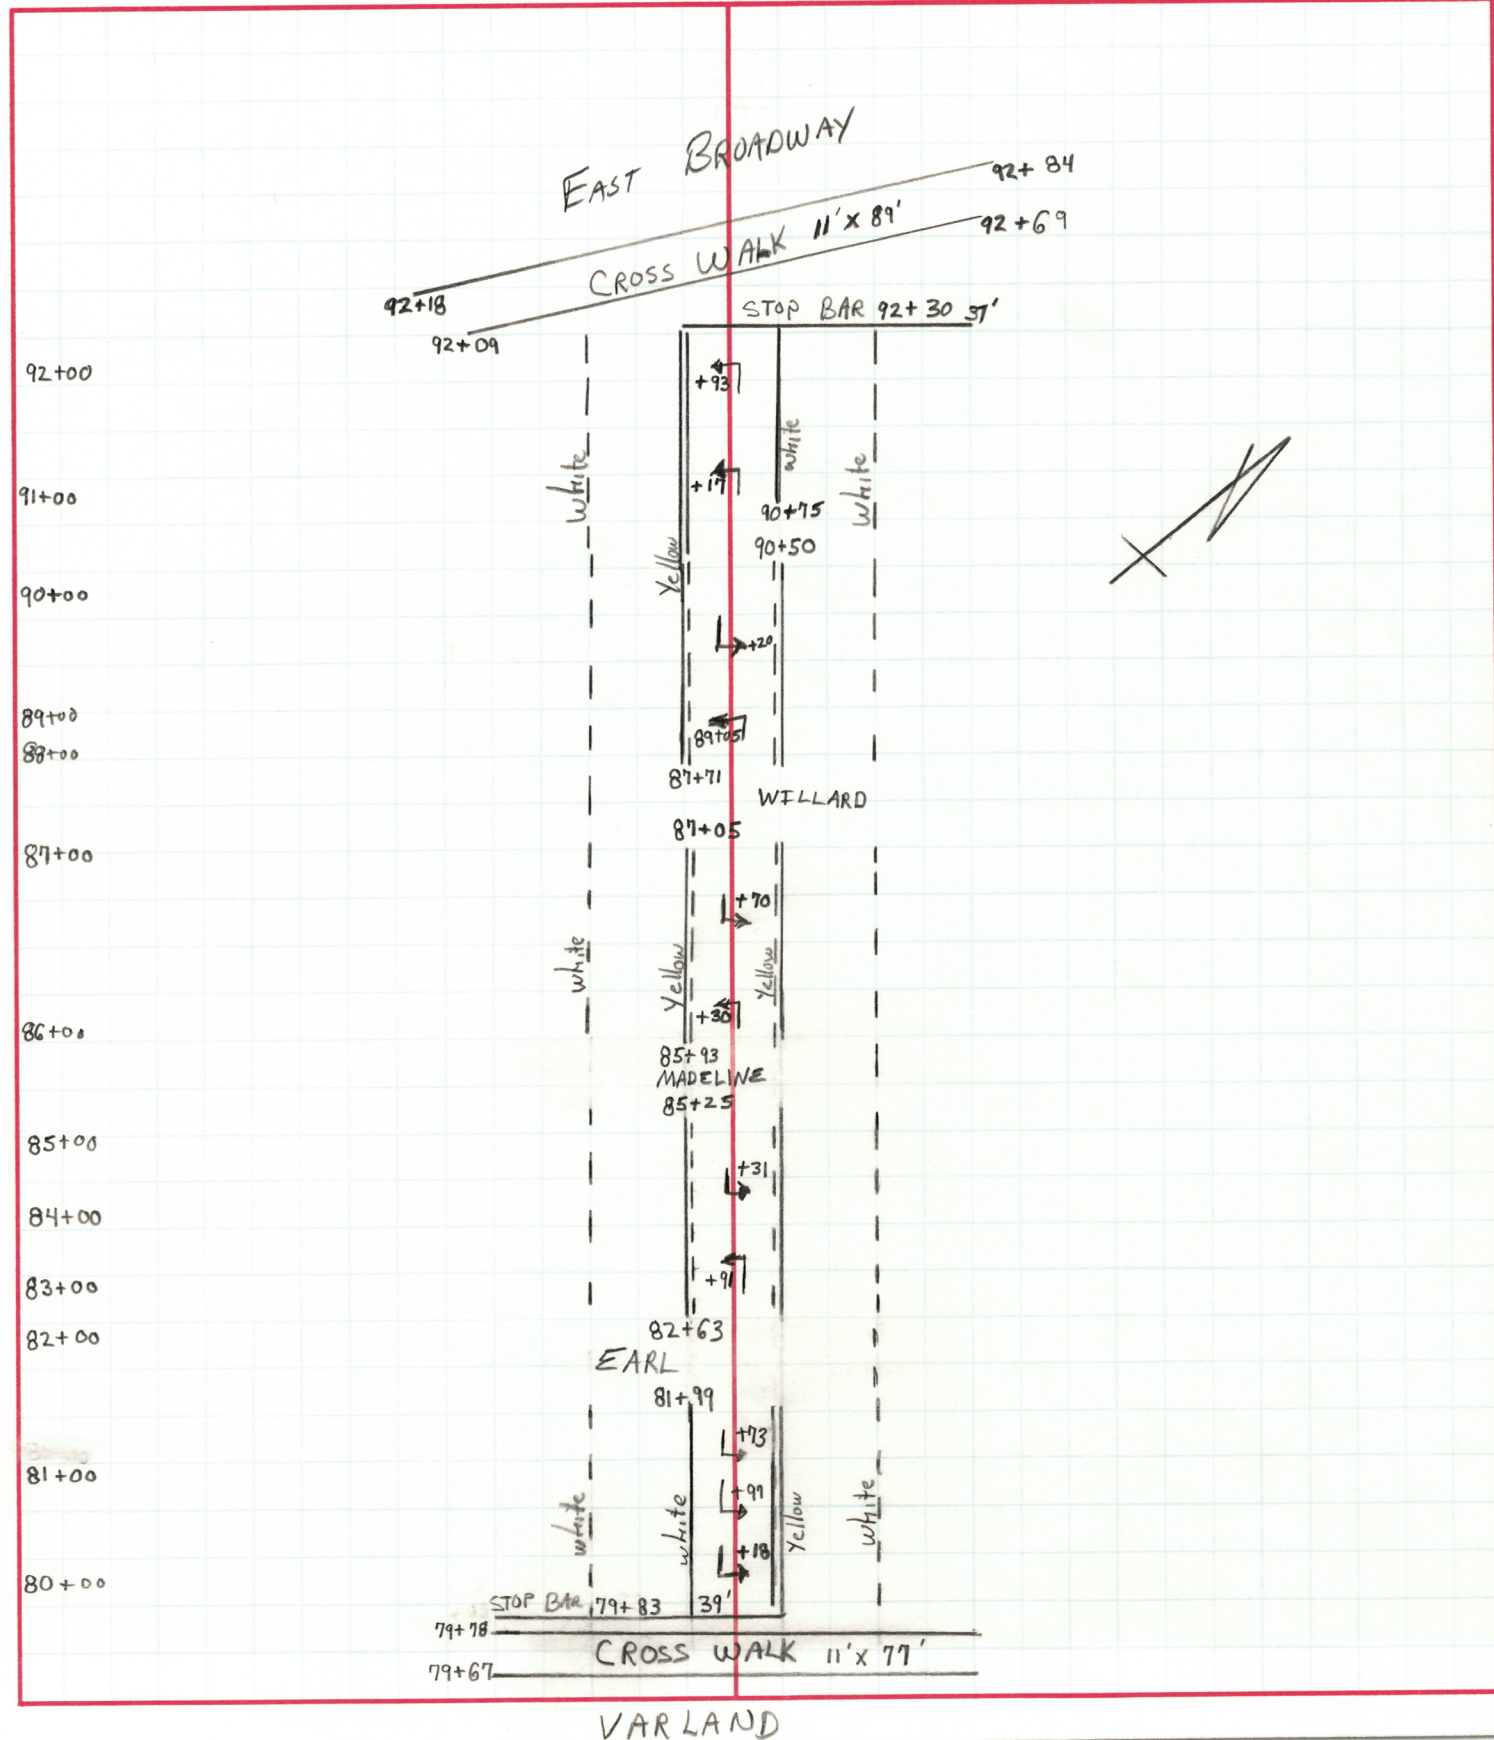

P.m 3


194SWH

OHIO DEPARTMENT OF TRANSPORTATION

SHEET NO. 5 of 12

PERSONNEL	TITLE	PERSONNEL	TITLE	COUNTY	DATE	WEATHER	TEMP.
LOEHRKE				LUCAS	1-3-95	FLURRIES	+18
Crew				S.R. S.R. 51			
				SEC. 1.12			

DESCRIPTION	PAVT	MARKINGS	JOB NO.
	LEFT	CENTER LINE	RIGHT

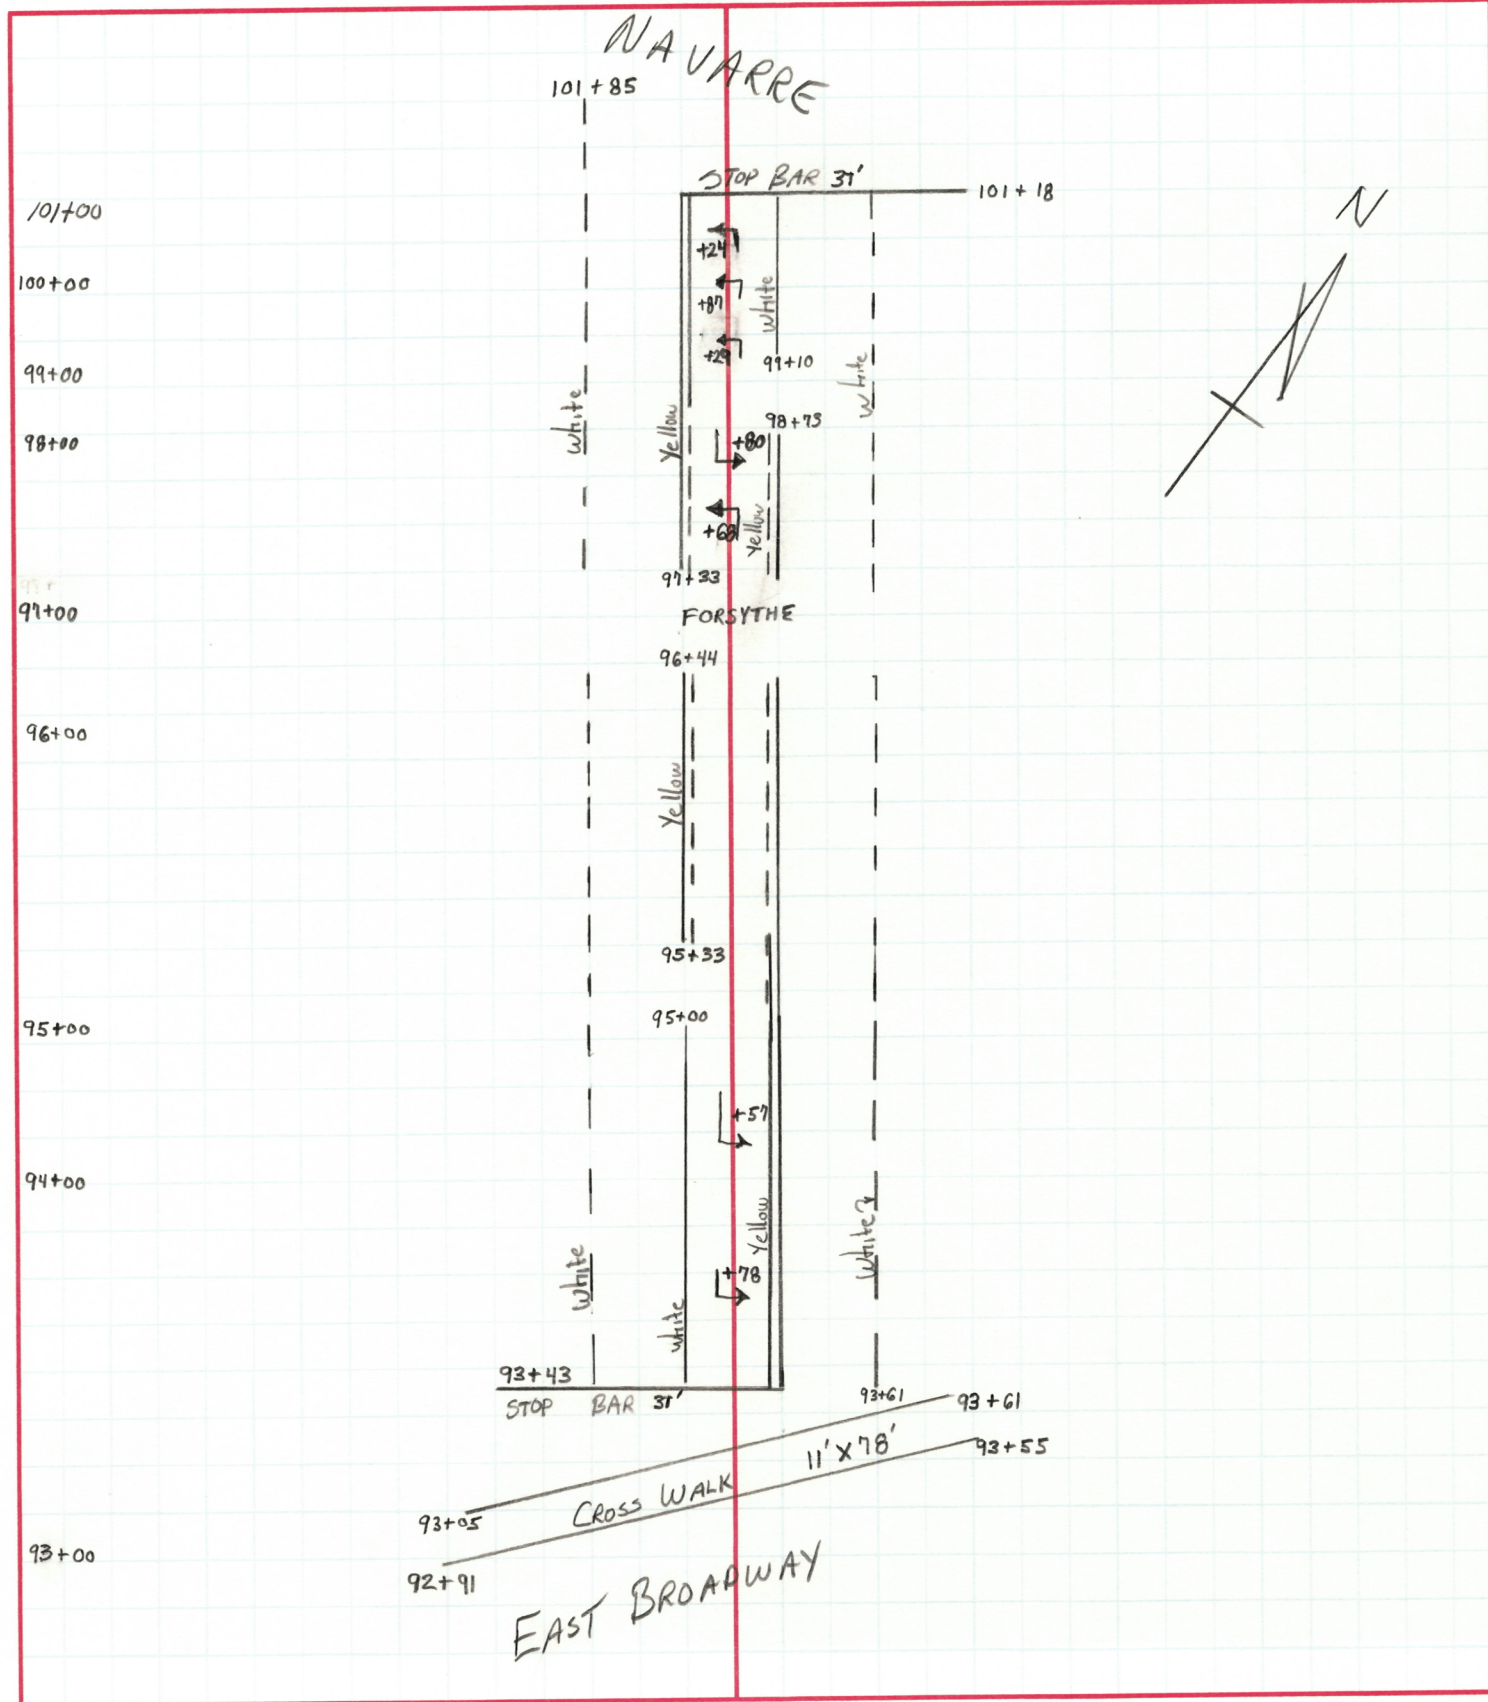

SHEET 6 OF 12

SHEET 6 OF 12

COUNTY LUCAS ROUTE S.R. 51 SECTION 1/2

[illegible]

SHEET 7 OF 12

1994 TWO-LANE RESURFACING PROGRAM
4- PAVEMENT DATA

COUNTY LUCAS ROUTE S.R. 51 SECTION 1.12

* = STATION LOCATION

[illegible]

DATE 1-3-95

FOUR

LANE RESURFACING PROGRAM

SHEET 8 OF 12

UTILITIES (CATCH BASIN, MANHOLE, INLET, WATER VALVE, BOX AND MONUMENT BOX)

COUNTY LUCASROUTE S.R. 51SECTION 1.12

R = RAISE F = FEATHER

STATION	OUT (FT) RT/LT OF ϕ	CATCH BASIN	MAN- HOLE	INLET	W V BOX	MON BOX	CASTING		REMARKS ie: RECONSTRUCT, NO WORK
							R	F	
59+14	1' LT ϕ					X		X	ROUND
59+31	22' LT ϕ		X					X	WATER
62+53	LEFT OF CURB			X				X	GOOD
62+53	RIGHT OF CURB			X				X	GOOD
62+86	ϕ		X					X	GOOD
63+13	7' RT ϕ		X					X	WATER
63+25	18 RT ϕ		X					X	WATER
63+27	18' LT ϕ		X					X	WATER
63+31	15' RT ϕ		X					X	WATER
64+39	15' RT ϕ		X					X	WATER
66+90	LT CURB			X				X	GOOD
66+90	RT CURB			X				X	GOOD
70+52	28' LT ϕ	X						X	GOOD
70+67	RT CURB	X						X	GOOD
71+02	25' RT ϕ		X					X	SANITARY
71+22	14' RT ϕ		X					X	WATER
72+65	RT CURB			X				X	GOOD
72+65	LT CURB			X				X	GOOD
74+90	LT CURB			X				X	GOOD
75+99	RT CURB			X				X	GOOD
75+99	LT CURB			X				X	GOOD
76+02	6' LT ϕ					X		X	GOOD
77+38	RT CURB			X				X	GOOD
77+40	LT CURB							X	GOOD
77+49	22' LT ϕ		X					X	WATER
79+51	24' LT ϕ		X					X	WATER
79+60	24' LT ϕ		X					X	SANITARY
79+60	16' RT ϕ		X						SANITARY

DATE 1-3-95

FOUR

LANE RESURFACING PROGRAM

SHEET 9 OF 12

UTILITIES (CATCH BASIN, MANHOLE, INLET, WATER VALVE, BOX AND MONUMENT BOX)

COUNTY LUCAS ROUTE S.R. 51 SECTION 1.12

R = RAISE F = FEATHER

STATION	OUT (FT) RT/LT OF ϕ	CATCH BASIN	MAN- HOLE	INLET	W V BOX	MON BOX	CASTING		REMARKS ie: RECONSTRUCT, NO WORK
							R	F	
79+73	23' LT ϕ		X					X	WATER
79+73	27' RT ϕ		X					X	SANITARY
79+78	27' LT ϕ		X					X	SANITARY
80+09	RT CURB			X				X	GOOD
80+14	LT CURB			X				X	GOOD
81+86	10' LT ϕ		X					X	SANITARY
82+34	24' LT ϕ		X					X	WATER
82+48	24' LT ϕ					X		X	GOOD
82+82	RT CURB			X				X	GOOD
82+84	LT CURB			X				X	GOOD
85+39	21 LT ϕ		X					X	WATER
85+57	25 LT ϕ					X		X	GOOD
85+98	RT CURB			X				X	GOOD
86+00	LT CURB			X				X	GOOD
87+08	10' LT ϕ		X					X	SANITARY
87+23	8' RT ϕ		X					X	SANITARY
87+54	8' RT ϕ		X					X	WATER
87+91	RT CURB			X				X	GOOD
87+91	LT CURB			X				X	GOOD
89+94	7' RT ϕ		X					X	SANITARY
92+27	20' LT ϕ		X					X	WATER
92+28	24' LT ϕ		X					X	WATER
92+28	23' RT ϕ		X					X	WATER
92+65	4 LT ϕ		X					X	WATER
92+65	ON ϕ		X					X	TELEPHONE
92+84	ON ϕ					X		X	MON BOX - GOOD
92+85	3' RT ϕ					X		X	MON BOX - GOOD

1-3-95

FOUR
~~TWO~~ LANE RESURFACING PROGRAM

SHEET 10 OF 12

UTILITIES (CATCH BASIN, MANHOLE, INLET, WATER VALVE, BOX AND MONUMENT BOX)

COUNTY LUCAS ROUTE S.R. 51 SECTION 1.12

$R = \text{RAISE}$ $F = \text{FEATHER}$

[illegible]

SHEET 11 OF 12

4-

PAVEMENT DATA

NOTE: LOCATE ALL
CHANGES IN PVMT WIDTH

COUNTY LUCAS ROUTE S.R. 51 SECTION 1/2

[illegible]

194S:WH

OHIO DEPARTMENT OF TRANSPORTATION

SHEET NO. 12/12

PERSONNEL	TITLE	PERSONNEL	TITLE	COUNTY	DATE	WEATHER	TEMP.
LOEHRKE				LUCAS	1-3-95	COLD	+20
Crew				S. R. 51			
				SEC. 1.12			

DESCRIPTION	PAVT	WIDTH	JOB NO.
-------------	------	-------	---------

LEFT

CENTER LINE

RIGHT

