


PERSONNEL TITLE PERSONNEL TITLE
 W. Denno _____
 D. Curtis _____
 D. Stevens _____

COUNTY Lucas DATE Sept. 14, 1971
 S. R. 223 WEATHER Sunny-mild
 SEC. TOLEDO TEMP. 75°f

DESCRIPTION References To Control Points JOB NO. 02994(a)

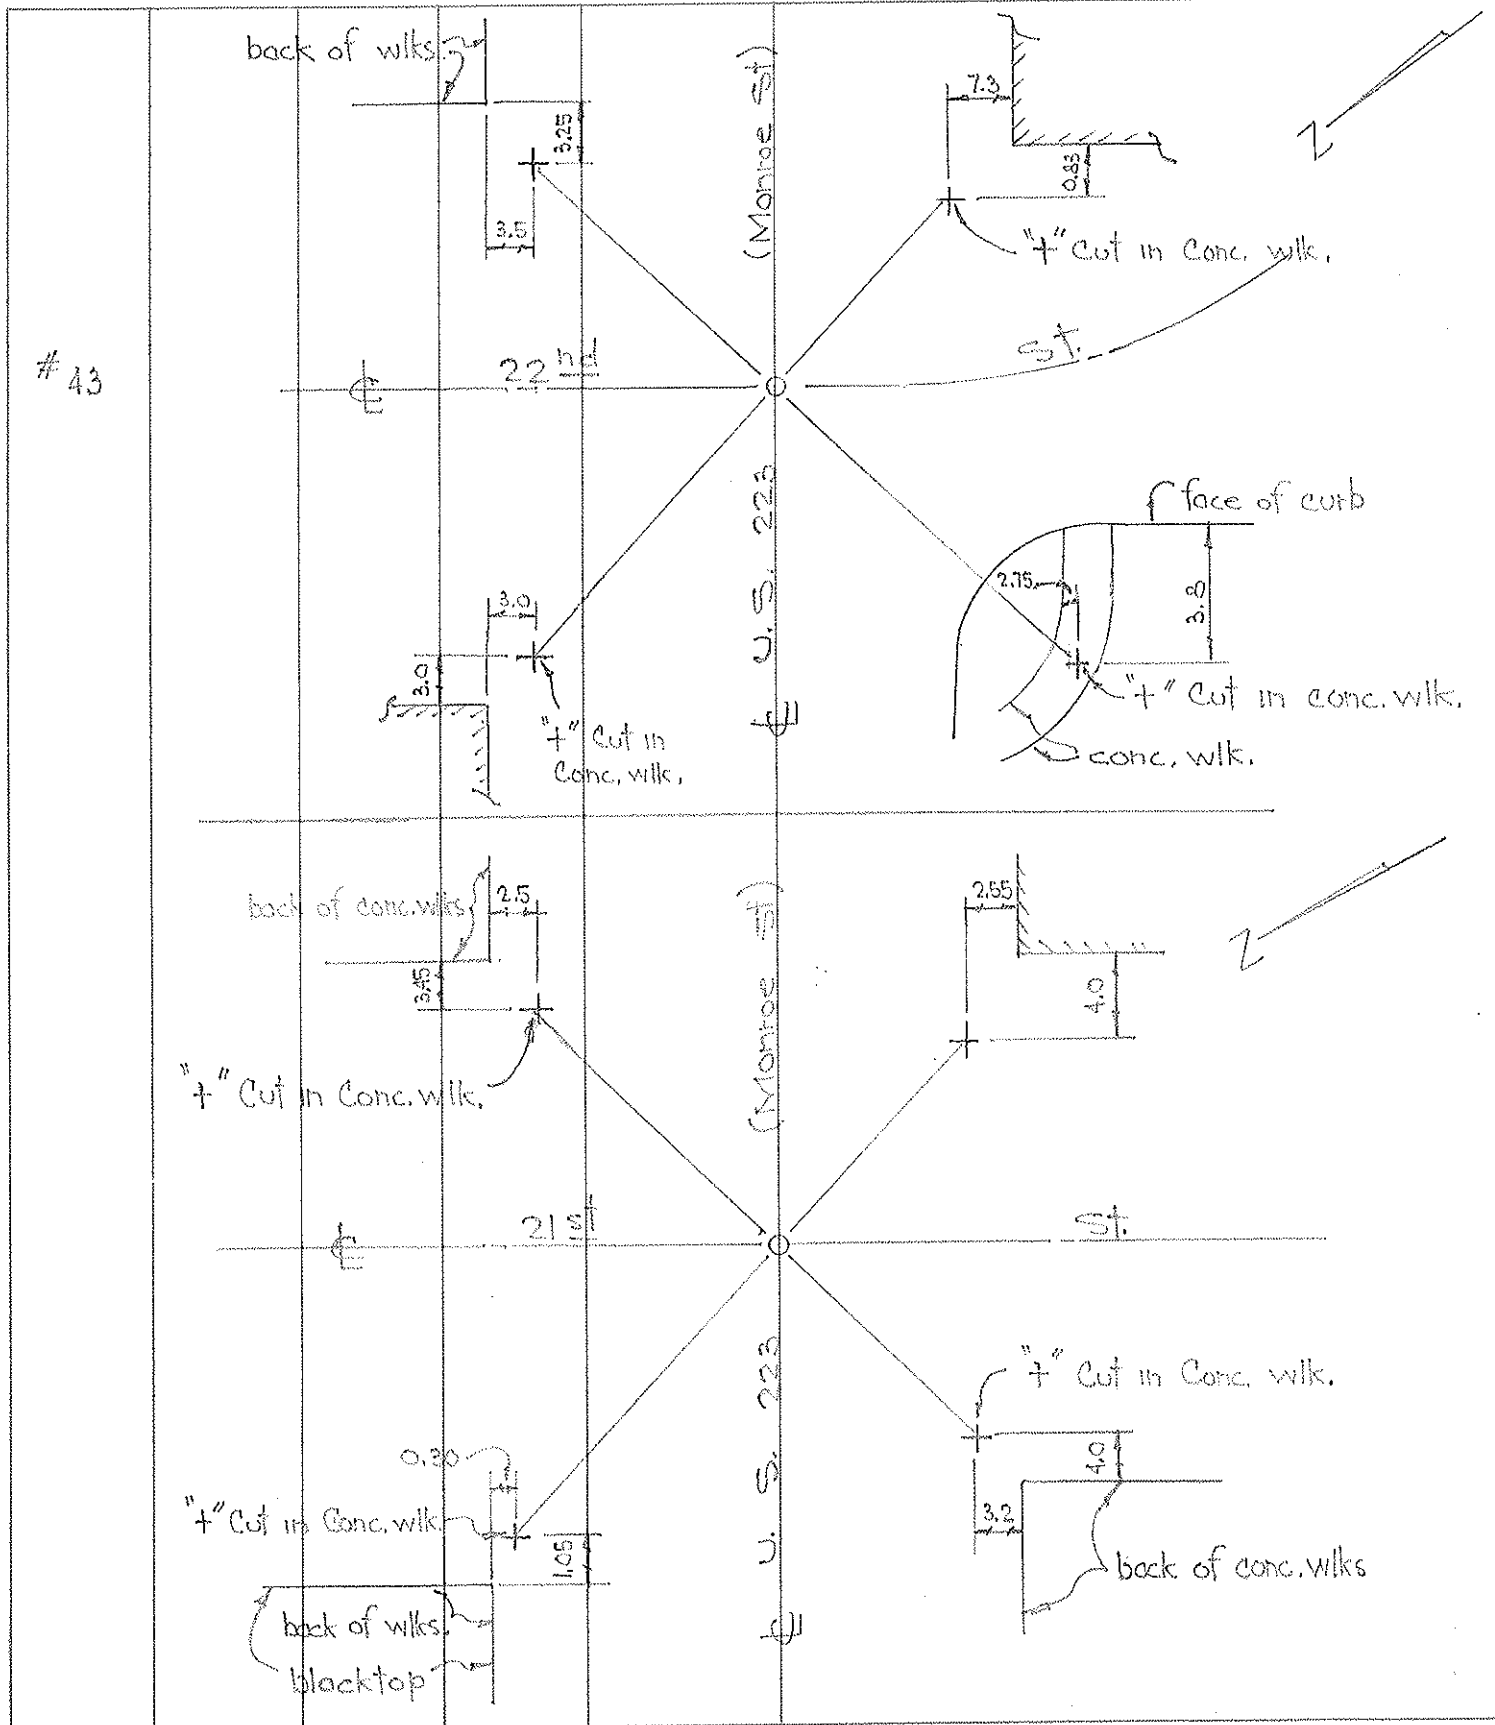

| PERSONNEL | TITLE | PERSONNEL | TITLE |
|-----------|-------|-----------|-------|
| R.S. | P.C. | | |
| W.S. | Notes | | |
| C.H. | Chain | | |

PROJECT Monroe Street DATE April 21, 1971

PROJECT LIMITS _____ WEATHER _____

FROM STA. _____ TO STA. _____ TEMP _____

DESCRIPTION Monroe St. Monuments. All I. Pin in Concr.

#10

#9

