


PERSONNEL	TITLE	PERSONNEL	TITLE
W. DENNO			
D. CURTIS			
D. STEVENS			

COUNTY LUCAS DATE 13 SEPT 71
 S. R. U.S. 223 WEATHER FAIR
 SEC. TOLEDO TEMP. 60±

DESCRIPTION _____ REFERENCES TO CONTROL POINTS _____ JOB NO. _____
 LEFT CENTER LINE RIGHT

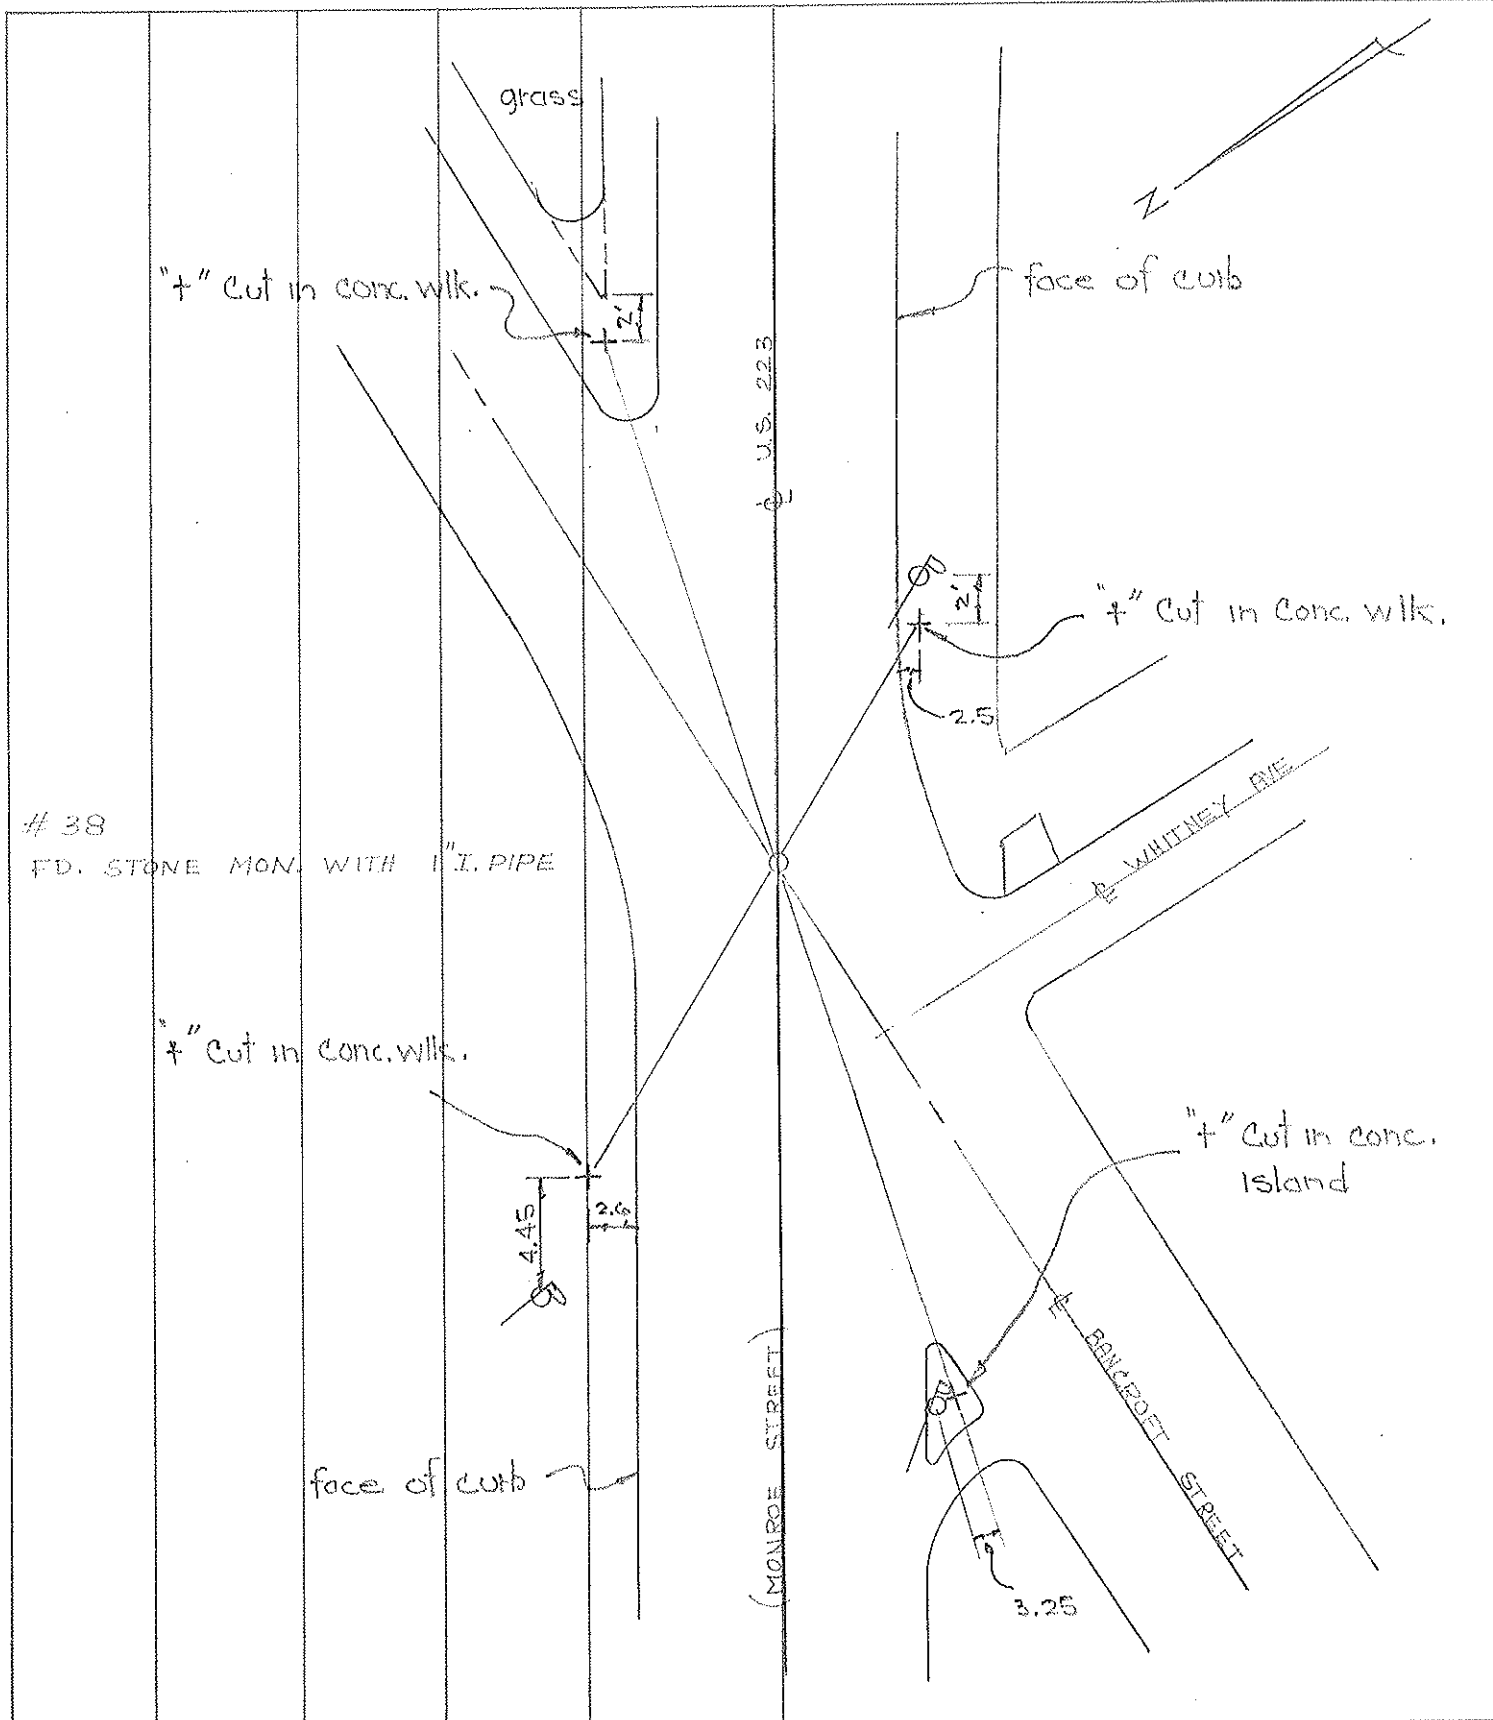

PERSONNEL	TITLE	PERSONNEL	TITLE
<u>RS.</u>	<u>PC.</u>		
<u>WS.</u>	<u>Notes</u>		
<u>CH.</u>	<u>Chain</u>		

PROJECT Monroe Street DATE April 21, 1971

PROJECT LIMITS _____ WEATHER _____

FROM STA _____ TO STA _____ TEMP _____

DESCRIPTION Centerline References - Monroe Monuments - All 1" I. Pin in Concr.

