

O.D.O.T. DISTRICT 2 SURVEY OFFICE (USE ONLY)

PERSONNEL \_\_\_\_\_ REFERENCE NO. 36 SHEET 2 OF 2

NOTES DENNO DATE 9-10-71 ROUTE SR 51  
H.C. CURTIS WEATHER FAIR COUNTY LUCAS  
R.C. STEVENS TEMP. 70° TOWNSHIP TOLEDO  
BARANNAN SECTION 28  
T 9 S R 7 E

TYPE MONUMENT STONE IN MONBOX


ON SURFACE - BELOW ON

LEFT - ☉ PAV'T - RIGHT \_\_\_\_\_


\_\_\_\_\_ TO \_\_\_\_\_ EDGE PAVEMENT

S.L.M. 334+22.40

Grid: Northing: 731273.2632 Easting: 1673652.4334

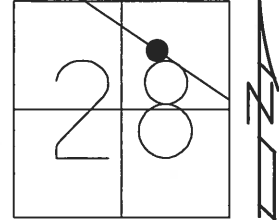

RECORD:  
STONE IN MONBOX  
REF36  
3-20-13

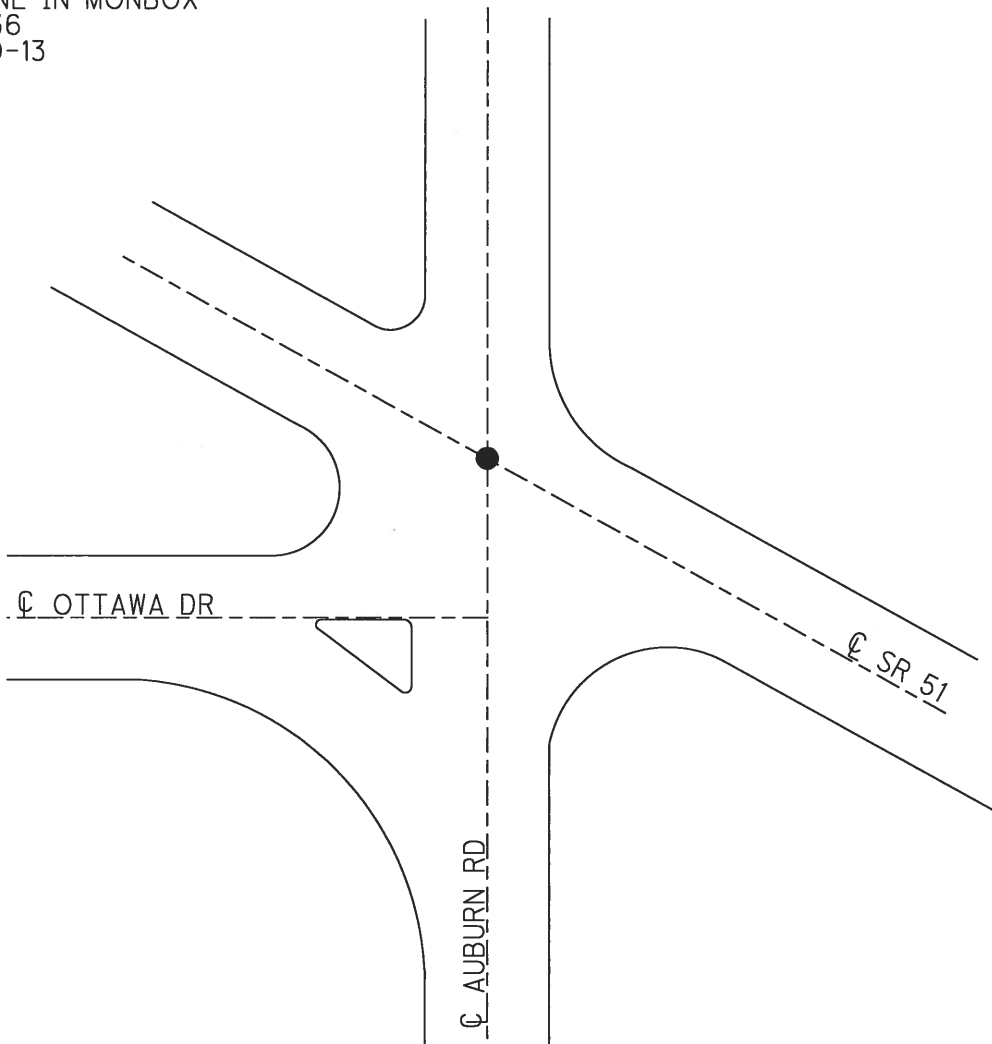

PERSONNEL	TITLE	PERSONNEL	TITLE
W. DENNO			
D. CURTIS			
D. STEVENS			
R. BRANNAN			

COUNTY LUCAS DATE 10 SEPT '71

S. R. U.S. 223 WEATHER FAIR

SEC. TOLEDO TEMP. 70±

DESCRIPTION	REFERENCES LEFT	TO CENTER LINE	CONTROL POINTS RIGHT	JOB NO.
-------------	--------------------	-------------------	----------------------------	---------

