


O.D.O.T. DISTRICT 2 SURVEY OFFICE (USE ONLY)

PERSONNEL \_\_\_\_\_ REFERENCE NO. 35 SHEET 1 OF 2


NOTES DENNO DATE 9-10-71 ROUTE SR 51  
H.C. CURTIS WEATHER FAIR COUNTY LUCAS  
R.C. STEVENS TEMP. 70° TOWNSHIP TOLEDO  
BARANNAN SECTION 27  
T 9 S R 7 E

TYPE MONUMENT FIP IN MONBOX  
ON SURFACE - BELOW ON  
LEFT - ☉ PAV'T - RIGHT \_\_\_\_\_  
\_\_\_\_\_ TO \_\_\_\_\_ EDGE PAVEMENT  
S.L.M. 365+76.99

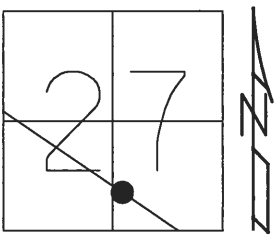

Grid: Northing: 732995.7578 Easting: 1671009.6268

RECORD:  
FIP IN MONBOX  
REF35  
3-20-13

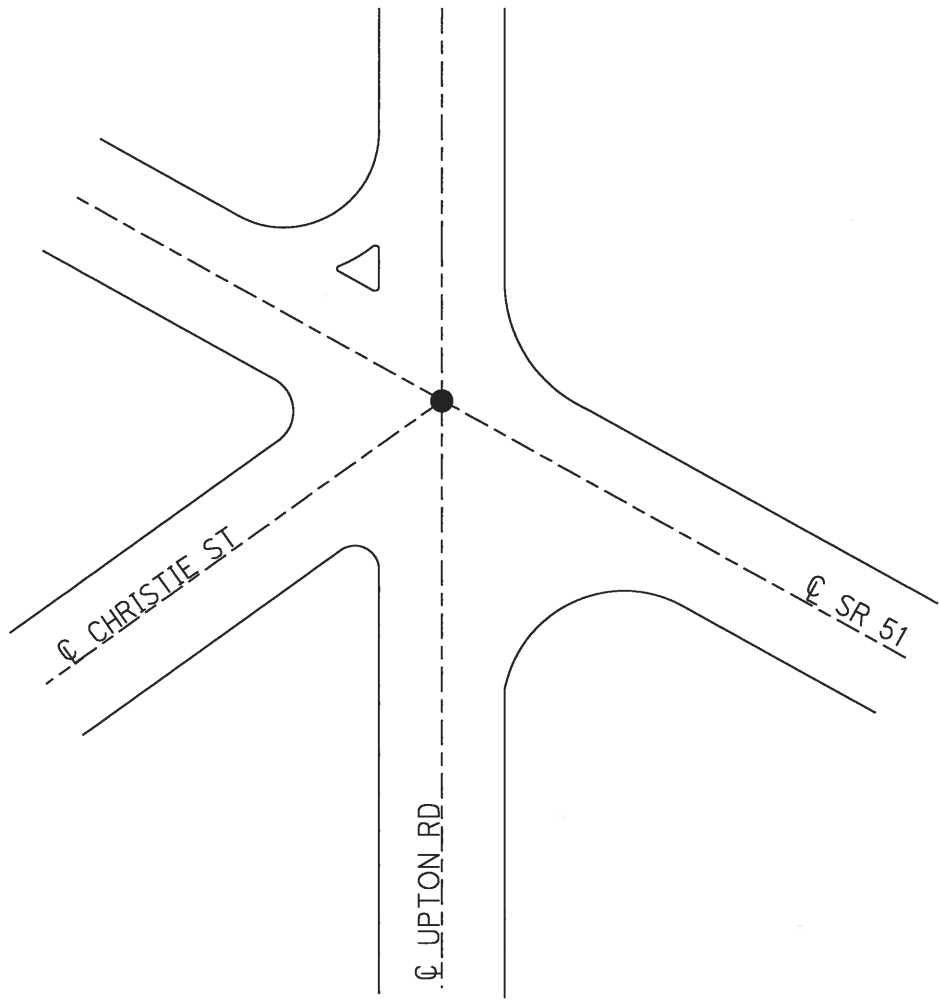

PERSONNEL	TITLE	PERSONNEL	TITLE
W. DENNO			
D. CURTIS			
D. STEVENS			
R. BRANNAN			

COUNTY LUCAS DATE 10 SEPT '71  
 S. R. U.S. 223 WEATHER FAIR  
 SEC. TOLEDO TEMP. 70±

DESCRIPTION \_\_\_\_\_ REFERENCES \_\_\_\_\_ TO CONTROL POINTS \_\_\_\_\_ JOB NO. \_\_\_\_\_  
LEFT CENTER LINE RIGHT

