


PERSONNEL	TITLE	PERSONNEL	TITLE	COUNTY	DATE
W. DENNO				LUCAS	7 SEPT 71
D. CURTIS				U.S. 223	WEATHER CLOUDY
P. STEVENS					
R. BRANNAN				SEC.	TEMP. 70 ±

DESCRIPTION _____ REFERENCES TO CONTROL POINTS _____ JOB NO. _____
 LEFT CENTER LINE RIGHT

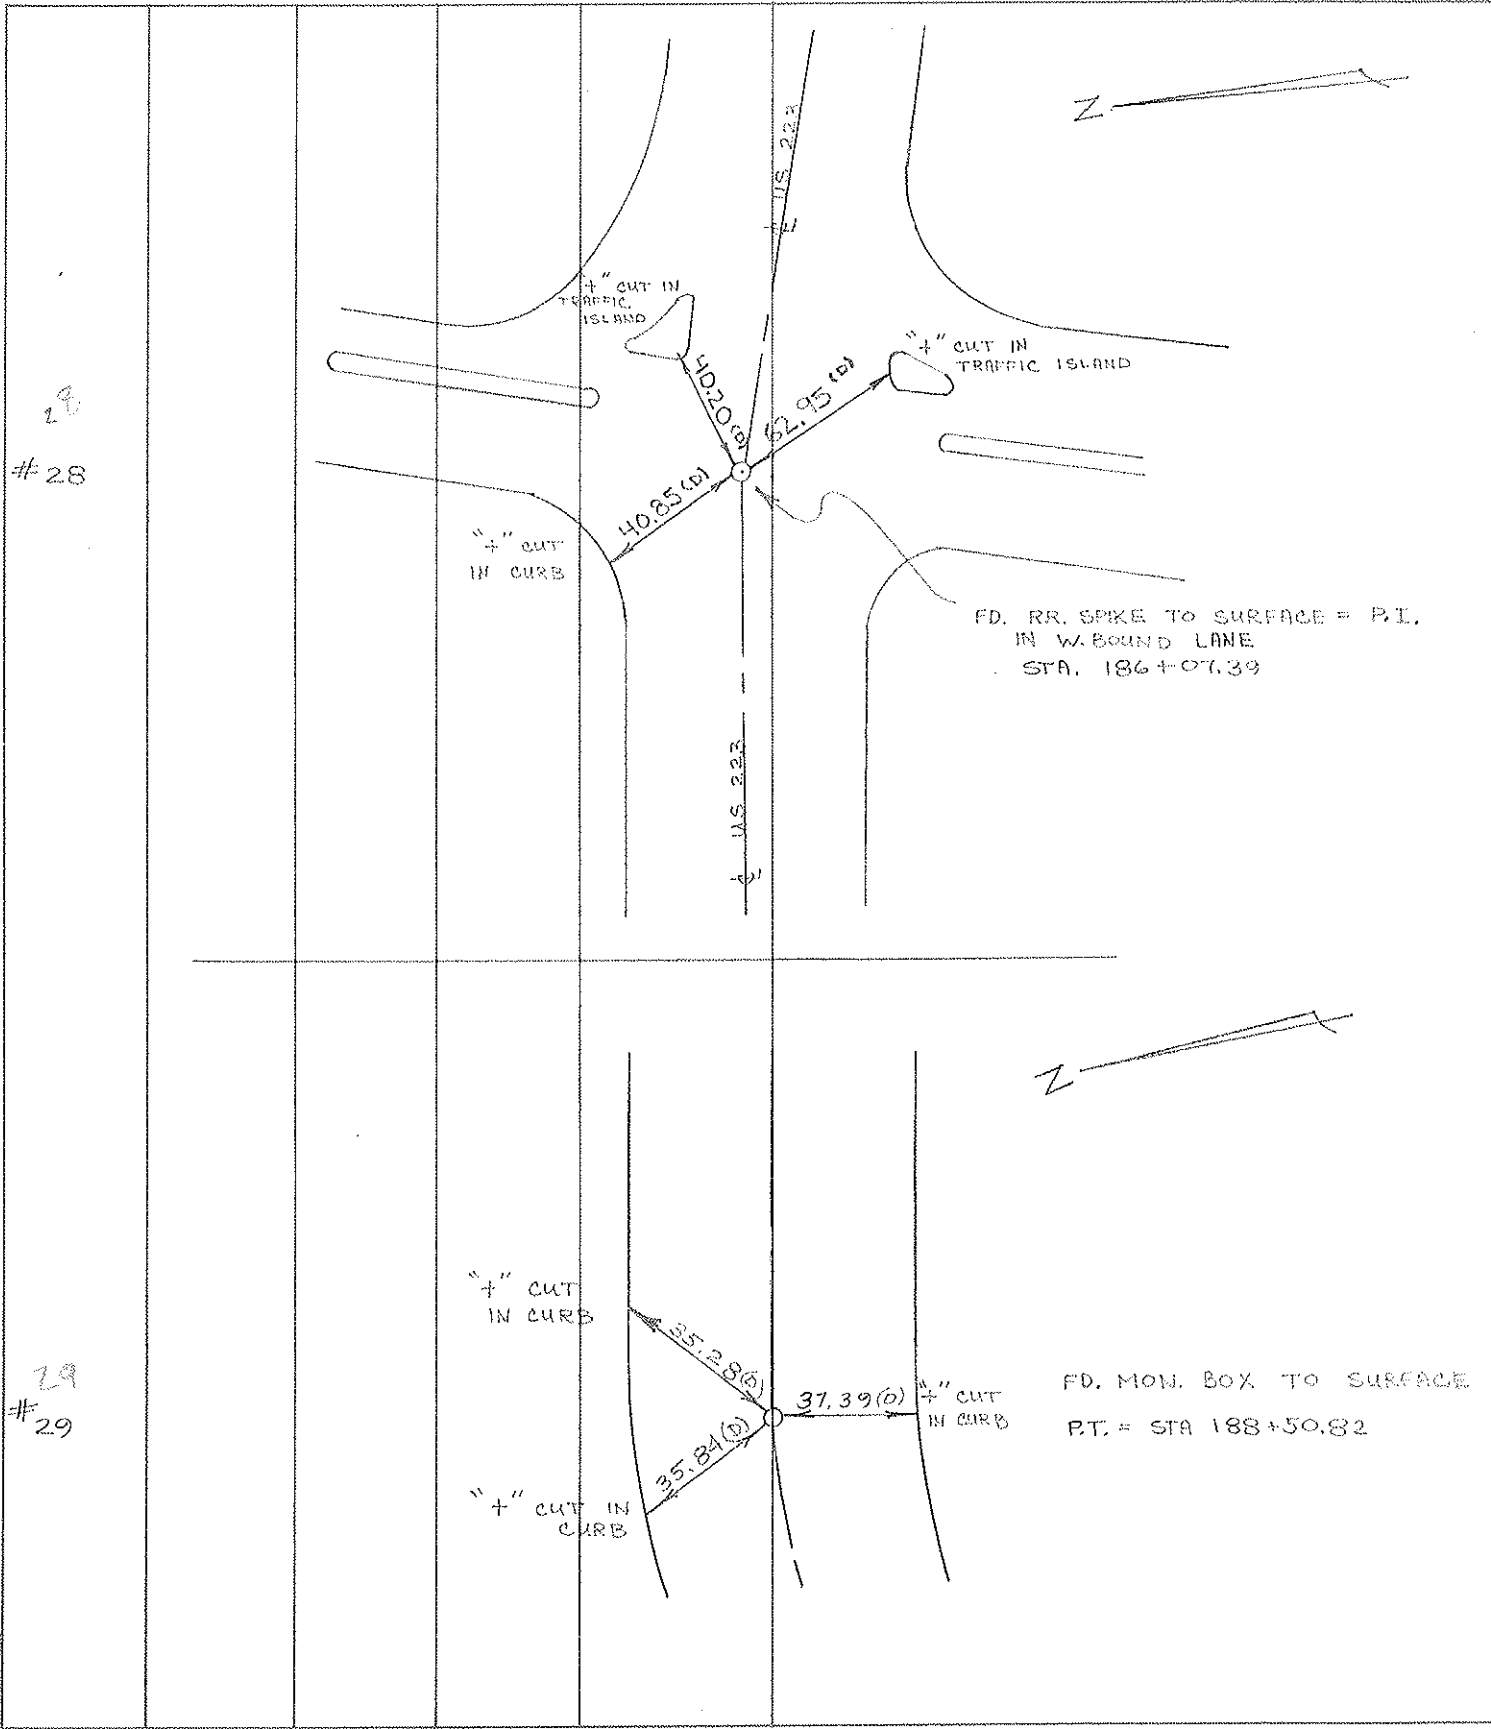

28
#28

29
#29

