


PERSONNEL	TITLE	PERSONNEL	TITLE
W. DENNO			
D. CURTIS			
R. BRANNAN			

COUNTY LUCAS DATE AUGUST 31, 1971  
 S. R. U.S. # 223 WEATHER FAIR  
 SEC. \_\_\_\_\_ TEMP. 70° ±

DESCRIPTION REFERENCES TO CONTROL POINTS JOB NO. \_\_\_\_\_  
 LEFT CENTER LINE RIGHT

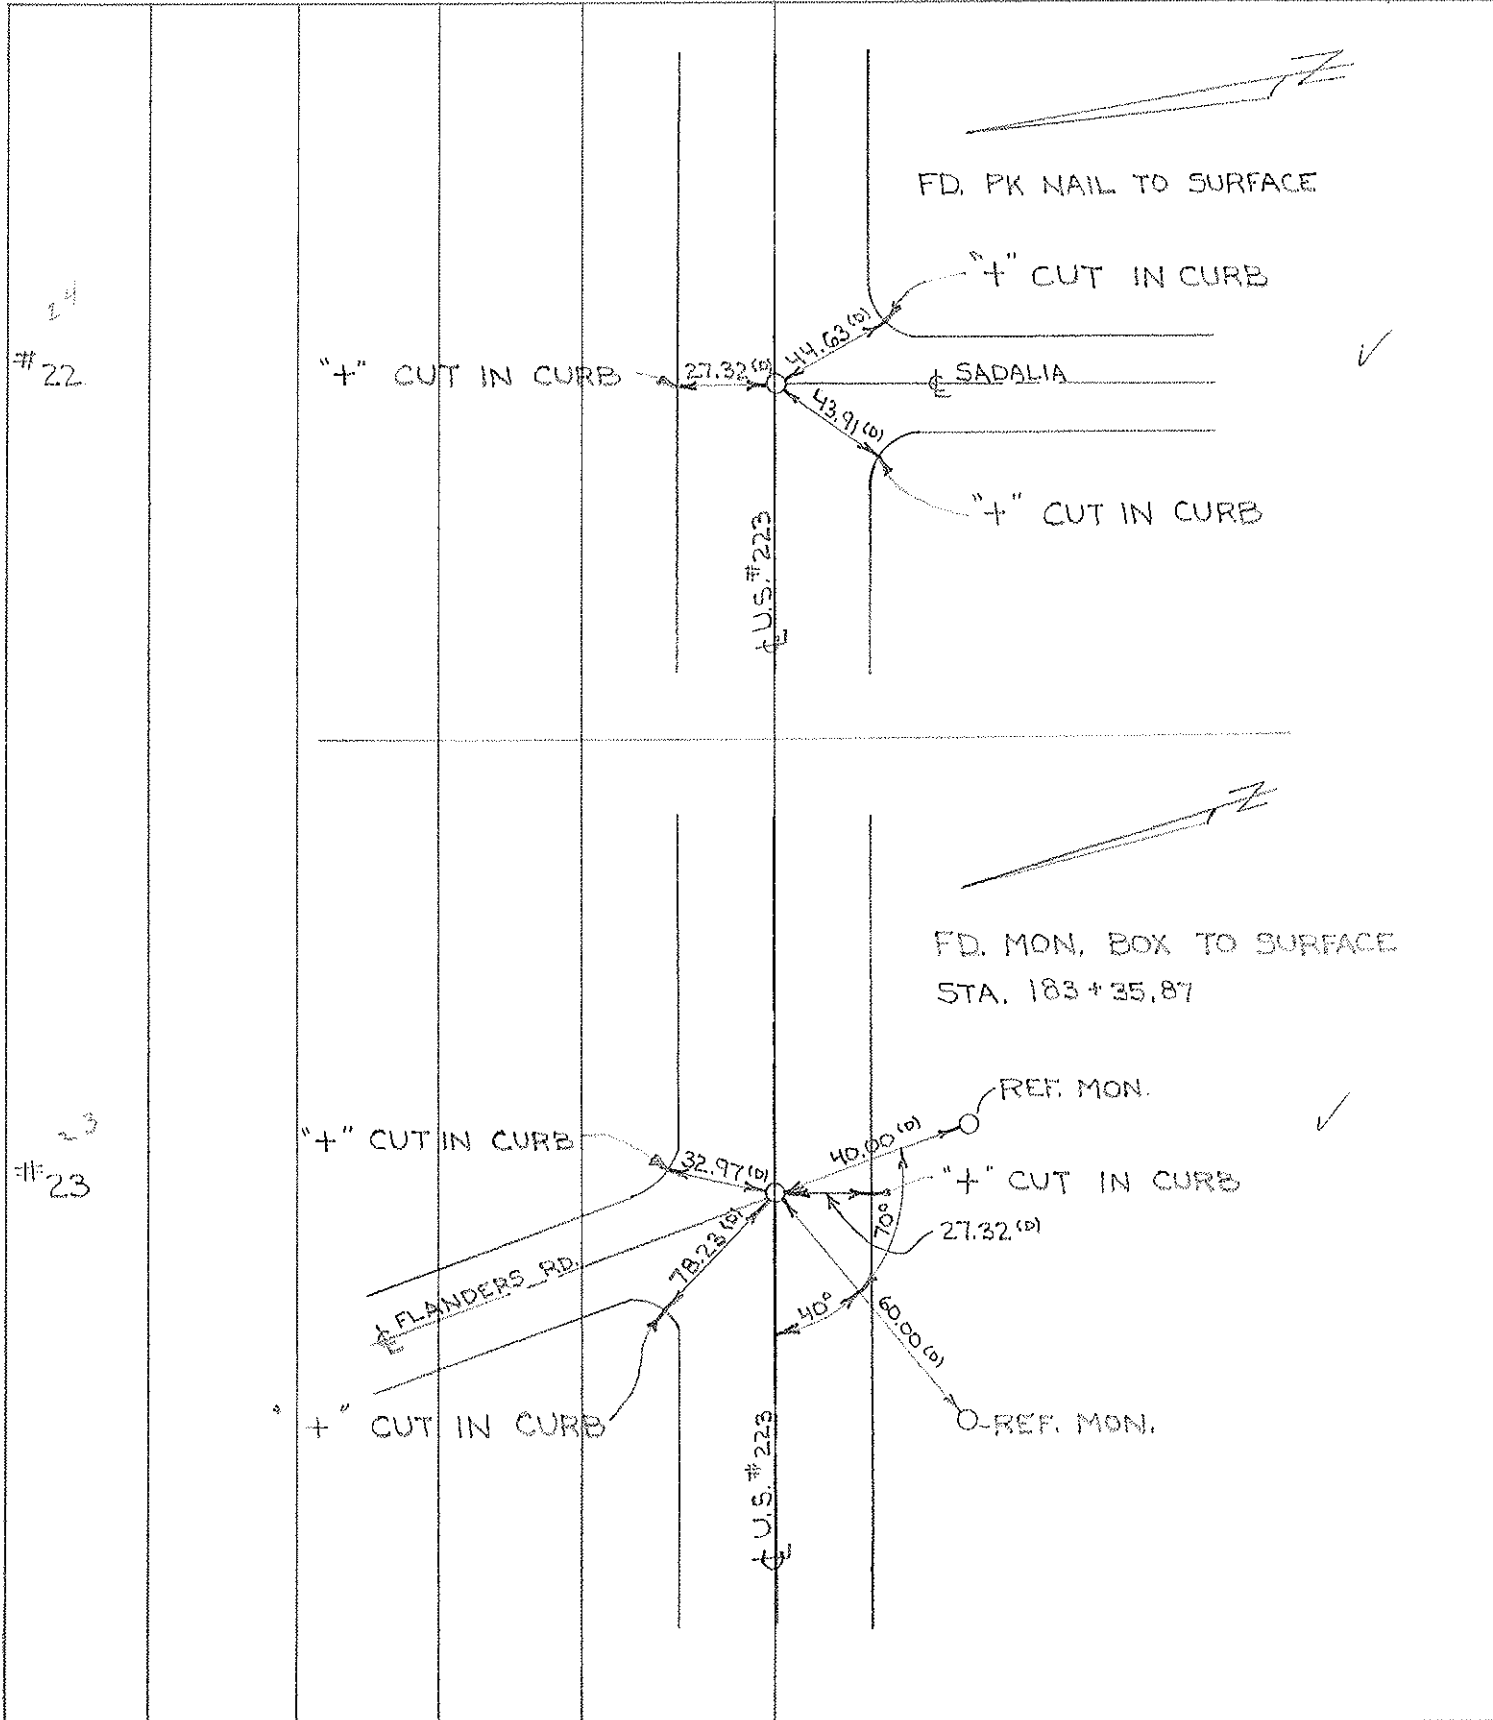

PERSONNEL	TITLE	PERSONNEL	TITLE	COUNTY	DATE
Stone				Lucas	7 Mar. 62
✓				S. R. 223	WEATHER Mild
Corw				SEC.	TEMP. 33°
DESCRIPTION				References to Control Pts.	JOB NO. 02263
	LEFT	CENTER LINE	RIGHT		

172+12.90-	±	Sadalia	(Set PK Nail)	Δ = 0° 00'
69.16'		S.E.	to N.W. Cor. Step to Appliance Stone	
66.89'		S.W.	to N.E. Cor. 1st. Cor. Block to T.V. Repair Hut.	
66.87'		N.W.	to skinner in F	
179+52.35-	±	Staterville	(Set PK Nail)	Δ = 0° 00'
72.86'		N.W.	to skinner in F	
49.49'		S.W.	to skinner in 8" E. Green Tree	
43.75'		S.E.	to skinner in 10" E. Green Tree	
183+35.87-	±	Flanders Rd.	(Set Monument)	Δ = 0° 18' Rt.
73.35'		S.W.	to skinner in 39' Oak	
57.44'		S.E.	to skinner in 17" Maple	
40.13'		N.E.	to skinner in F	
196+69.93-	P.I.		(Set Monument)	Δ = 0° 18' Lt.
65.99'		N.W.	to skinner in 16" Maple	
92.49'		N.E.	to skinner in F	
103.28'		S.W.	to skinner in F	
214+58.08-	±	Talwadge Rd.	(Set Monument)	Δ = 0° 01' Rt.
90.61'		S.W.	to 50' Rad. Pt.	
42.45'		N.E.	to skinner in F	
107.51'		N.W.	to skinner in F	

(14)

Town 95 Range 6E


Rd. Corner of Sections 13 Remarks

Kind of Monument Iron Pin

FOUND 1931 BY State Wilson F. B. P.

N. & S. Road FLANDERS RD. F. B. P.  
E. & W. Road MONROE ST. F. B. P.  
Sta. 134+69.6

Date Checked:  
4-16-24 KELS0  
F.D. I. PIN.

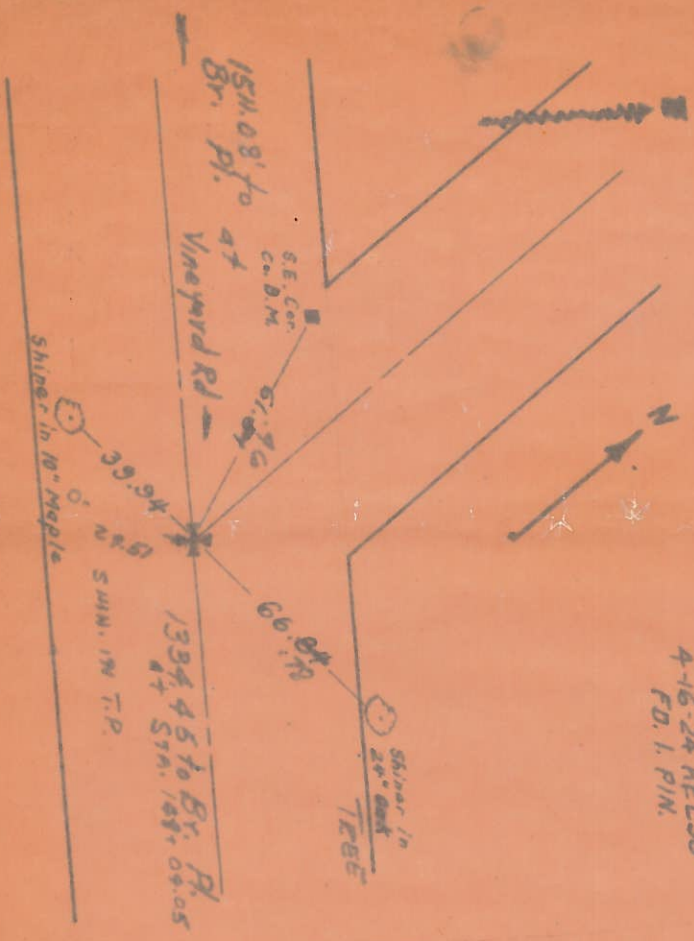

(15)

Town 95 Range 6E

Road Corner of Sections 13 Remarks

Kind of Monument Be. Pl.

FOUND 1931 BY State (Wilson) F. B. P.

N. & S. Road 1334.45' E. of Flanders F. B. P. F. B. P.  
E. & W. Road MONROE ST. F. B. P.  
Sta. 148+04.05

Date Checked:

