


PERSONNEL	TITLE	PERSONNEL	TITLE
W. DENNO			
D. CURTIS			
R. BRANNAN			

COUNTY LUCAS DATE AUGUST 30, 1971
 S. R. U.S. #223 WEATHER SUNNY
 SEC. _____ TEMP. 85°±

DESCRIPTION REFERENCES TO CONTROL POINTS JOB NO. _____
 LEFT CENTER LINE RIGHT

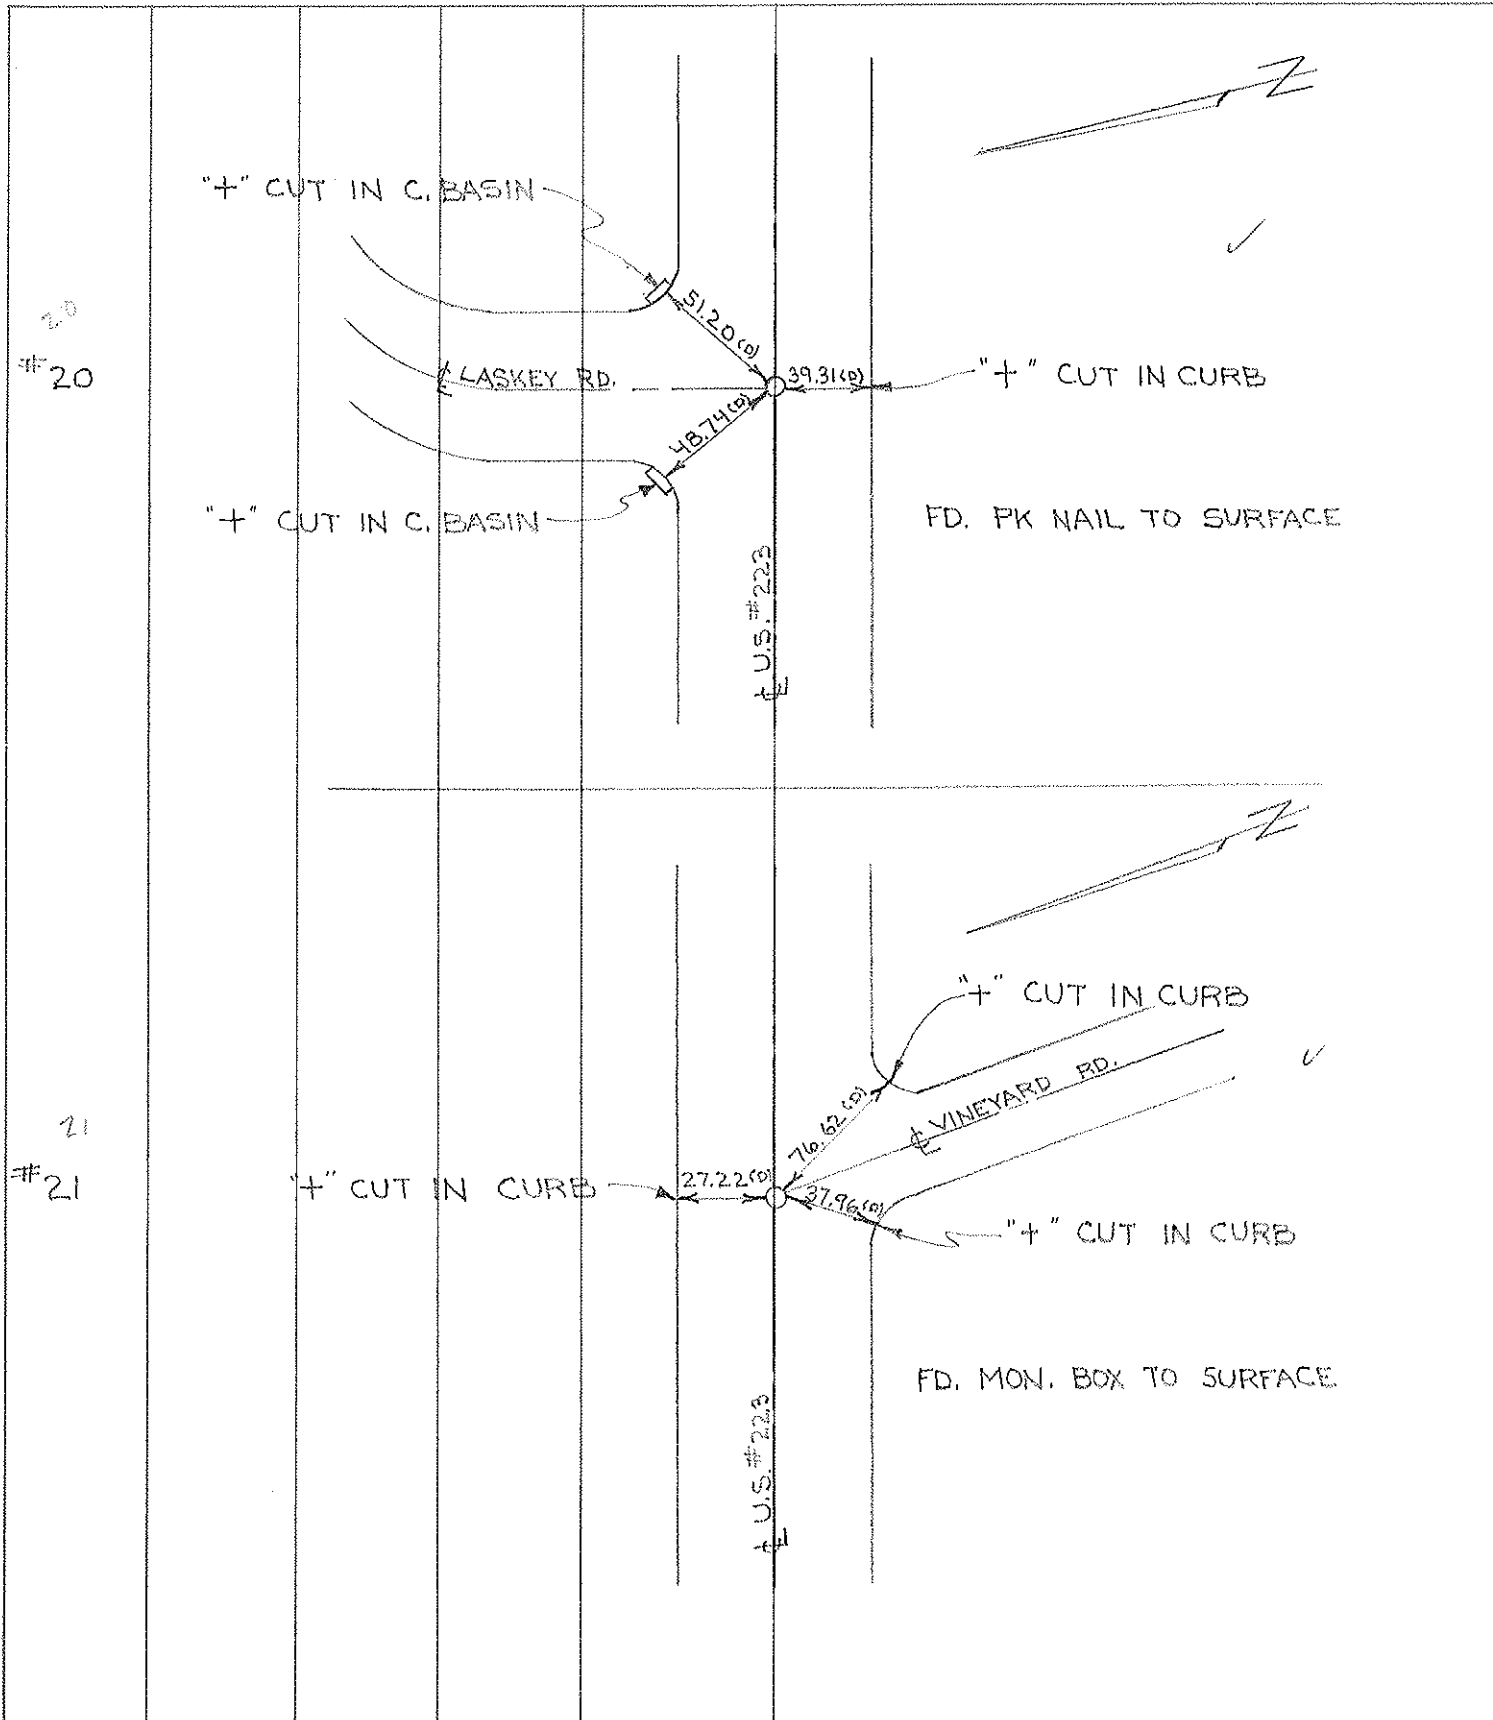

PERSONNEL	TITLE	PERSONNEL	TITLE	COUNTY	DATE
Stone				Lucas	7 Mar. 62
+				S. R. 223	WEATHER Mild
Grow				SEC.	TEMP. 33°

DESCRIPTION References to Control Pts. JOB NO. 02263
LEFT CENTER LINE RIGHT

142+32.76 -	+	Skelly Dr. (Set PK Nail)	$\Delta = 0^{\circ}00'$
37.44'	N.	To skinner in B	
82.14'	S.E.	To skinner in B	
45.52'	S.W.	To skinner in B	
153+22.71 -	+	White Sand Rd. (Set Monument)	$\Delta = 0^{\circ}57' Rt.$
63.78'	N.E.	To "4" in S. End Pump Island	
81.02'	N.W.	To skinner in B	
41.38'	S.S.W.	To skinner in B	
164+52.27 -	+	Laskoy Rd. (Set PK Nail)	$\Delta = 0^{\circ}00'$
61.31'	N.W.	To skinner in B	
85.42'	S.E.	To skinner in B	
84.32'	S.W.	To skinner in B	
165+42.71 -	+	Colgate (Set PK Nail)	$\Delta = 0^{\circ}00'$
65.32'	S.W.	To skinner in B	
38.27'	N.	To skinner in B	
92.81'	S.E.	To skinner in B	
168+25.15 -	+	Vineyard (Set Monument)	$\Delta = 0^{\circ}19' Rt.$
58.00'	N.W.	To skinner in B	
87.48'	N.E.	To skinner in B	
97.00'	S.	To skinner in B	