


PERSONNEL	TITLE	PERSONNEL	TITLE
W. DENNO			
D. CURTIS			
R. BRANNAN			


COUNTY LUCAS DATE AUGUST 30, 1971
 S. R. # 223 WEATHER SUNNY
 SEC. _____ TEMP. 85°±

DESCRIPTION REFERENCES TO CONTROL POINTS JOB NO. _____
 LEFT CENTER LINE RIGHT

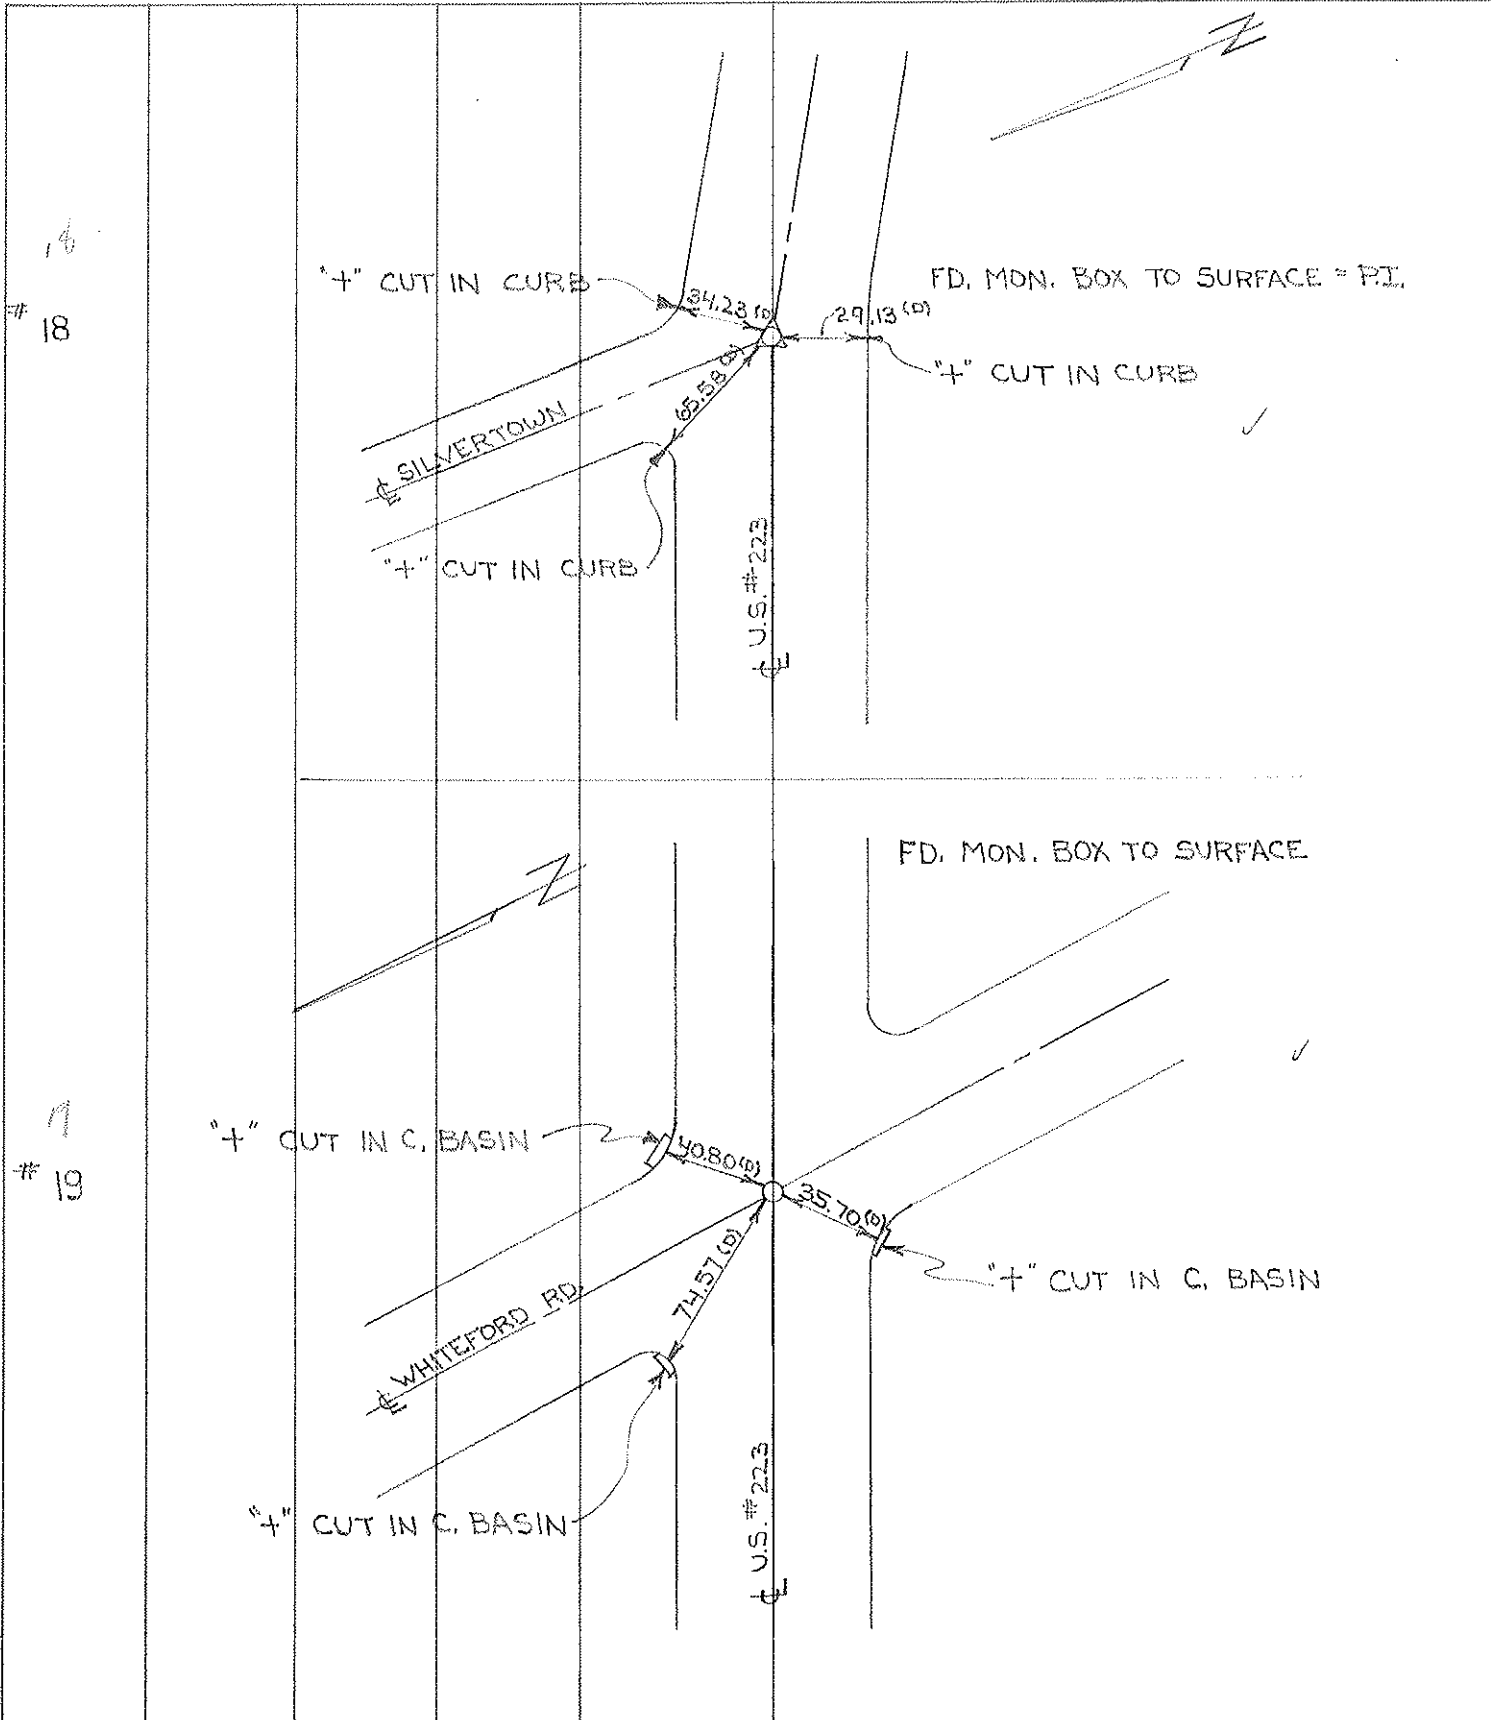

PERSONNEL	TITLE	PERSONNEL	TITLE	COUNTY	DATE	WEATHER	TEMP.
Dennis				Lucas	May 4, 1966	Sunny	50°
Granite				S. R. 223			
Curtis							
Orney				SEC.			

DESCRIPTION Monument Reference 223 Monroe St. JOB NO. _____

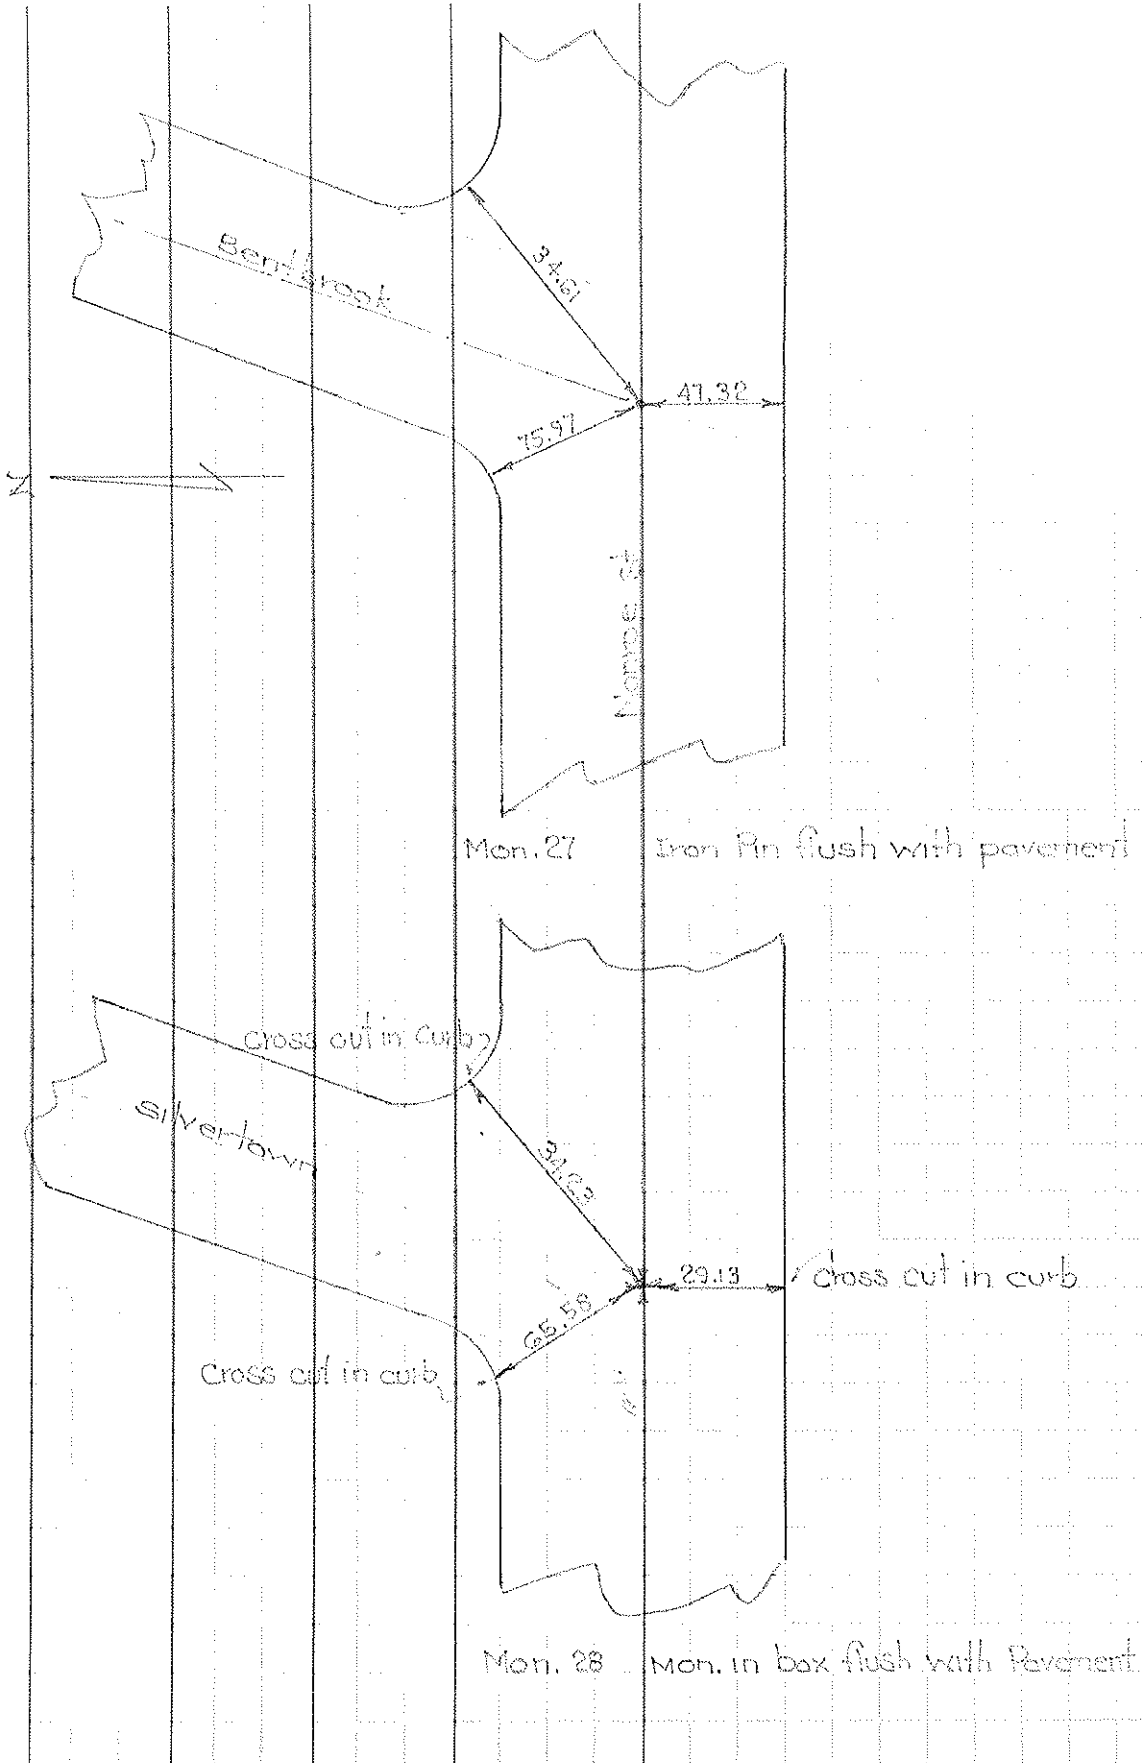


Town 95 Range 6E
 Rd. Corner of Sections 11

Kind of Monument BRASS PLATE Remarks
30 BELOW SURFACE

FOUND ~~SET~~ 1931 BY WILSON

N. & S. Road SILVERTOWN DR. F. B. P.
 E. & W. Road MONROE ST. F. B. P.

AS PER SURVEY BY WILSON 1931 WITH
 STATE HWY. FD BRASS PLATE.
 Date Checked:

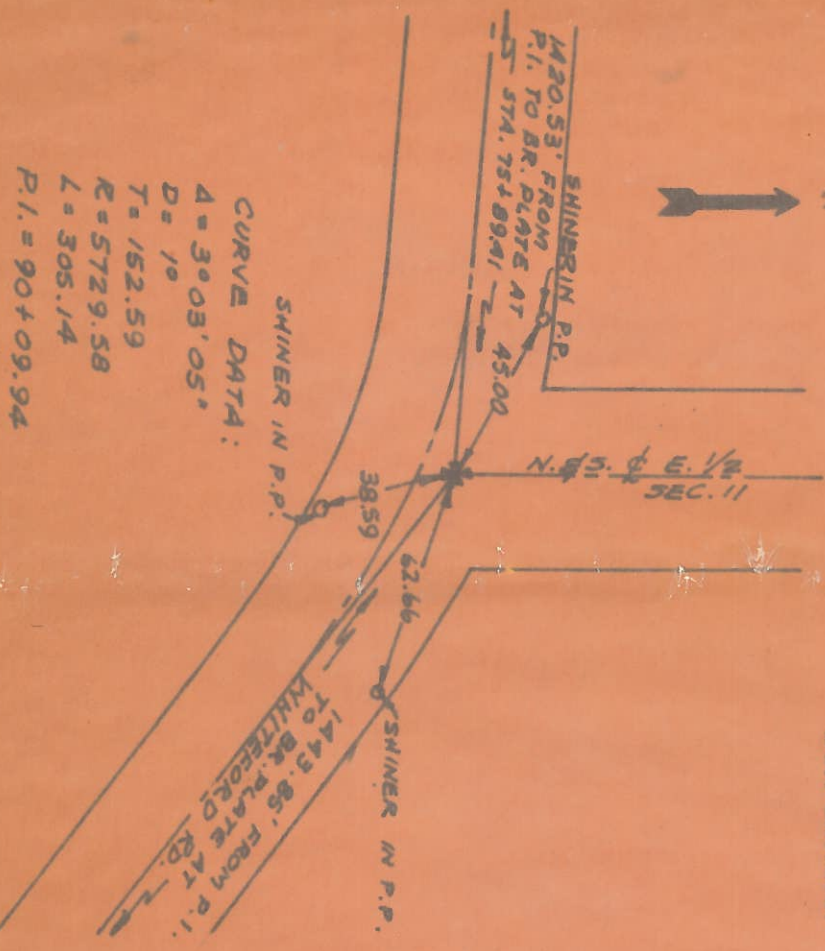


Town 95 Range 6E
 Rd. Corner of Sections 11-12

Kind of Monument BRASS PLATE Remarks FLUSH WITH CONC. SURF. (HOLE IN PLATE) SET WITH MON.

FOUND SET 9-11-37 BY C. BOLLMAN

N. & S. Road WHITEFORD RD. F. B. P.
 E. & W. Road MONROE ST. F. B. P.

2-27-22
 WILSON FD. I.
 PIN
 4-7-36 WILSON
 BRASS PLATE
 12-6-24 WILSON
 FD. I. PIN

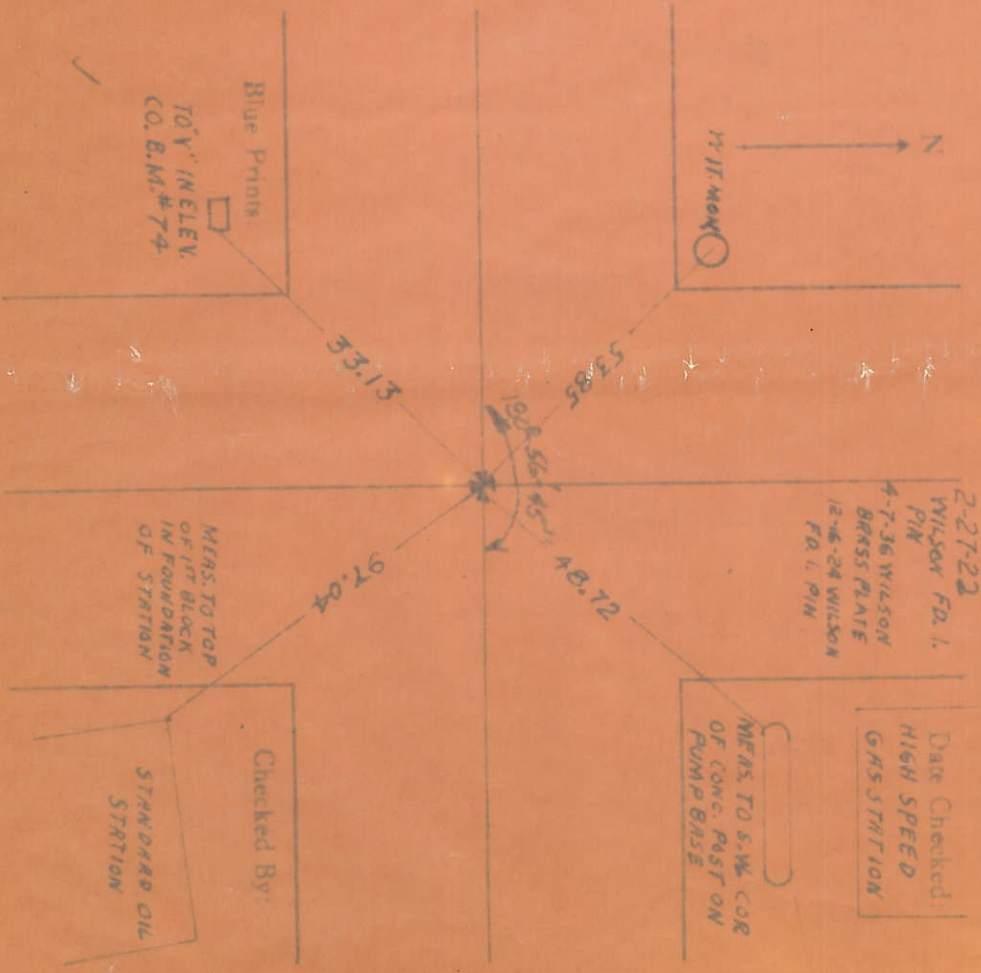

24

25