



PERSONNEL	TITLE	PERSONNEL	TITLE	COUNTY	<u>LUCAS</u>	DATE	<u>25 AUGUST 71</u>
<u>W. DENNO</u>				S. R.	<u>U.S. 223</u>	WEATHER	<u>CLEAR</u>
<u>D. CURTIS</u>				SEC.		TEMP.	<u>70±</u>
<u>D. STEVENS</u>							

DESCRIPTION REFERENCES TO CONTROL POINTS JOB NO. \_\_\_\_\_

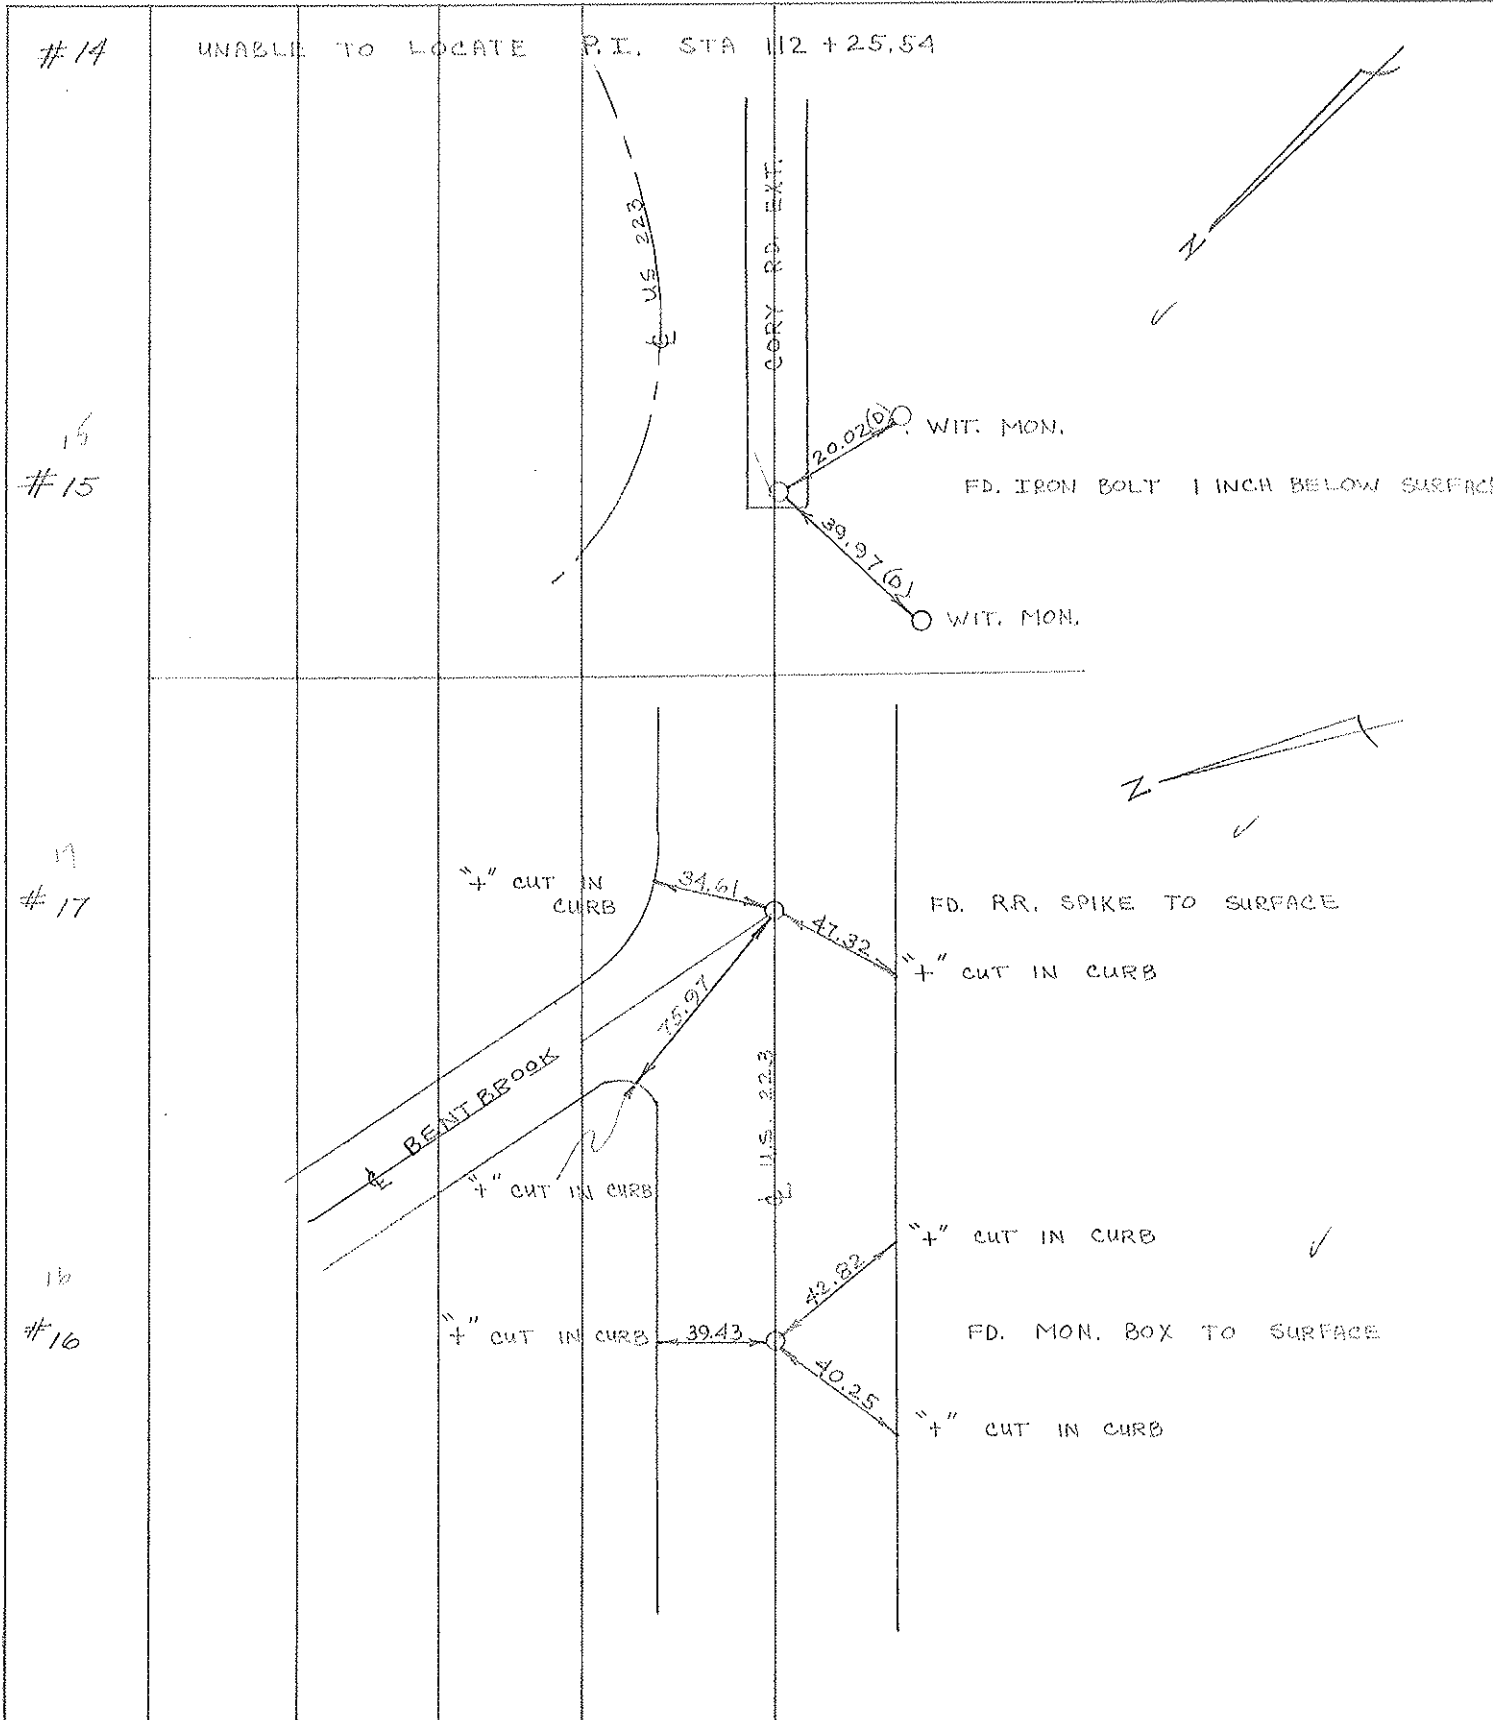

# COMPUTATION SHEET

STATE OF OHIO - DEPARTMENT OF HIGHWAYS - BUREAU OF LOCATION AND DESIGN COLUMBUS, OHIO  
 BY W.B. Denna & Grew DATE June 1, 1966 NO.      OF      SHEETS  
 COUNTY Curtis - Grand - Orney SECTION       
 DIV. NO. 2 S.R.      U.S.R.      I. R.       
 SUBJECT OF THIS SHEET Monument Ref. Monroe St Lucas County

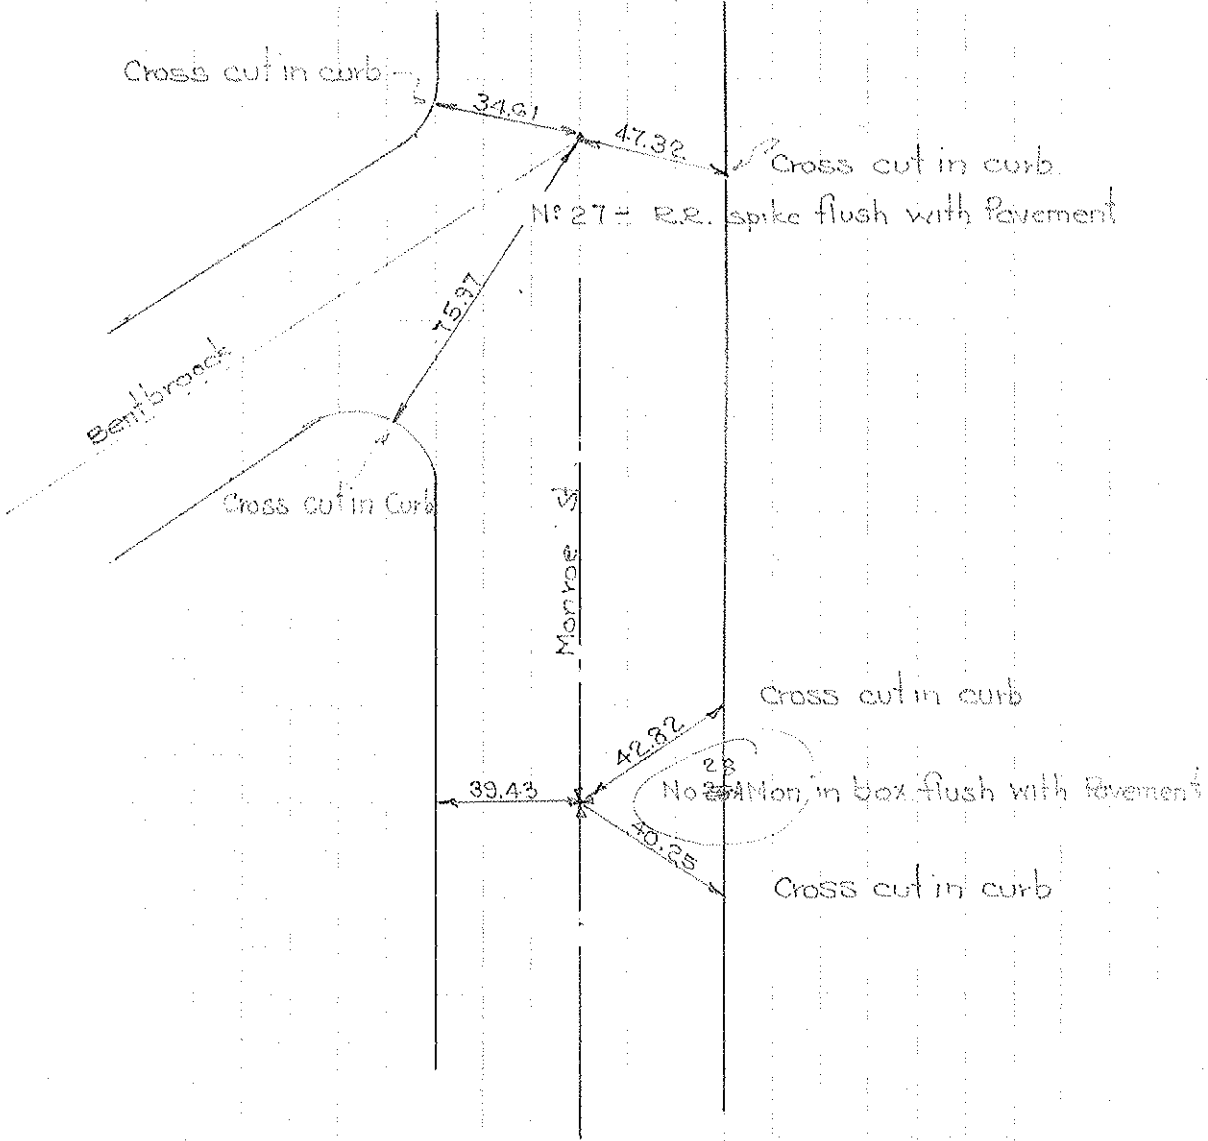

PERSONNEL	TITLE	PERSONNEL	TITLE	COUNTY	DATE	WEATHER	TEMP.
Dennis				Lucas	May 4, 1966	Sunny	50°
Granite				S. R. 223			
Curtis							
Orney				SEC.			

DESCRIPTION Monument Reference 223 Monroe St. JOB NO. \_\_\_\_\_

