

(23)

Town 9-5 Range 6-E

Road Corner of Sections 11

Kind of Monument Brass Plate Remarks

.30 Below Surface (on N15E Sec. 11)

FOUND 1931 BY Wilson

N. & S. Road Sta. 75+89.41 F. B. P.

E. & W. Road Monroe St. F. B. S.M. #12 P.

Date Checked:


As per survey by

Wilson 1931 with

State Highway Found

Brass Plate

N15E Sec. 11  
Sta. 75+89.41

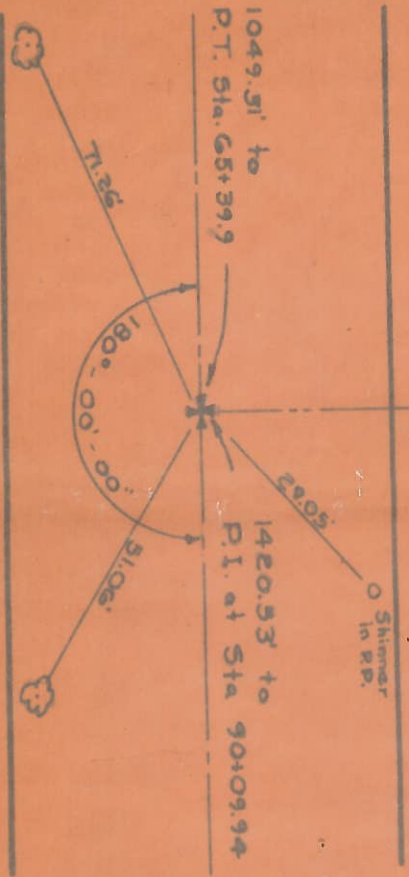

(22)

Town 95 Range 6E

Rd. Corner of Sections 11

Kind of Monument BRASS PLATE

0.30 Below Surface

FOUND 1931 BY WILSON

N. & S. Road COREY RD. STA 63+56.16 F. B. P.

E. & W. Road MONROE F. B. P.

AS PER SURVEY BY

WILSON 1931 WITH STONE

DATE CHECKED:

1937 L.T. OWEN FO. STONE

PC STAKE 463.96

PT STA 63+56.16

PT STA 65+39.90

PT STA 75+89.41

PT STA 63+56.16

PT STA 65+39.90

PT STA 75+89.41

PT STA 63+56.16

PT STA 65+39.90

PT STA 75+89.41

PT STA 63+56.16

PT STA 65+39.90

PT STA 75+89.41

