

County Lucas S.R. 05th 223

Date 10 May 1979

Township Sylvania


Weather Warm

Section 1.00


Temp. 79°

T_N, R_E

Personnel L. Stone
E. Michalak
P. Nooser
D. Curtis
D. Grawley

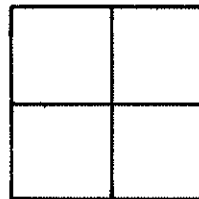


REF. NO. 10

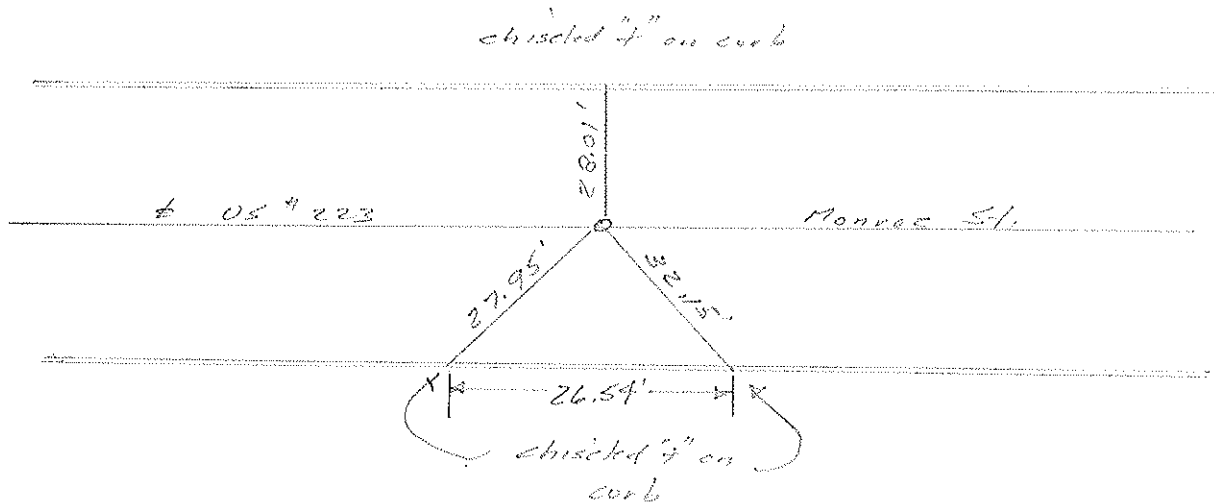

Fd. Mon. Box

PERSONNEL	TITLE	PERSONNEL	TITLE	COUNTY	DATE	WEATHER	TEMP.
<u>W. DENNO</u>				<u>LUCAS</u>	<u>25 AUGUST 71</u>	<u>CLOUDY</u>	<u>60±</u>
<u>D. CURTIS</u>				<u>U.S. 223</u>			
<u>D. STEVENS</u>							

DESCRIPTION REFERENCES TO CONTROL POINTS JOB NO. _____

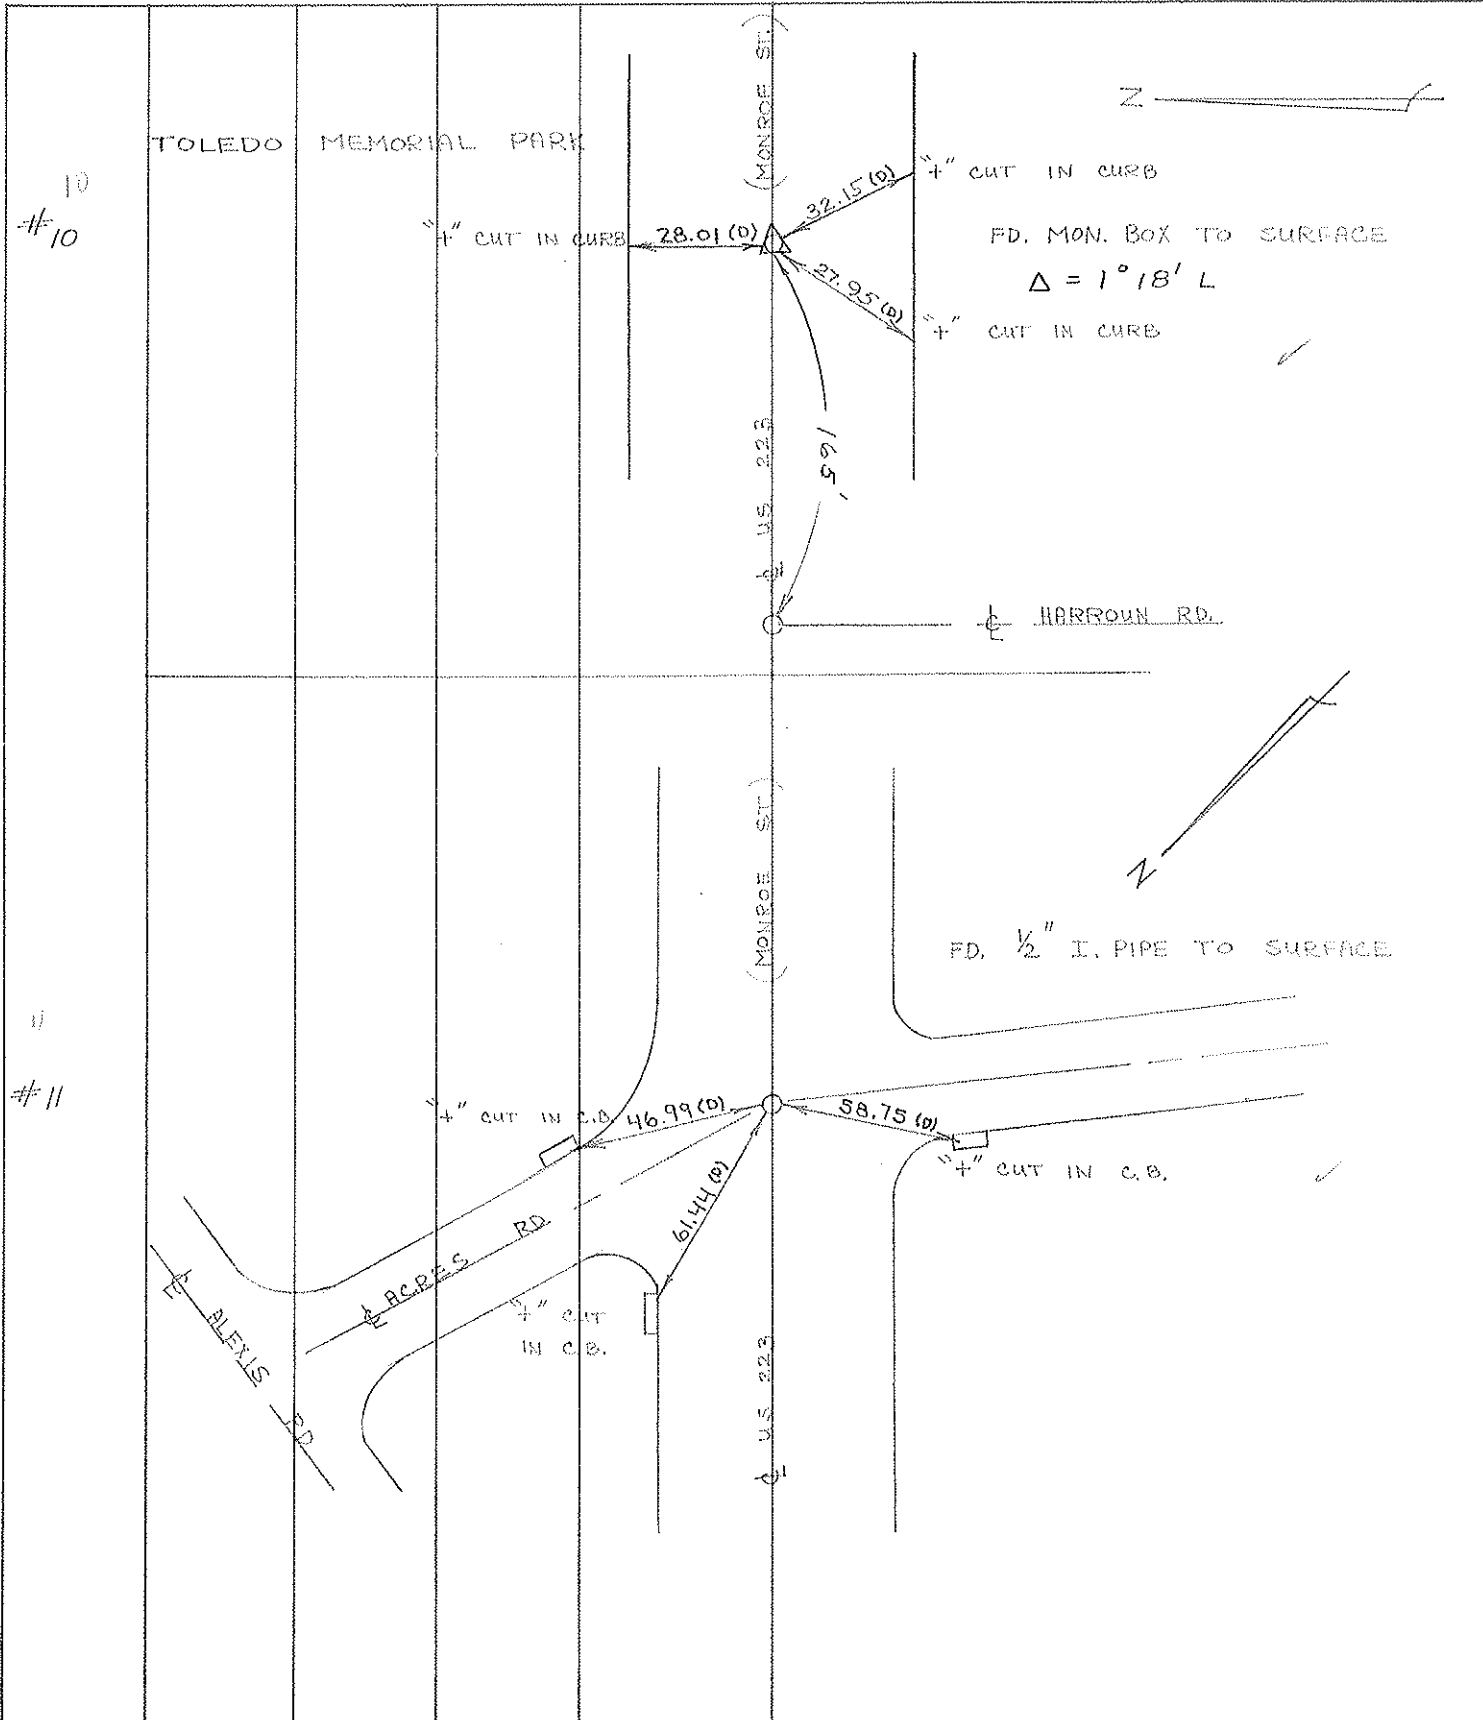

Town 9S Range 6E
 Corner of Sections 10-11

Kind of Monument BRASS PLATE Remarks


.30' BELOW SPK. AT SURFACE

FOUND 1955 BY GALLEMORE

N. & S. Road ACRES Rd. F. B. P.

E. & W. Road MONROE ST. F. B. P.
 AS PER SURVEY BY WILSON 1931 WITH STATE
 FD. 3 BRASS PLATES.

Date Checked:

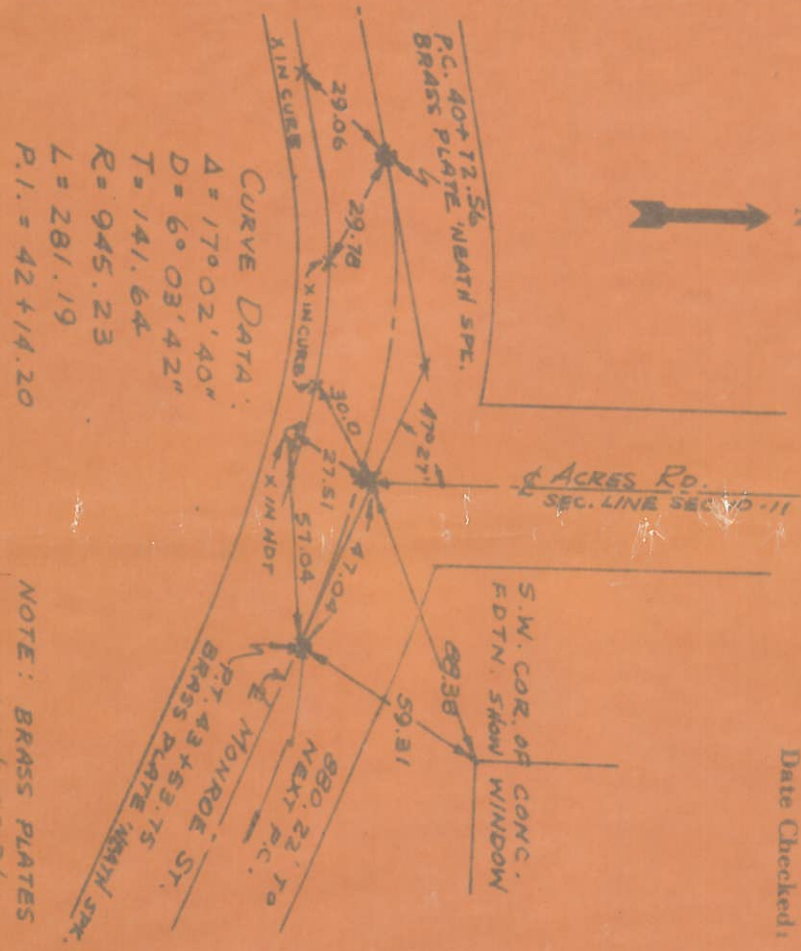

NOTE: BRASS PLATES
 ON ϕ OF R/W
 NOT ON ϕ OF
 PVT.

Town T-9-S Range B-6-E
 Corner of Sections 10-11

Kind of Monument Conc. Man. Remarks At Surface


Replaced old Mon.

~~FOUND~~ 1957 BY GUST

N. & S. Road Acres Rd. F. B. P.

NE 7 SW
~~E. & W. Road~~ Alexis Rd. F. B. P.

Date Checked:

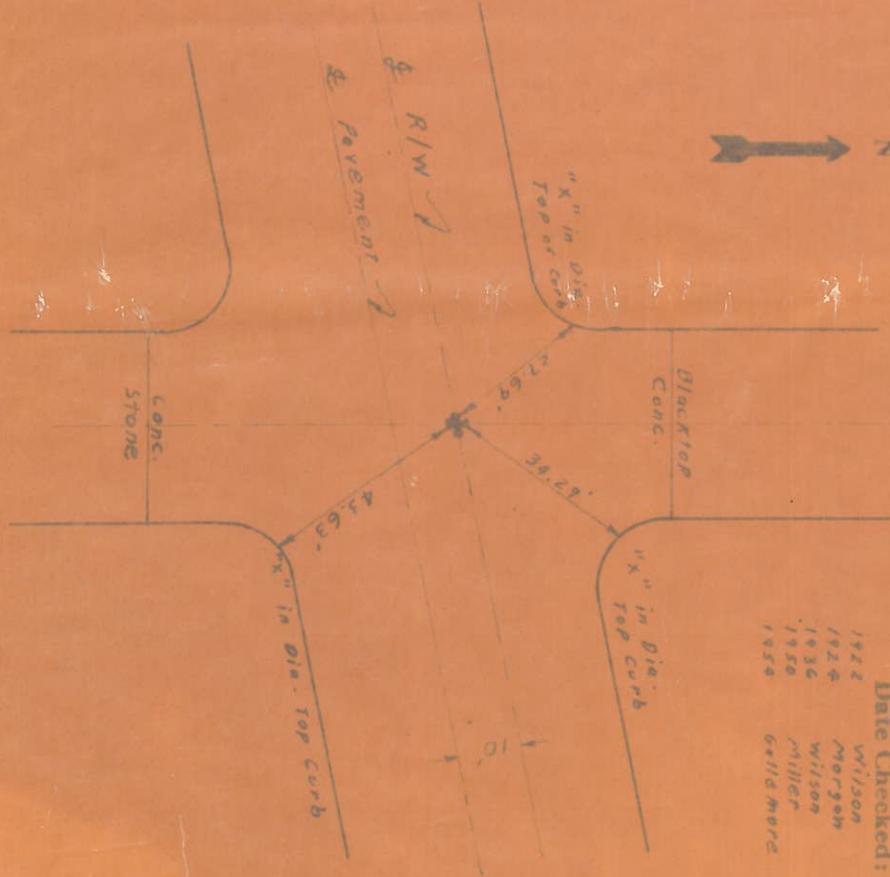

- Date Checked:
- 1922 Wilson
 - 1926 Morgan
 - 1936 Wilson
 - 1950 Miller
 - 1954 Gallemore

