

SHEET NO. 1/4

DATE 3/10/81

COUNTY Lucas

TITLE

PERSONNEL

TITLE

PERSONNEL

WEATHER overcast

S. R. # 67

TEMP. 47°

SEC. 0.43


JOB NO. 025960

DESCRIPTION Topo - Guard Rail

LEFT

CENTER LINE

RIGHT

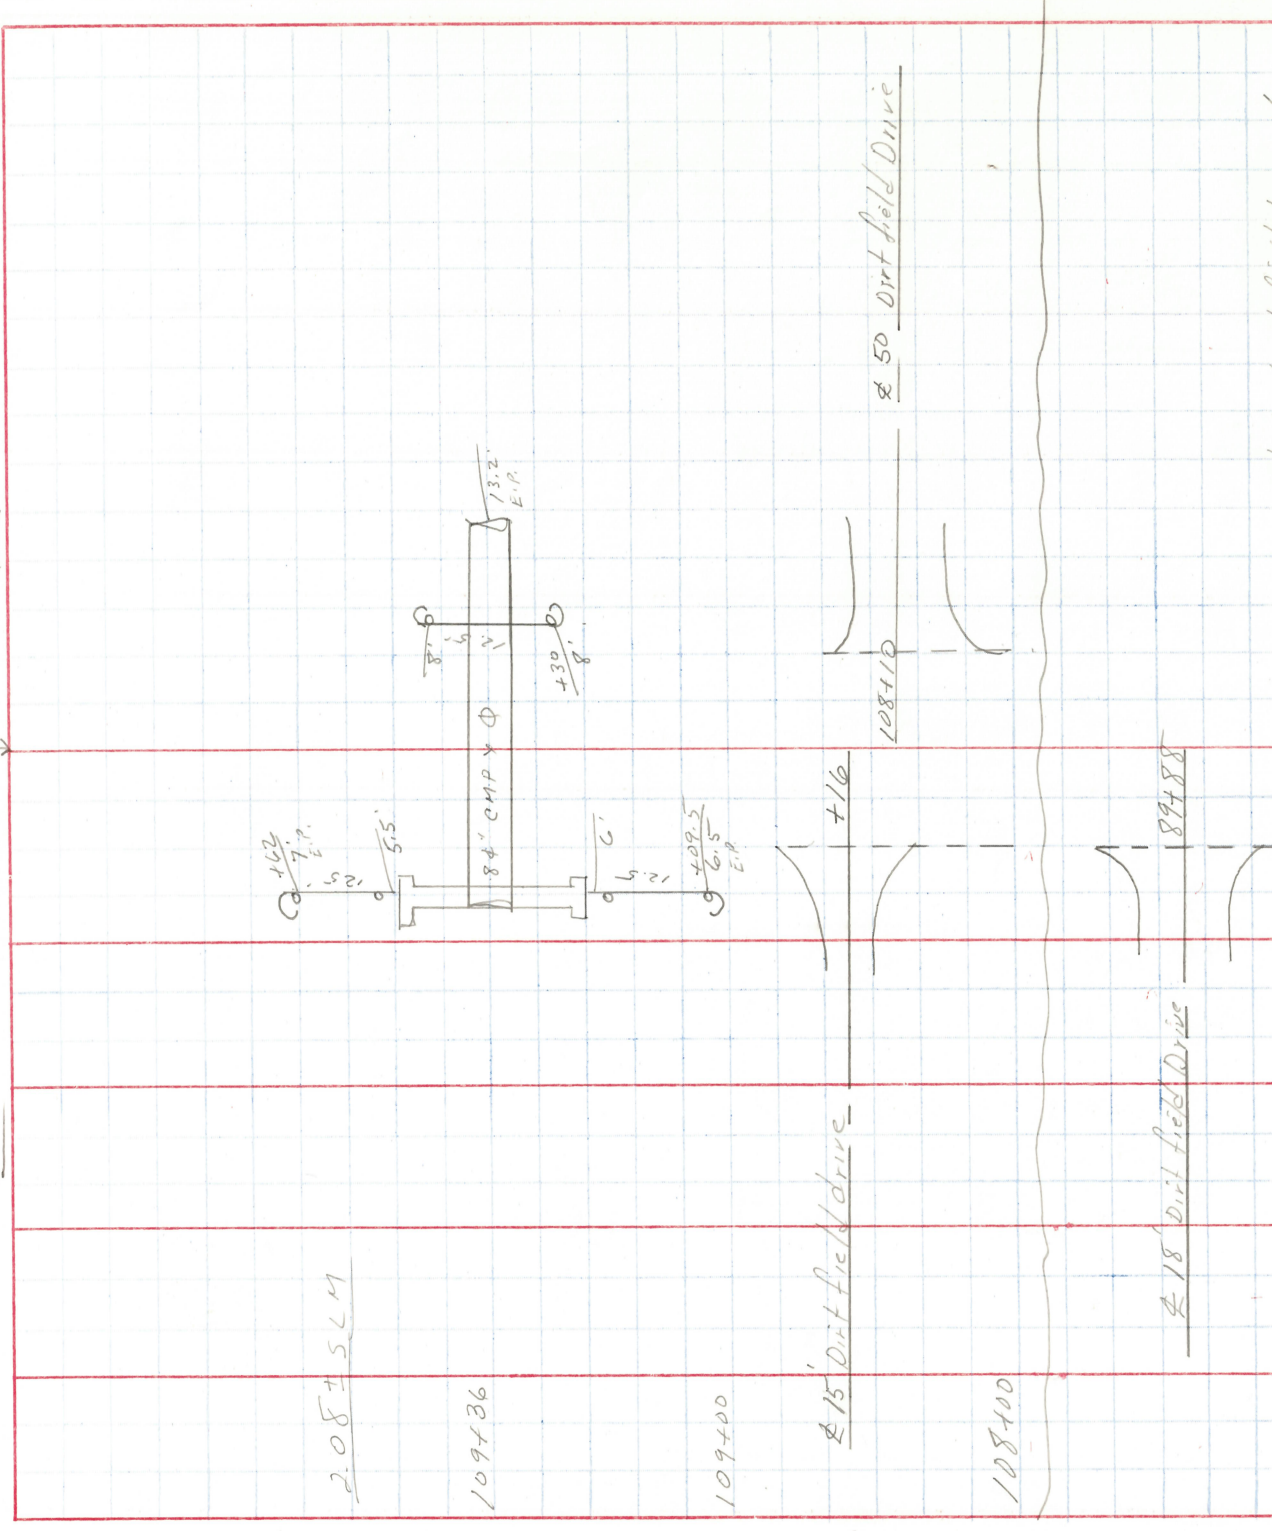

SHEET NO. 2/4

COUNTY Lucas DATE 3/10/81

S. R. # 64 WEATHER OVERCAST

SEC. 0.43 TEMP. 44°

JOB NO. 025960

PERSONNEL

TITLE

PERSONNEL

TITLE

CRONIN

PIPPLE


GEYMAN

DESCRIPTION Topo - Guard Rail

LEFT

CENTER LINE

RIGHT

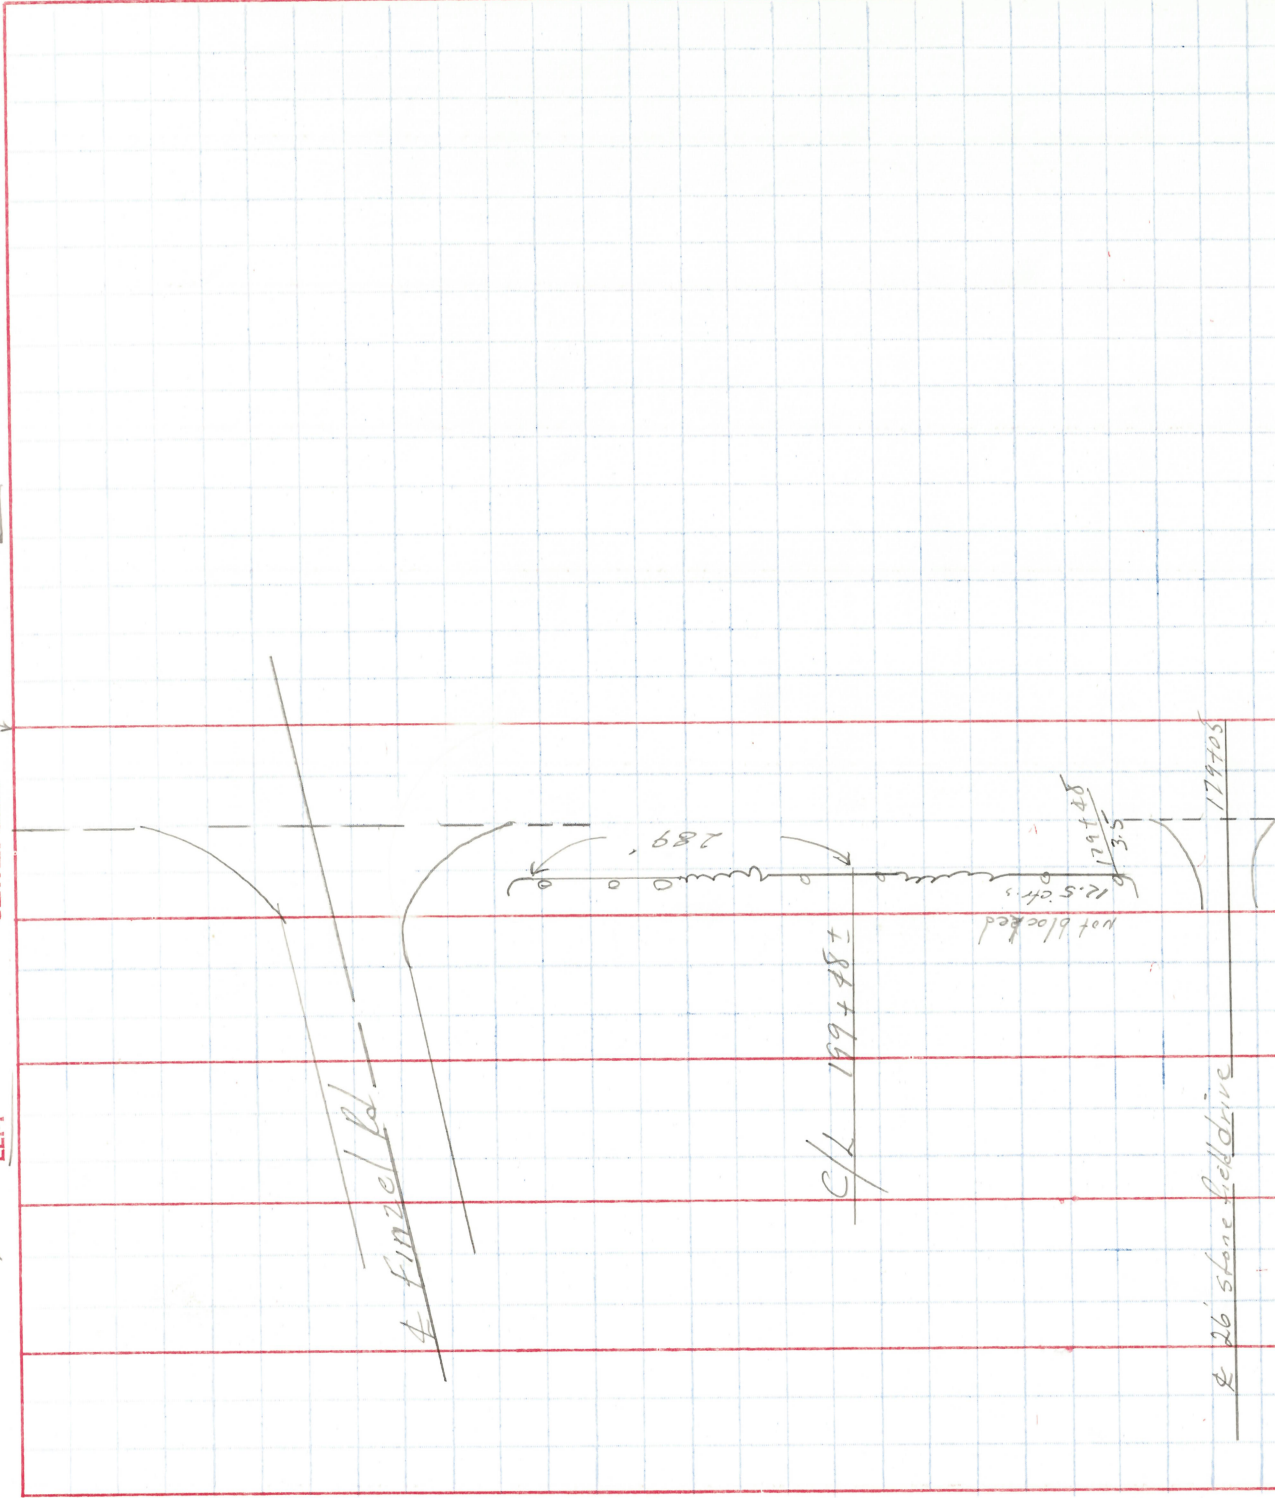

SHEET NO. 2/4
COUNTY LUCAS DATE 3/11/81
PERSONNEL CLAWIN TITLE _____
RIPIE TITLE _____
GEYMAN TITLE _____
S. R. #64 WEATHER cloudy
SEC. 0.43 TEMP. 33°

DESCRIPTION Topo - Guardrail etc. CENTER LINE → RIGHT
LEFT

