

O.D.O.T. DISTRICT 2 SURVEY OFFICE (USE ONLY)

PERSONNEL _____ REFERENCE NO. 1 B SHEET 3 OF 5

NOTES O'DONNELL DATE 12/11/20 ROUTE SR 64
H.C. _____ WEATHER _____ COUNTY LUCAS
R.C. _____ TEMP. _____ TOWNSHIP WATERVILLE

DWG BY RHOADES PID 92088 SECTION RT 36
T 6 N R 10 E

TYPE MONUMENT MONBOX W/1" IPIN

ON SURFACE - ~~BELOW~~ ON _____


OFFSET C PAVEMENT ON _____ LT : RT

- TO - EDGE PAVEMENT


STATION: 7+56.95

HORZ.DATUM: NAD 83 2011 GEOID: 2018

GRID: NORTHING: 670403.211 EASTING: 1635314.308

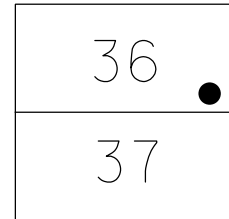

RECORD:
STA. 7+41.15
EXISTING C 64
STA. 7+56.95
RELOCATED C 64
FD MONBOX
W/1" IPIN
NEWSTA756
12/11/20, JFO

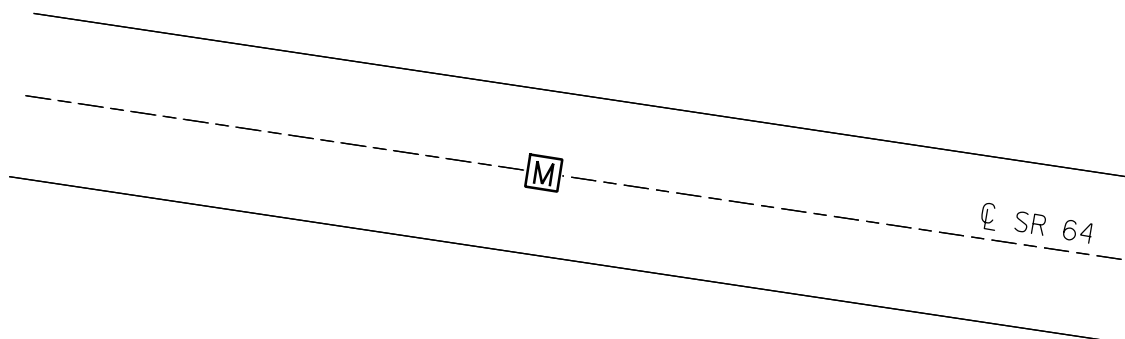

O.D.O.T. DISTRICT 2 SURVEY OFFICE

PERSONNEL

REFERENCE NO. 181A

SHEET 1 OF 47

NOTES ROUSOS

DATE 5-21-02

ROUTE S.R. 64

H.C. HOMAN

WEATHER CLOUDY

COUNTY LUCAS

R.C. MICHALAK

TEMP. 50

TOWNSHIP WATERVILLE

SECTION _____

T___ R___


TYPE MONUMENT SM. R.R. SPIKES

ON SURFACE - ~~BELOW~~ YES

LEFT - Q PAV'T - ~~RIGHT~~ 2.0'

10' TO LT. EDGE PAVEMENT

S.L.M. 219+12

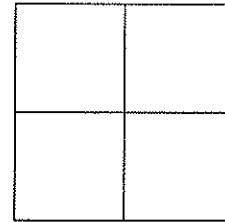

RECORD:
377.52' TO R.R. SPIKE
@ INTERSECTION
FROM P.I. CONST.

SET PK
NAIL &
WASHER
8-7-02
D.C.H.

WATERVILLE

Q PAVT
S.R. 64

Const. P.I.

R/W P.I.

-27.75-

+/- 103.3 (REC.)

WEST ABUTMENT

MAUMEE RIVER

FD N&S
NE/S

49.65'
75.69'

19.69'

19.16'

33.80'

23.05'

24.52'

36.23'

SET N&S
IN 1ST, 3RD
& 6TH GUARD
RAIL POSTS

Resurfaced 2002

O.D.O.T. DISTRICT 2 SURVEY OFFICE

PERSONNEL

REFERENCE NO. 141A

SHEET 1 OF 1

NOTES LOEHRKE

H.C. CURDES

R.C. LOEHRKE

DATE 5-9-97

WEATHER RAIN

TEMP. +52

ROUTE S.R. 64

COUNTY LUCAS

TOWNSHIP WATERVILLE

SECTION _____

T _____ R _____

Set P.K. / WASHERS

TYPE MONUMENT Fd 3m R.R. SPIKES


ON SURFACE - ~~BELOW~~ Yes

LEFT - C PAV'T. - ~~RIGHT~~ R/W 2.0 CONST 12


± 10' TO Lt EDGE PAVEMENT

S.L.M. R/W = 5 + 22.5

5-9-97
Resurfaced
APPROACH
TO BRIDGE

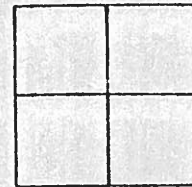

RECORD: CONSTRUCTION P.I. Sta 3+77.50
1946

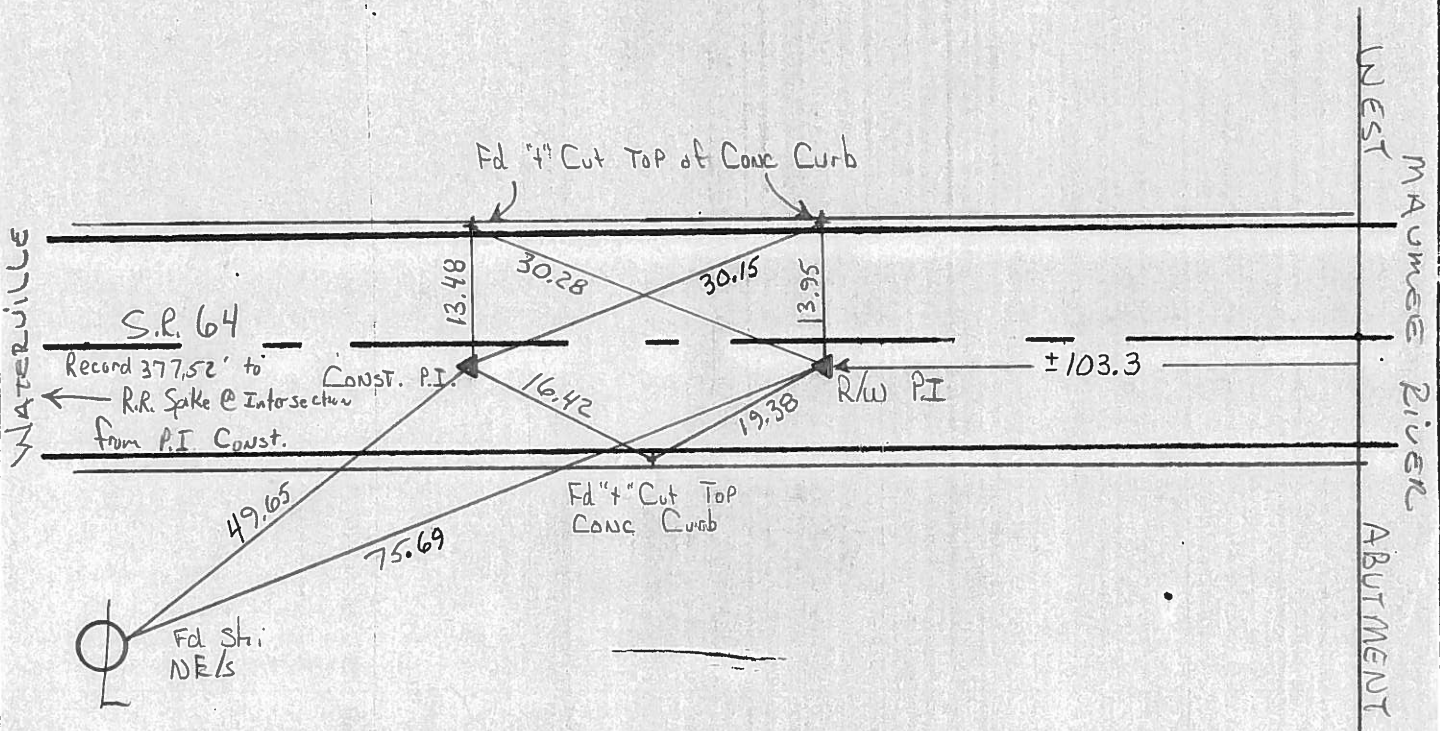

O.D.O.T. DISTRICT 2 SURVEY OFFICE

PERSONNEL _____

REFERENCE NO. 141A

SHEET _____ OF _____

NOTES Hoffman

H.C. LOSHAKS

R.C. BARNHISEL

DATE 7-9-86

WEATHER Lt. Rain

TEMP. 75°

ROUTE 64

COUNTY Lucas

TOWNSHIP Waterwillow

SECTION _____

T _____ R _____

const P.I. / r/w P.I. (Believed to be)


TYPE MONUMENT stail-shiner / small Nail - Fd - set by OTHERS

ON SURFACE - ~~BELOW~~ yes / yes

LEFT- & PAV'T. - ~~RIGHT~~ 1.1' / 1.4'

- TO - EDGE PAVEMENT

S.L.M. _____

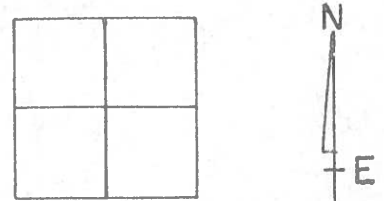

Construction P.I. set by EXTENDING E of construction off of bridge & fitting the distances between face of west Abutment & the R.R. spike control point FOUND @ the intersection of River Road & SR64

1946 stationing for const. P.I. = 3+ 77.50

1986 SLM stationing =

SET SMALL RR SPIKE @ BOTH P.I.'s

10-20-88 SLM

