

O.D.O.T. DISTRICT 2 SURVEY OFFICE

PERSONNEL

NOTES \_\_\_\_\_  
 H.C. \_\_\_\_\_  
 R.C. \_\_\_\_\_  
 \_\_\_\_\_  
 \_\_\_\_\_


REFERENCE NO. 7-A

DATE 5-01-02  
 WEATHER CLOUDY  
 TEMP. 60


SHEET 8 OF 47

ROUTE S.R. 64  
 COUNTY LUCAS  
 TOWNSHIP WATERVILLE  
 SECTION \_\_\_\_\_  
 T \_\_\_ R \_\_\_

TYPE MONUMENT \_\_\_\_\_ SEE DRAWING  
 ON SURFACE - BELOW \_\_\_\_\_ SEE DRAWING  
~~LEFT - C PAVT - RIGHT~~ \_\_\_\_\_ ON  
 \_\_\_\_\_ TO \_\_\_\_\_ EDGE PAVEMENT  
 S.L.M. \_\_\_\_\_ 38+14

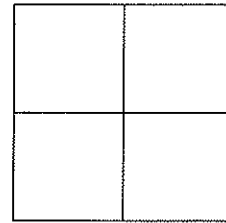

MONUMENT BOX SET

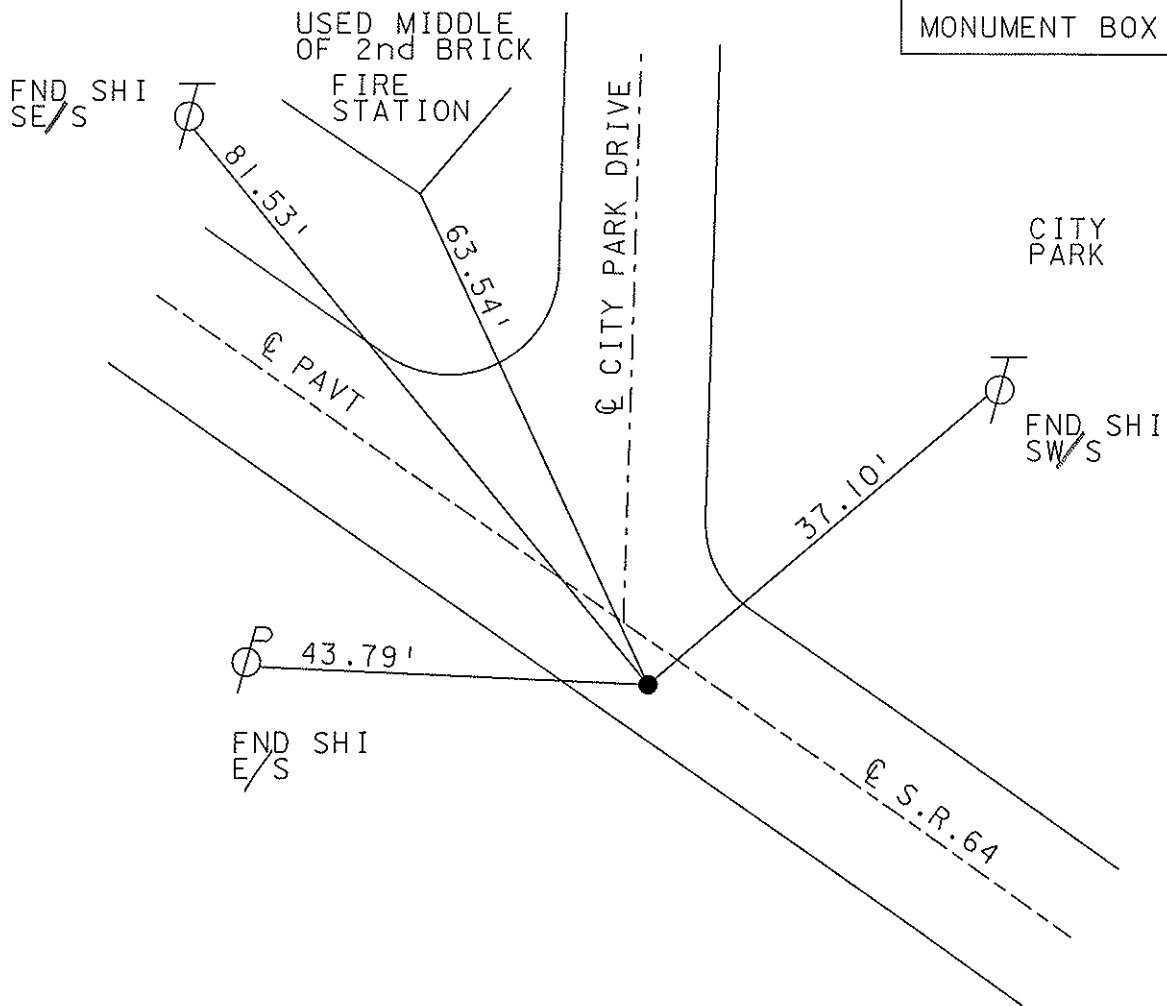

FD PK & WASHER  
 OVER SMALL RR SPIKE 2" DOWN

O.D.O.T. DISTRICT 2 SURVEY OFFICE

PERSONNEL

REFERENCE NO. \_\_\_\_\_

SHEET 8 OF 49

NOTES DEHRKE

H.C. STONE

R.C. CURTIS

DATE 8-14-91

WEATHER CLEAR

TEMP. +77

ROUTE S.R. 64

COUNTY LUCAS

TOWNSHIP WATERVILLE

SECTION \_\_\_\_\_

T \_\_\_\_\_ R \_\_\_\_\_

TYPE MONUMENT sm. RR Spike



set P.K. NAIL  
3-4-92

ON SURFACE - BELOW Yes

LEFT- & PAV'T. - RIGHT 1.2' Lt

TO EDGE PAVEMENT

S.L.M. 38+84

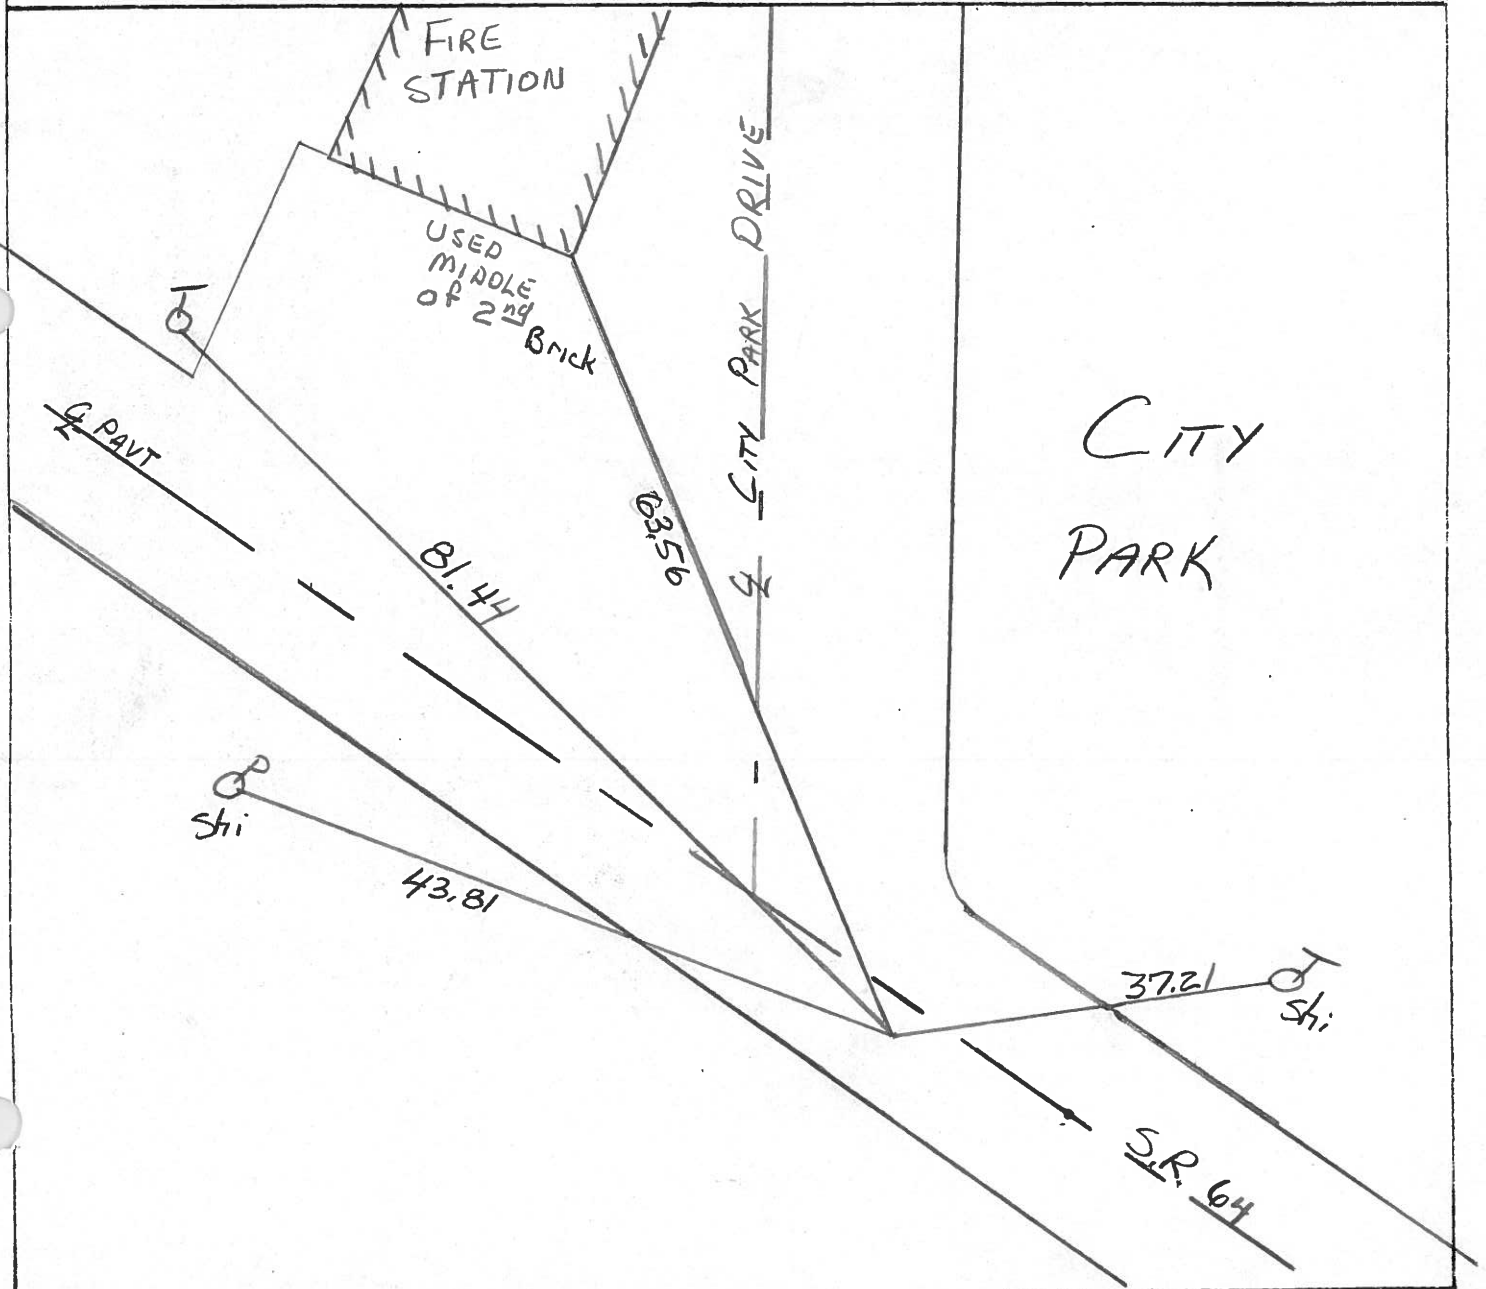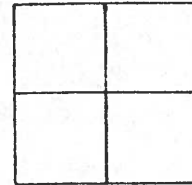

County LUCAS S.R. 64

Date 10-28-81

Township Waterville

Weather Clear

Section \_\_\_\_\_

Temp. +50°

T, N, R, E

Personnel Hoffman


Hauschalter

Loehrke

\_\_\_\_\_

\_\_\_\_\_

IN VILLAGE Limits

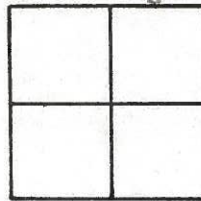

Fd. P.R. SPK/+ @ SURFACE

1.2' S of & PAUT

