

O.D.O.T. DISTRICT 2 SURVEY OFFICE

PERSONNEL

REFERENCE NO. 9-A

SHEET 11 OF 47

NOTES HOMAN

DATE 5-01-02

ROUTE S.R. 64

H.C. ROUSOS

WEATHER CLOUDY

COUNTY LUCAS

R.C. HOMAN

TEMP. 65

TOWNSHIP WATERVILLE

SECTION _____

T ___ R ___


TYPE MONUMENT _____ SEE DRAWING

ON SURFACE - BELOW _____ SEE DRAWING

~~LEFT - C PAV'T - RIGHT~~ _____ ON


_____ TO _____ EDGE PAVEMENT

S.L.M. _____ 61+73


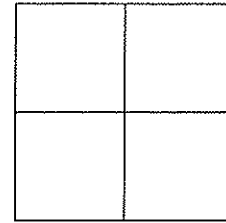


MONUMENT BOX SET

FND, SHI
SE/S

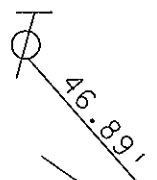

46.89'

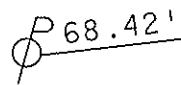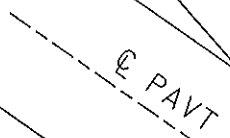

FND SHI
E/S

P 68.42'

FND SHI
E/S



66.93'

C CEDAR LANE

C S.R. 64
MICHIGAN AVE

FD PK & WASHER
OVER RR SPIKE 2" DOWN

O.D.O.T. DISTRICT 2 SURVEY OFFICE

PERSONNEL _____

REFERENCE NO. 9-A

SHEET 11 OF 49

NOTES LOEHRKE

H.C. STONE

R.C. CURTIS

DATE 8-14-91

WEATHER CLEAR

TEMP. +77

ROUTE S.R. 64

COUNTY LUCAS

TOWNSHIP WATERVILLE

SECTION _____

T. _____ R. _____

TYPE MONUMENT P.K. NAIL



Set P.K. Nail
3-4-92

ON SURFACE - ~~BELOW~~ Yes

~~LEFT - & PAV'T.~~ RIGHT Yes

9.5 TO Lt. EDGE PAVEMENT

S.L.M. 61+42

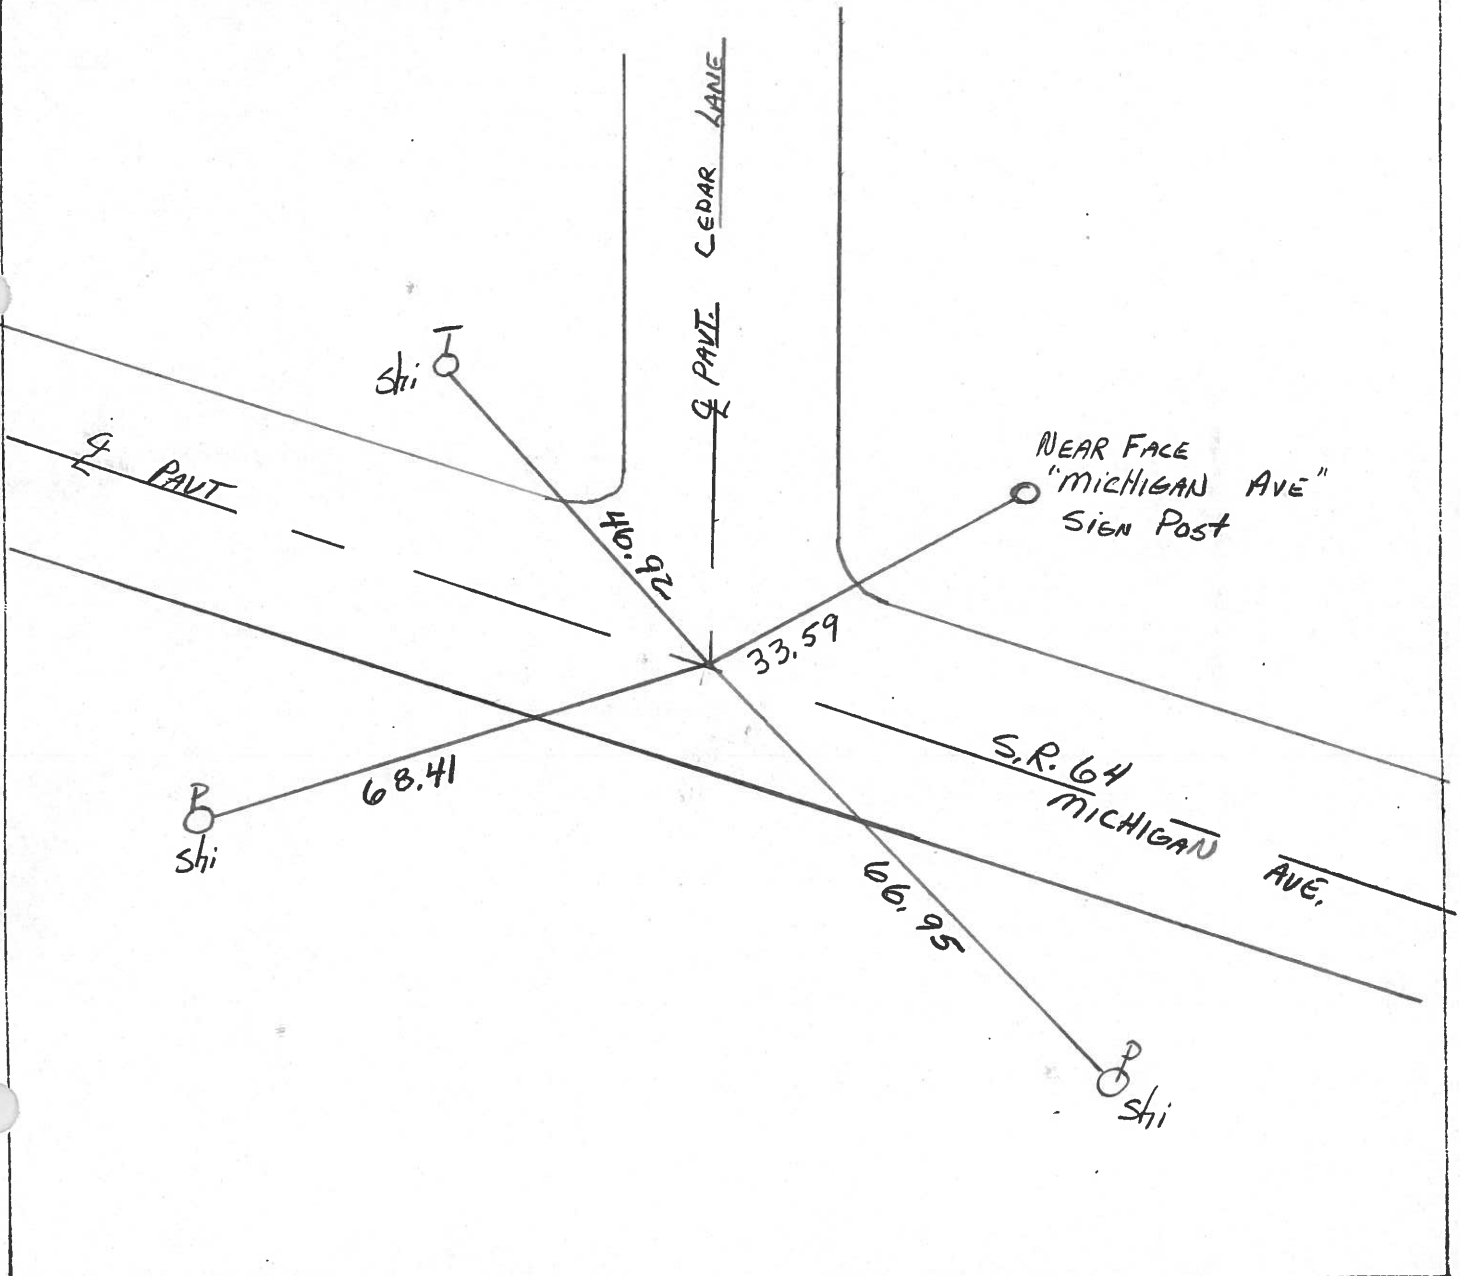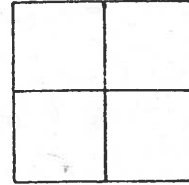

County Lucas S.R. 64

Date 10-28-81

Township Waterville

Weather clear


Section _____

Temp. +50°

T N, R E

Personnel Hoffman

IN village limits

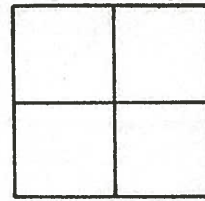

Householder
Loehrke

Fd. l.l. spk/ + @ surface

