



O.D.O.T. DISTRICT 2 SURVEY OFFICE (USE ONLY)

PERSONNEL _____ REFERENCE NO. 17 A SHEET 5 OF 50
 NOTES RHOADES DATE 4-20-18 ROUTE SR 64
 H.C. O'DONNELL WEATHER SUNNY COUNTY LUCAS
 R.C. SEAMAN TEMP. 40° TOWNSHIP WATERVILLE
 _____ SECTION 19
 _____ T 6 N R 10 E

TYPE MONUMENT MAG/WASHER
 ON SURFACE - ~~BELOW~~ ON _____
 LEFT - ~~C PAV'T~~ - RIGHT 2.0'
7.9' TO LT EDGE PAVEMENT
 S.L.M. 141+49.42
 Grid: Northing: 674253.9252 Easting: 1622987.3045

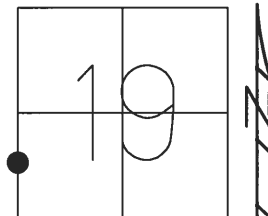

RECORD:
 P.I. $\Delta = 0^\circ 44' 15''$ LT
 SET P.K. NAIL/WASHER
 8-07-02, DCH
 REFA17
 FND P.K./WASHER
 1-15-16, JFO
 SET MAG/WASHER
 4-20-18, JFO

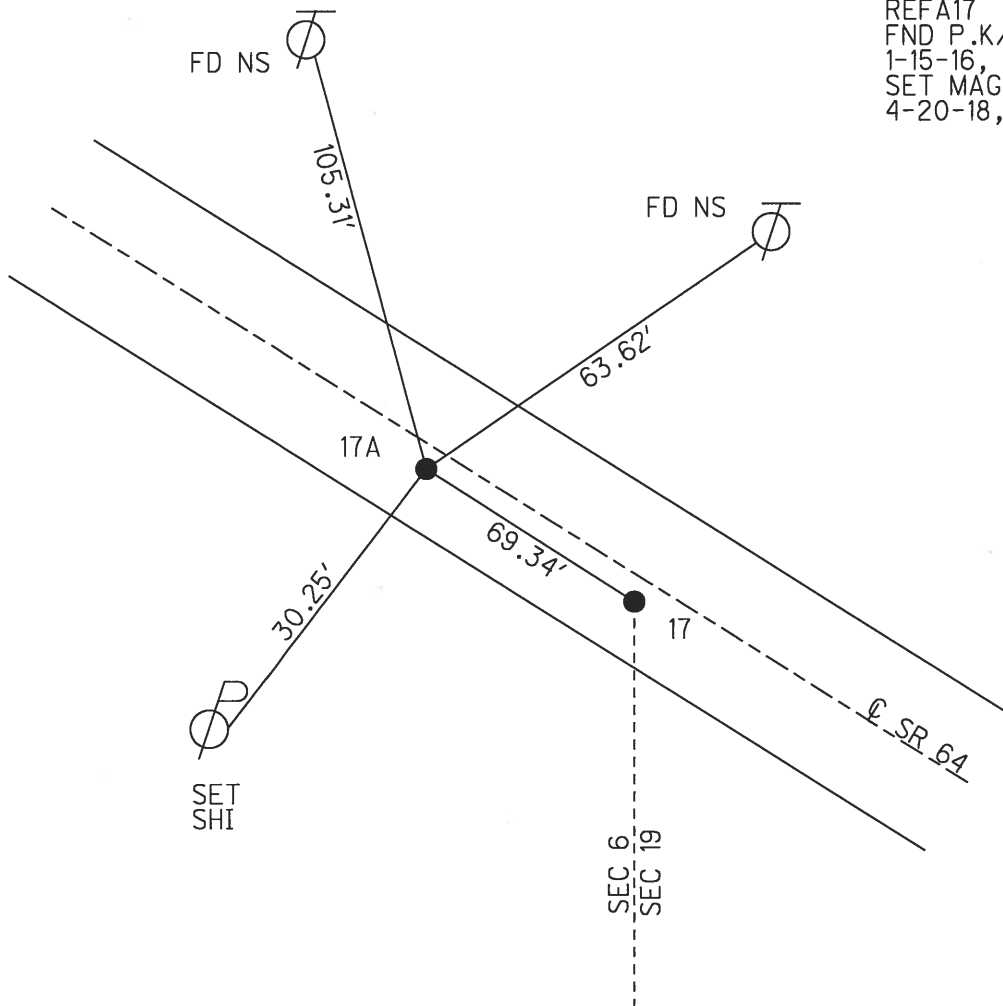

O.D.O.T. DISTRICT 2 SURVEY OFFICE

PERSONNEL

REFERENCE NO. 17

SHEET 19 OF 47

NOTES ROUSOS

DATE 5-20-02

ROUTE S.R. 64

H.C. HOMAN

WEATHER CLOUDY

COUNTY LUCAS

R.C. MICHALAK

TEMP. 48

TOWNSHIP WATERVILLE

SECTION 19

T 6 N R 5 E


TYPE MONUMENT PK NAIL & WASHER

ON SURFACE - ~~BELOW~~ ON

LEFT - ~~Q PAVT - RIGHT~~ 2.0'


7.9' TO LT EDGE PAVEMENT

S.L.M. A=141+13 B=141+82

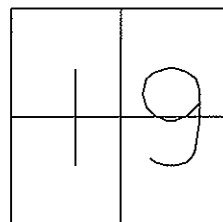

RECORD P.I. "B"
 $\Delta = 0^\circ 44' 15''$ LT

SET PK NAIL'S
 & WASHER'S
 8-07-02
 DCH

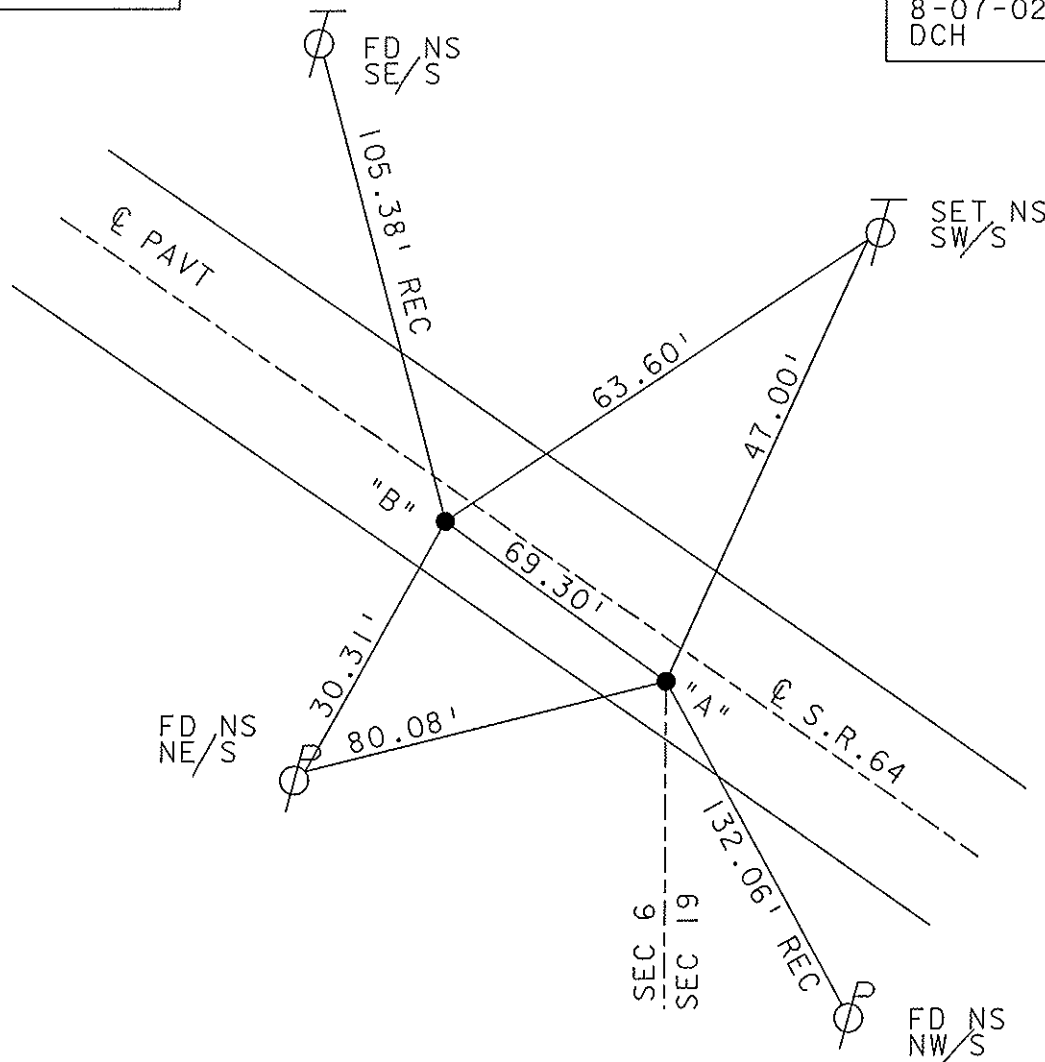

O.D.O.T. DISTRICT 2 SURVEY OFFICE

PERSONNEL

REFERENCE NO. 17



SHEET 19 OF 49

NOTES LOEHRKE
 H.C. STONE
 R.C. CURTIS

DATE 8-12-91
 WEATHER CLEAR
 TEMP. +75

ROUTE S.R. 64
 COUNTY LUCAS
 TOWNSHIP WATERVILLE
 SECTION 19
 T 6 N R 5 E

TYPE MONUMENT Sm. R.R. Spikes . Set P.K. Nails 3-4-92
 ON SURFACE - ~~BELOW~~ Yes
 LEFT - 0 PAV'T. - ~~RIGHT~~ 2.0
7.9 TO Lt EDGE PAVEMENT
 S.L.M. A = 141 + 83 B = 142 + 52

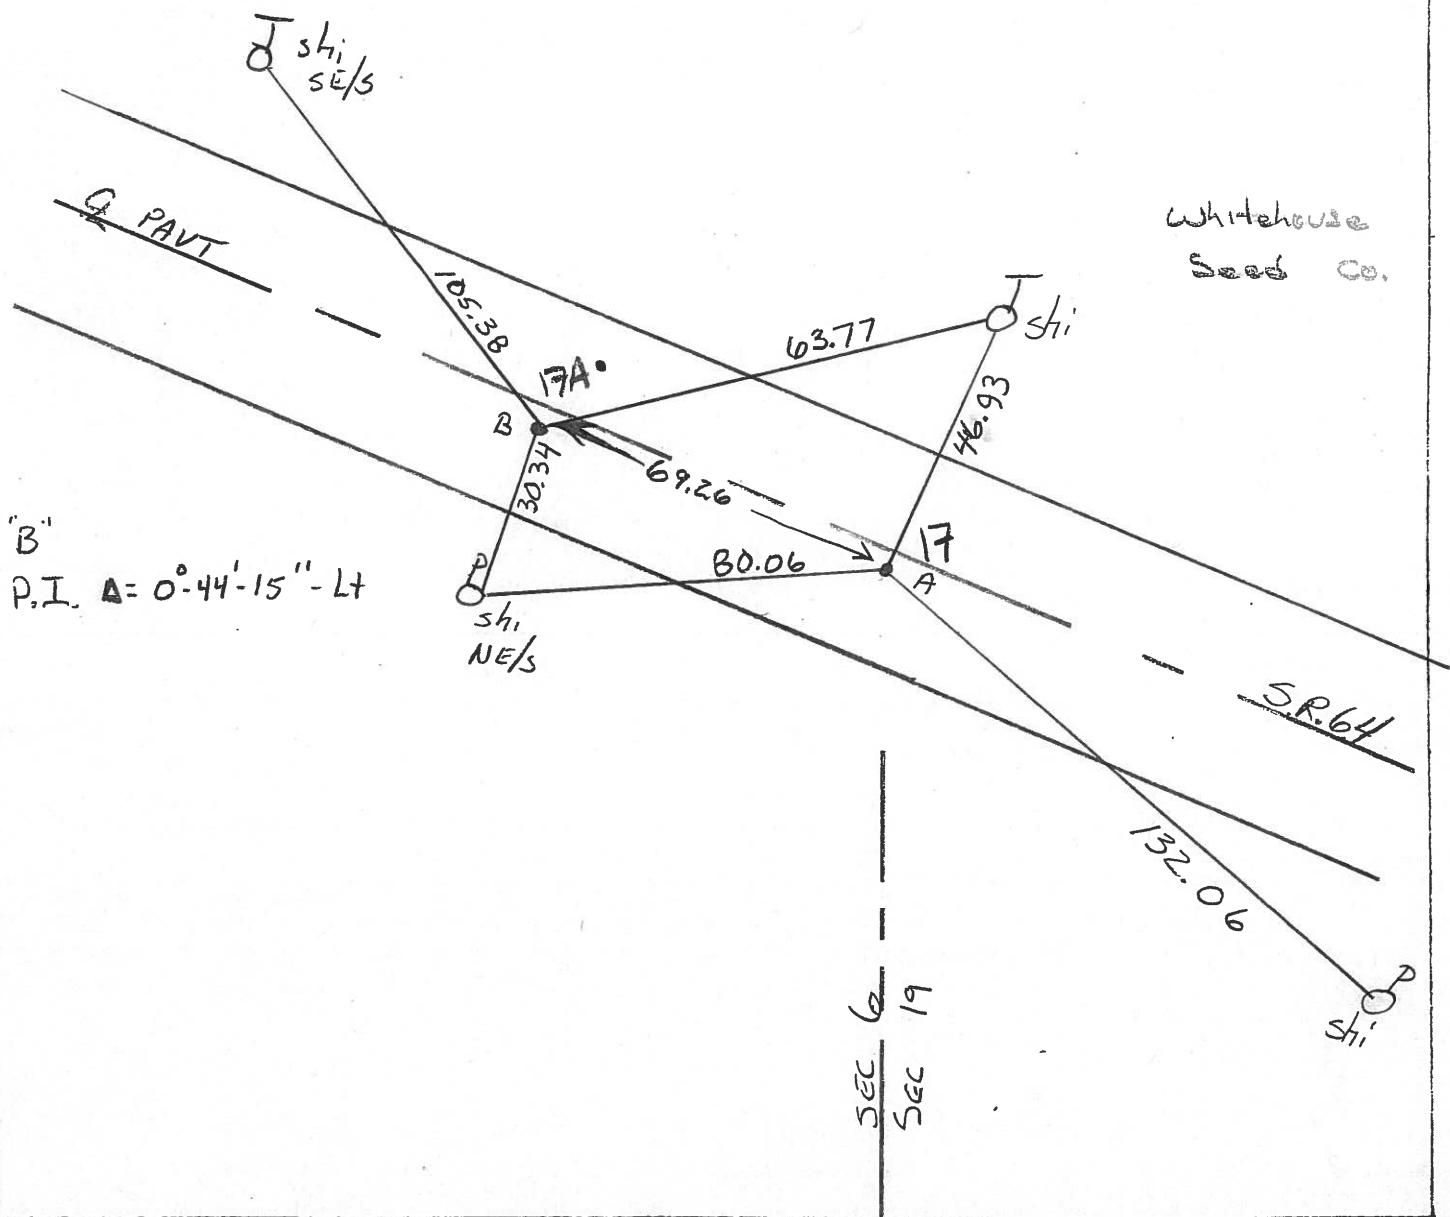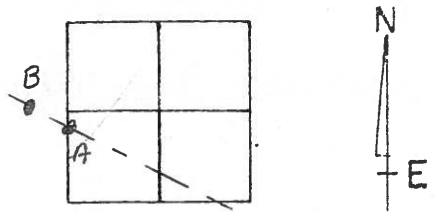

Whitehouse
Seed Co.

County LUCAS S.R. 64

Date 5-21-81

Township WATERVILLE

Weather clear

Section 19

Temp. 77°


T6N, R5E

Personnel S. HOFFMAN

C. Loehrke

L. Householder

#17

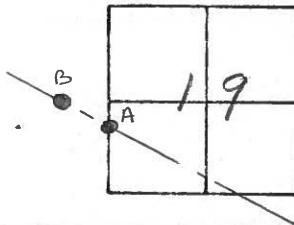

A - FD. R.R. SPK/T

B - FD. R.R. SPK/T

10-28-81

SWN

A = Fd PK NAIL @ SURFACE

12.2' TO N. EDGE PUT


8.0' TO S. EDGE PUT.

B = Fd. R.R. SPK @ SURFACE

11.8' TO N. EDGE PUT.

8.5' TO S. EDGE PUT.

$\Delta = 0^{\circ} - 44' - 15''$ LT. (REC)

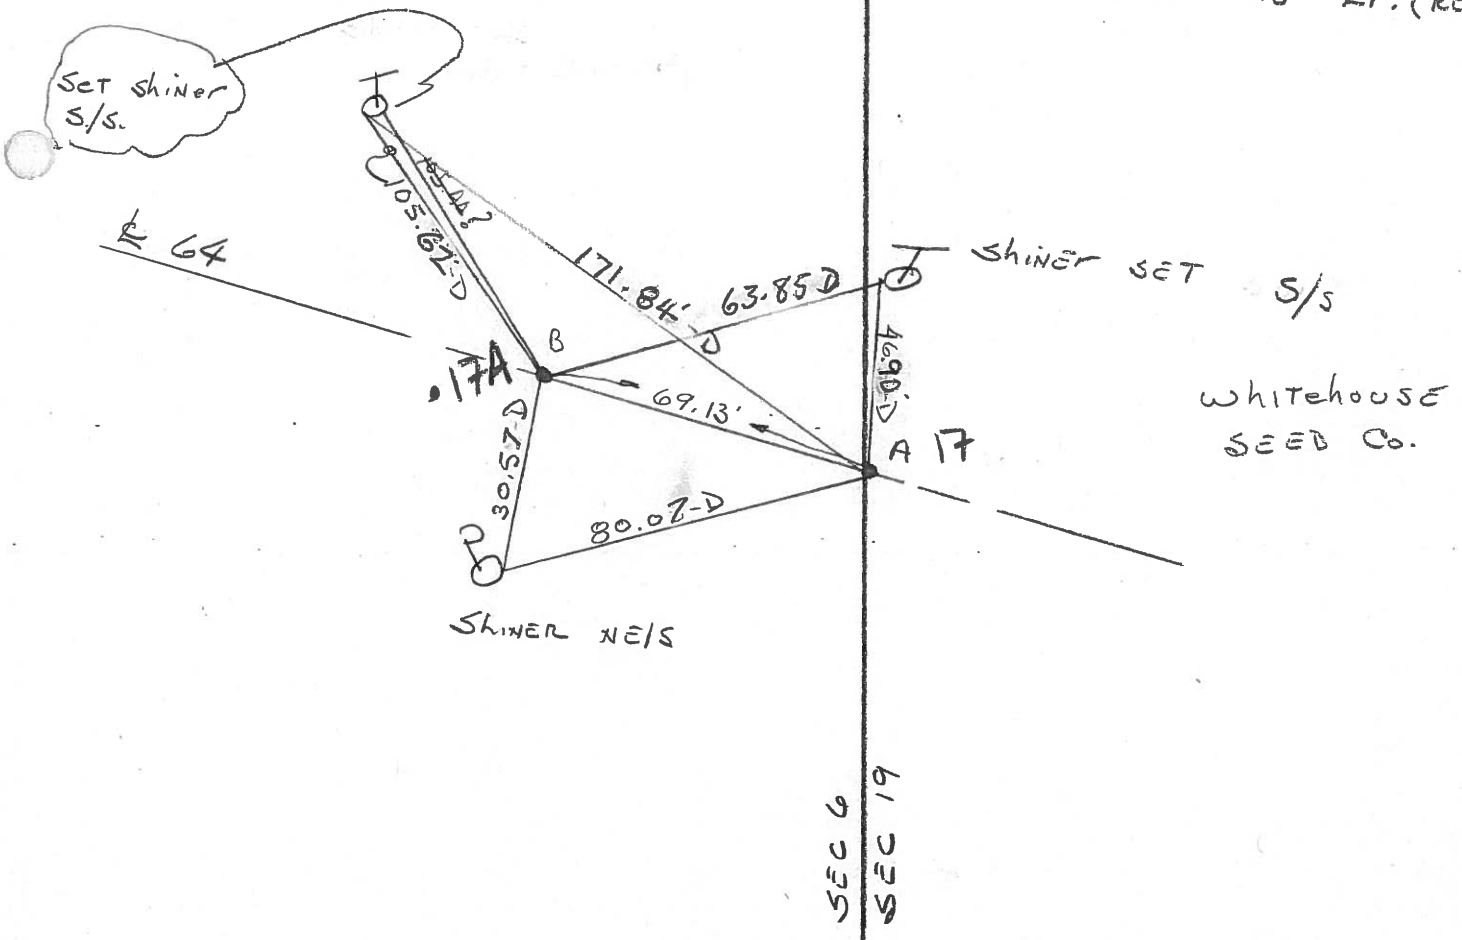

whitehouse SEED Co.

PERSONNEL	TITLE	PERSONNEL	TITLE	COUNTY	DATE	WEATHER	TEMP.
Stone				Lucas	29 March 77	Windy	72°
Crew				S. R. 64			
DESCRIPTION				References to Control Points		JOB NO.	
LEFT		CENTER LINE		RIGHT			

