


O.D.O.T. DISTRICT 2 SURVEY OFFICE (USE ONLY)


PERSONNEL _____ REFERENCE NO. 22 A SHEET 12 OF 50
 NOTES RHOADES DATE 5-21-15 ROUTE SR 64
 H.C. O'DONNELL WEATHER CLOUDY COUNTY LUCAS
 R.C. RHOADES TEMP. 60°F TOWNSHIP WATERVILLE
 _____ SECTION 1
 _____ T 6 N R 9 E

TYPE MONUMENT MAG/WASHER
 ON SURFACE - ~~BELOW~~ ON
 LEFT - ☉ PAV'T - RIGHT ON
_____ TO _____ EDGE PAVEMENT
 S.L.M. 203+25
 Grid: Northing: 676398.2975 Easting: 1617304.9617

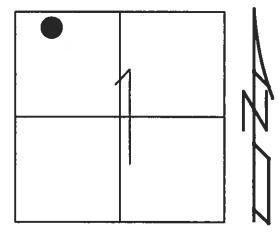

RECORD:
 SET BY OTHERS
 SET MAG/WASHER
 12-12-02, DCH
 FD MAG/WASHER
 REFA22
 5-21-15, JFO

NOTE: NEW ROUND ABOUT CONSTRUCTED
 DIST. REF22 TO REFA22 = 5.75'

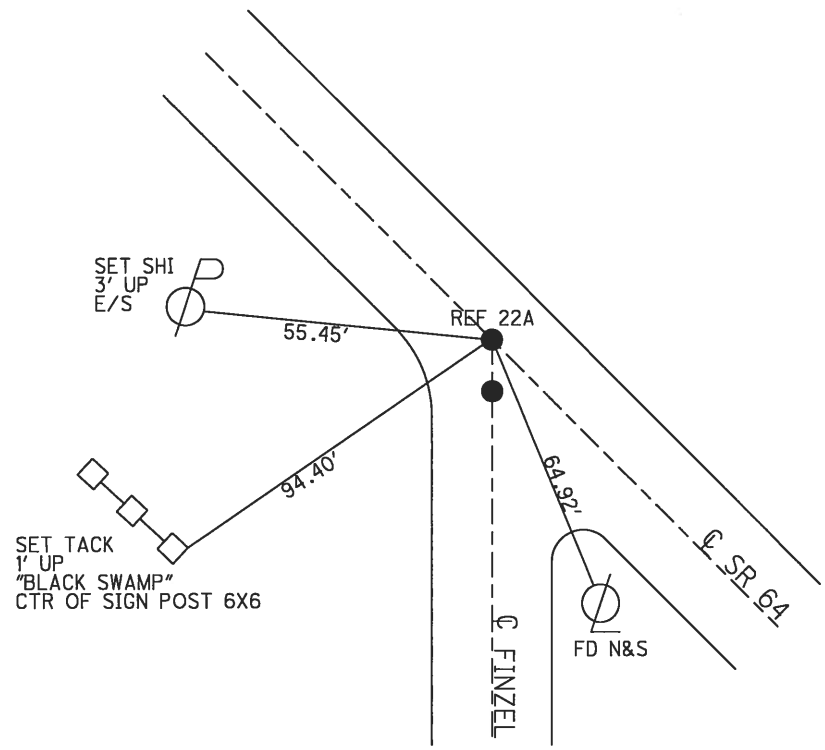

O.D.O.T. DISTRICT 2 SURVEY OFFICE

PERSONNEL

REFERENCE NO. 22

SHEET 25 OF 47

NOTES ROUSOS

DATE 5-20-02

ROUTE S.R. 64

H.C. HOMAN

WEATHER SUNNY

COUNTY LUCAS

R.C. MICHALAK

TEMP. 50

TOWNSHIP WATERVILLE

SECTION _____

T. ___ R. ___


TYPE MONUMENT ^{SMALL} A=RR SPIKE B=PK NAIL

ON SURFACE - ~~BELOW~~ YES _____

LEFT - ~~Q~~ PAVT - ~~RIGHT~~ 6.7' PT.A


_____ TO _____ EDGE PAVEMENT

S.L.M. _____ 203+25 PT.A

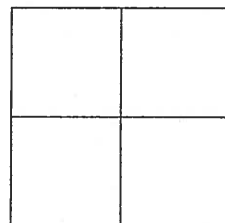

PT. "A" = P.O.T.
PT. "B" = SET BY OTHERS

SET MAG NAIL
& WASHER
12-12-02
DCH

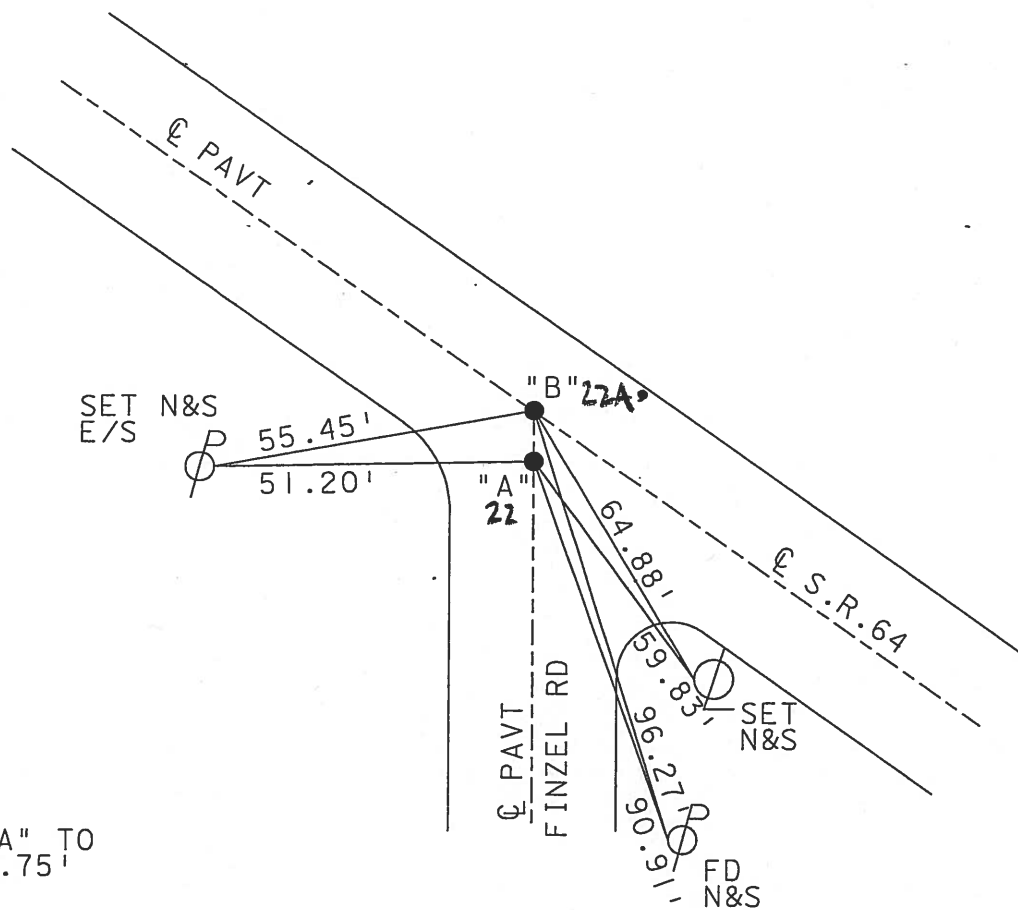

DIST. "A" TO
"B" = 5.75'

O.D.O.T. DISTRICT 2 SURVEY OFFICE

PERSONNEL

REFERENCE NO. 22

SHEET 24 OF 49

NOTES LOEHRKE

H.C. STONE

DATE 8-12-91

ROUTE S.R. 64

R.C. CURTIS

WEATHER Clear

COUNTY LUCAS

TEMP. +75


TOWNSHIP WATERVILLE

SECTION _____

T _____ R _____

TYPE MONUMENT A Sm R.R. Spike B P.K.
 ON SURFACE - BELOW Yes
 LEFT - Q PAV'T. - RIGHT 6.7 P+A
TO EDGE PAVEMENT
 S.L.M. 203+25 - P+A

Set P.K. Nails
3-4-92

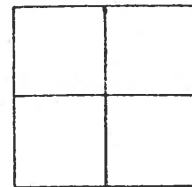

P+"A" = P.O.T.
 P+"B" set by others

5.75' Between

