


O.D.O.T. DISTRICT 2 SURVEY OFFICE (USE ONLY)


PERSONNEL _____ REFERENCE NO. 23 A SHEET 14 OF 50
 NOTES RHOADES DATE 6-16-17 ROUTE SR 64
 H.C. O'DONNELL WEATHER FAIR COUNTY LUCAS
 R.C. CARSON TEMP. 73° TOWNSHIP WATERVILLE
 _____ POORE _____ SECTION 11
 _____ T 6 N R 9 E

TYPE MONUMENT MAG/WASHER
 ON SURFACE - ~~BELOW~~ ON _____
 LEFT - CL PAV'T - ~~RIGHT~~ 1' _____
 _____ TO _____ EDGE PAVEMENT
 S.L.M. 212+61

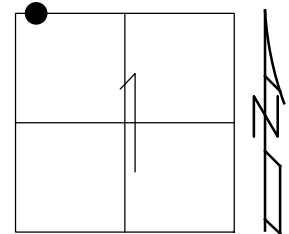

Grid: Northing: 676665.0061 Easting: 1616349.5644

RECORD:
 SET MAG/WASHER
 12-12-02, DCH
 SET MAG/WASHER
 12-4-17

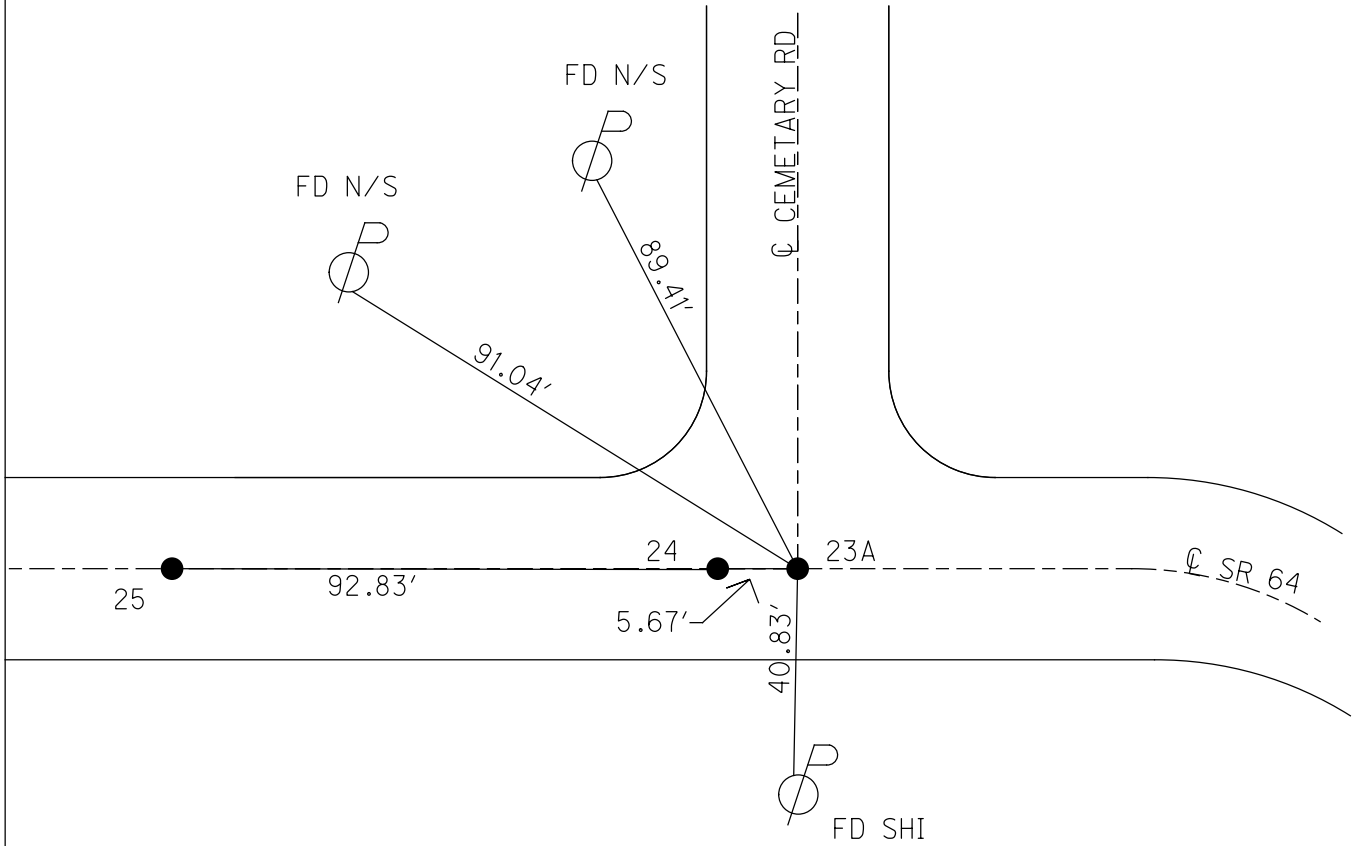

PERSONNEL TITLE PERSONNEL TITLE

COUNTY Lucas DATE July 31, 1960

D. Curtis
J. Teal

S. R. Co4 WEATHER mild

SEC. TEMP. 75°±

DESCRIPTION S.R. Co4 - Ref. Mon. & Control Points JOB NO. 02994(0)

