

O.D.O.T. DISTRICT 2 SURVEY OFFICE (USE ONLY)

PERSONNEL _____

REFERENCE NO. 3 A

SHEET 4 OF 14

NOTES TOMSIK

DATE 8/24/71

ROUTE SR 65

H.C. VANYO

WEATHER FAIR

COUNTY LUCAS

R.C. GRANATA

TEMP. _____

TOWNSHIP 12 MILE RESERVE

JACKSON

SECTION RT 84

DWG BY NIESE

PID _____

T 3 US R E

TYPE MONUMENT P.K. NAIL

ON SURFACE - ~~BELOW~~ ON

OFFSET 0 PAVEMENT ON LT : RT

- TO - EDGE PAVEMENT


STATION: 12+31.26

HORIZ.DATUM: _____

GEOID: _____


GRID: NORTHING: _____

EASTING: _____

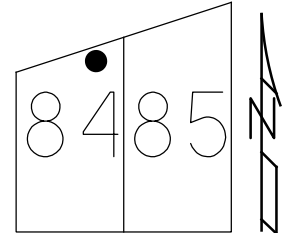

RECORD:
 STA. 12+31.26
 1966 PLANS
 FD P.K. NAIL
 8/24/71, TOMSIK

PUNCH HOLE IN
 CENTER OF EAST BOLT
 OF METAL POLE BASE

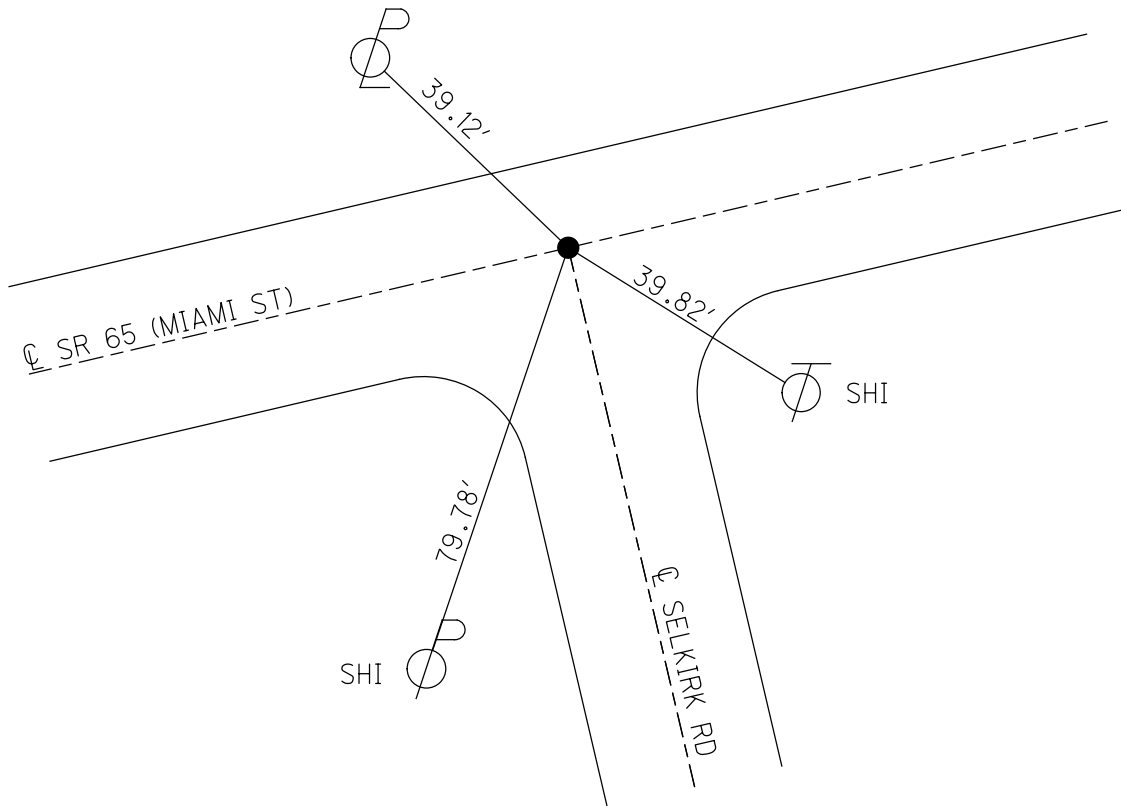

PERSONNEL	TITLE	PERSONNEL	TITLE
Tomsic	_____	_____	_____
Vandy	_____	_____	_____
Granata	_____	_____	_____
Jackson	_____	_____	_____

COUNTY LUCAS DATE Aug. 24, 1971

S. R. #65 WEATHER _____

SEC. _____ TEMP _____

DESCRIPTION Reference Mon. on S.R. #65 JOB NO. _____

