

O.D.O.T. DISTRICT 2 SURVEY OFFICE (USE ONLY)

PERSONNEL _____

REFERENCE NO. 6

SHEET 7 OF 14

NOTES TOMSIK

DATE 8/24/71

ROUTE SR 65

H.C. VANYO

WEATHER FAIR

COUNTY LUCAS

R.C. GRANATA
JACKSON

TEMP. 88°

TOWNSHIP 12 MILE RESERVE

DWG BY NIESE PID _____

SECTION RT 85

T3US RE

TYPE MONUMENT BRASS PLATE

ON SURFACE - ~~BELOW~~ ON


OFFSET ☉ PAVEMENT _____ LT : RT

_____ TO _____ EDGE PAVEMENT


STATION: 52+00.80

HORZ. DATUM: _____ GEOID: _____

GRID: NORTHING: _____ EASTING: _____

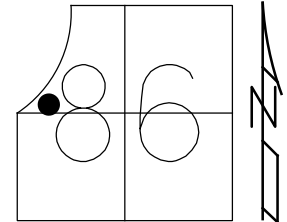

RECORD: P.I.
STA. 52+00.80
 $\Delta = 0^\circ 00' 30''$ RT
FD STONE MON.
1966 PLANS
FD BRASS PLATE
8/24/71, TOMSIK

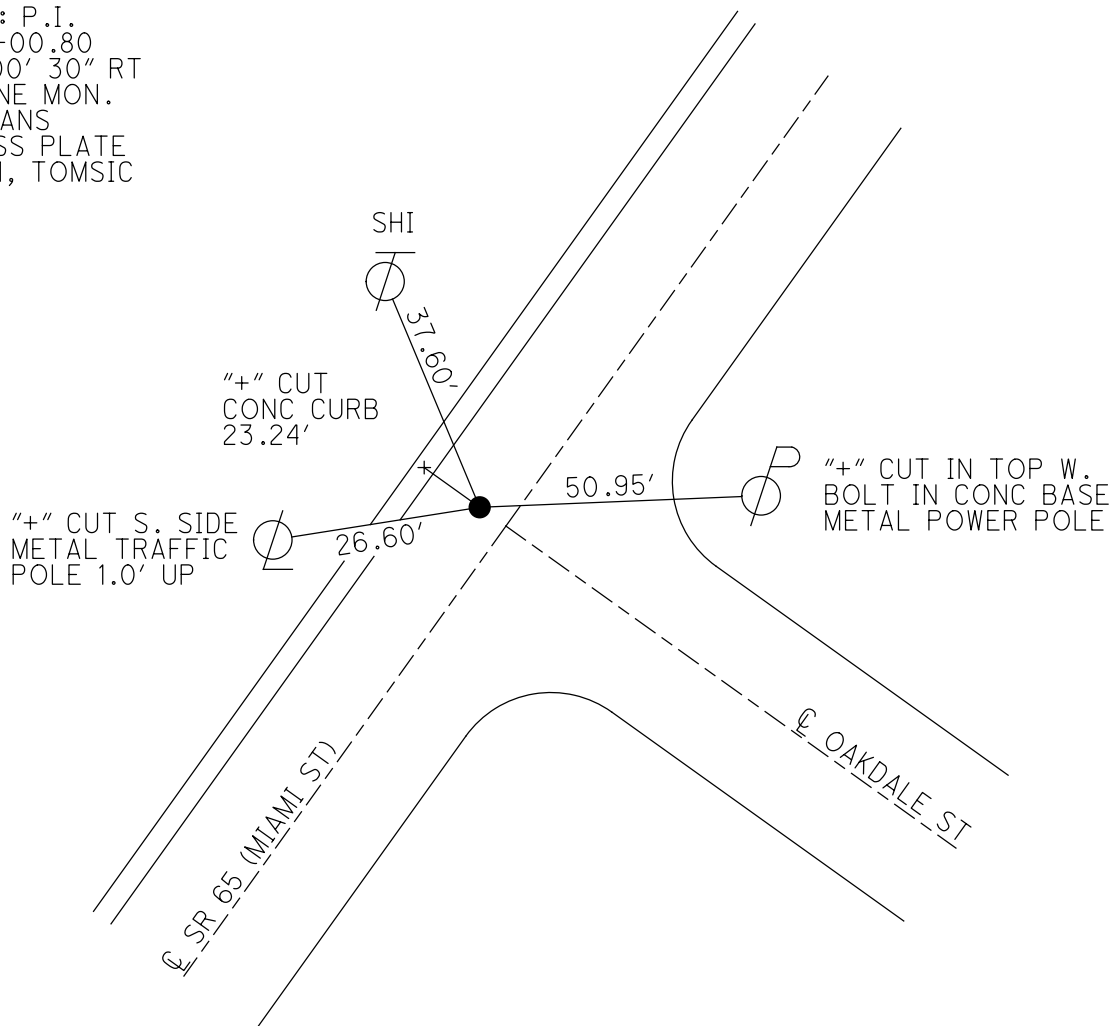

O.D.O.T. DISTRICT 2 SURVEY OFFICE

PERSONNEL _____

REFERENCE NO. 5

SHEET 5 OF 5

NOTES CITY

H.C. OF

R.C. TOLEDO

DATE 1-13-92

WEATHER _____

TEMP. _____

ROUTE 65

COUNTY LUCAS

TOWNSHIP _____

SECTION _____

T. _____ R. _____

TYPE MONUMENT MODURMEN


ON SURFACE - BELOW SURFACE

LEFT- & PAV'T. - RIGHT _____

_____ TO _____ EDGE PAVEMENT

S.L.M. 28+54.73


SLM
0.52

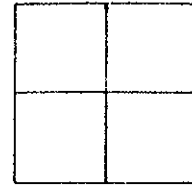

TOLEDO PLAN LUC.-SR-65-000


DRAWN Wm LUCE

Ed. SANDSTONE
MAXIMUM 14 IN
Mud. Box
12-31-96
M.R.C.

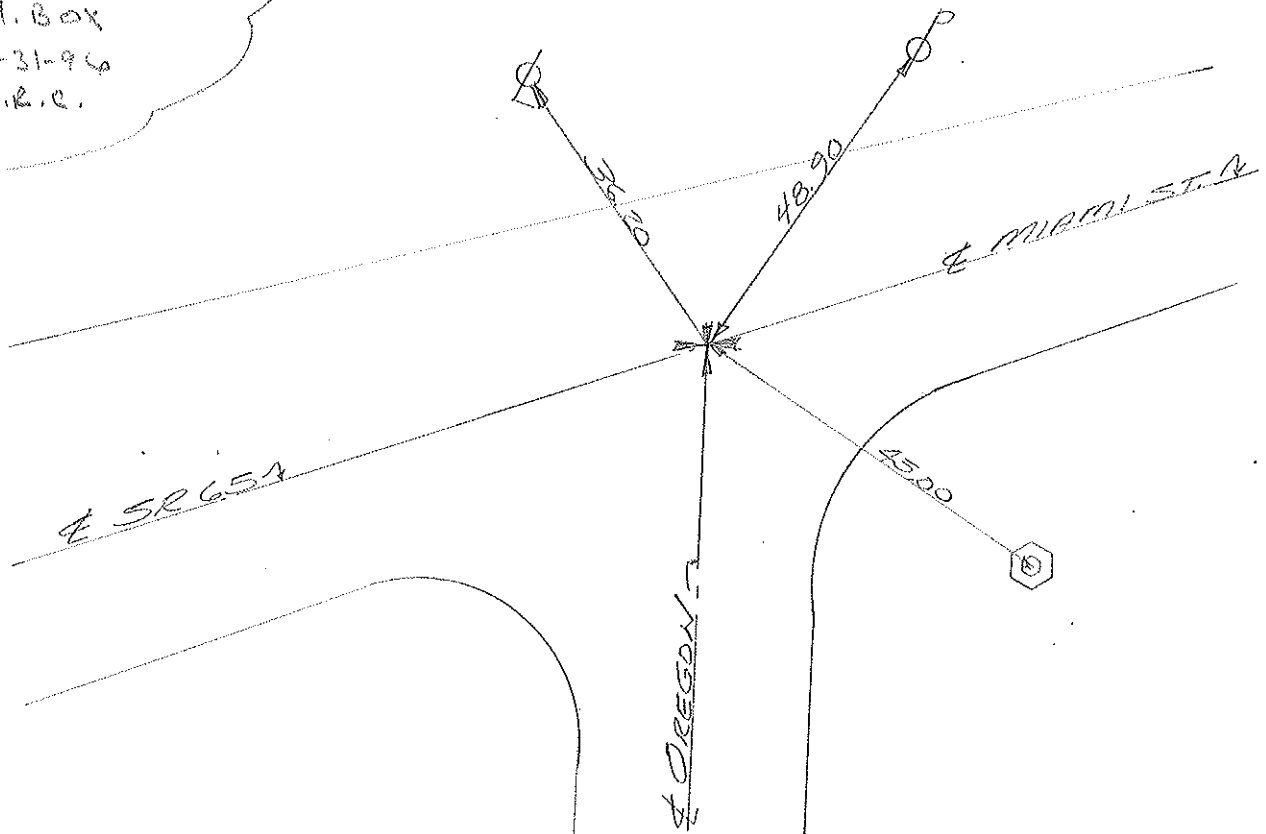

PERSONNEL	TITLE	PERSONNEL	TITLE	COUNTY	DATE
VAN DUSEN				LUCAS	1-7-97
MOSER				S. R. 65	WEATHER CLOUDY
MARK C.				SEC. 0.00	TEMP. +22°F
TED R.					

DESCRIPTION RE-SET P.I. @ STA. 17+92.81 JOB NO. 621039

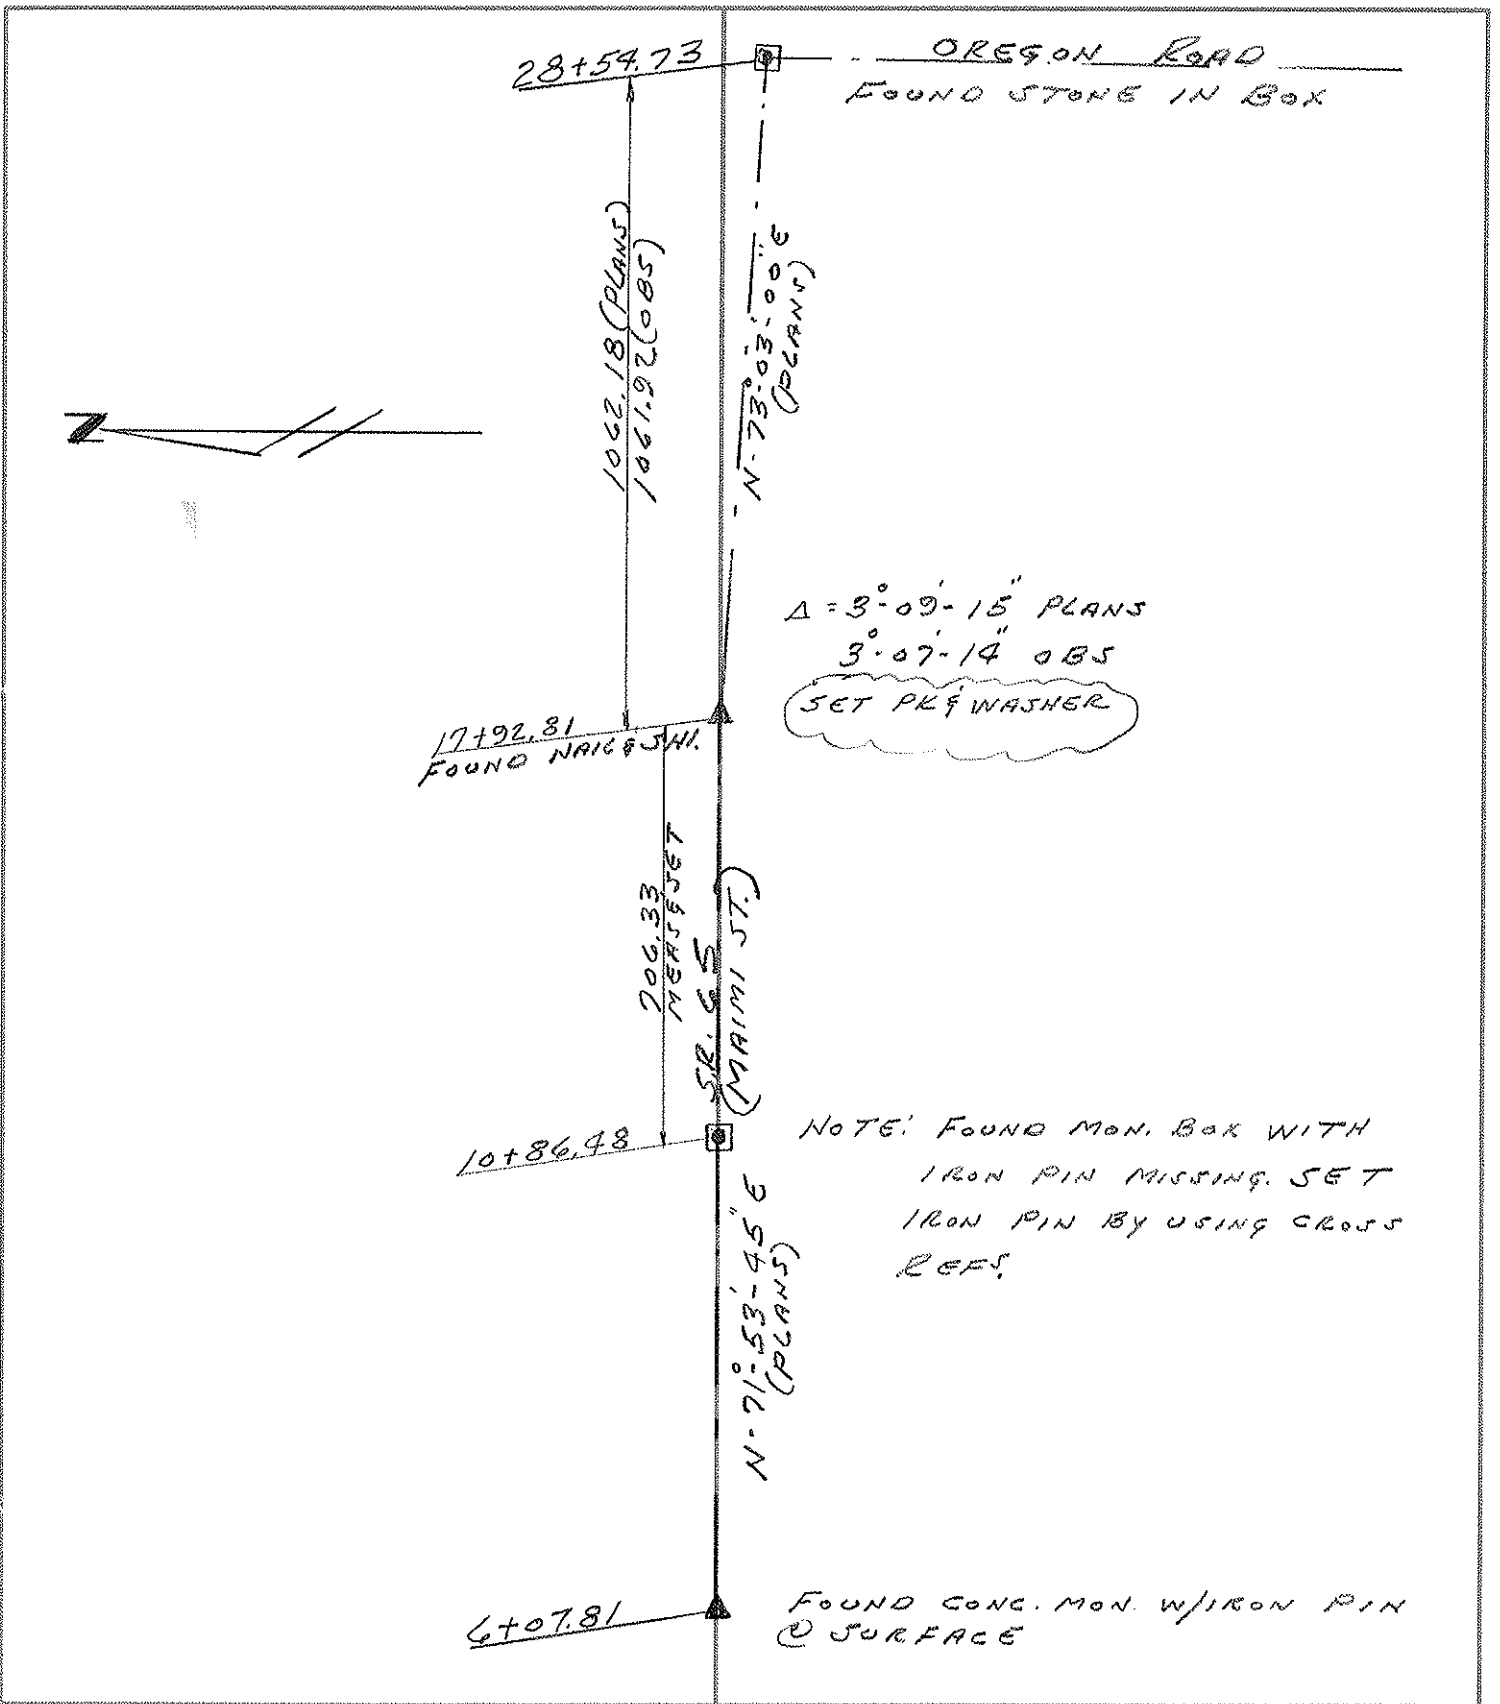

PERSONNEL	TITLE	PERSONNEL	TITLE
Towasic			
Vonyo			
Granata			
Jackson			

COUNTY LUCAS DATE AUG. 24, 1971
 S. R. #65 WEATHER _____
 SEC. _____ TEMP. _____

DESCRIPTION Reference Mon. on S. R. #65 JOB NO. _____
 LEFT CENTER LINE RIGHT

