

O.D.O.T. DISTRICT 2 SURVEY OFFICE (USE ONLY)

PERSONNEL \_\_\_\_\_

REFERENCE NO. 7

SHEET 8 OF 14

NOTES TOMSIK DATE 8/24/71  
 H.C. VANYO WEATHER FAIR  
 R.C. GRANATA TEMP. 88°  
JACKSON

ROUTE SR 65  
 COUNTY LUCAS  
 TOWNSHIP 12 MILE RESERVE  
 SECTION RT 85  
 T 3 US R E

DWG BY NIESE PID \_\_\_\_\_

TYPE MONUMENT BRASS PLATE

ON SURFACE - ~~BELOW~~ ON


OFFSET 0 PAVEMENT \_\_\_\_\_ LT : RT

- TO - EDGE PAVEMENT


STATION: 59+19.65

HORZ. DATUM: \_\_\_\_\_ GEOID: \_\_\_\_\_

GRID: NORTHING: \_\_\_\_\_ EASTING: \_\_\_\_\_

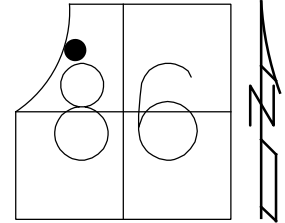

RECORD: P.I.  
 STA. 59+19.65  
 $\Delta = 2^{\circ} 07' 00''$  LT  
 FD STONE MON.  
 1966 PLANS  
 FD BRASS PLATE  
 8/24/71, TOMSIK

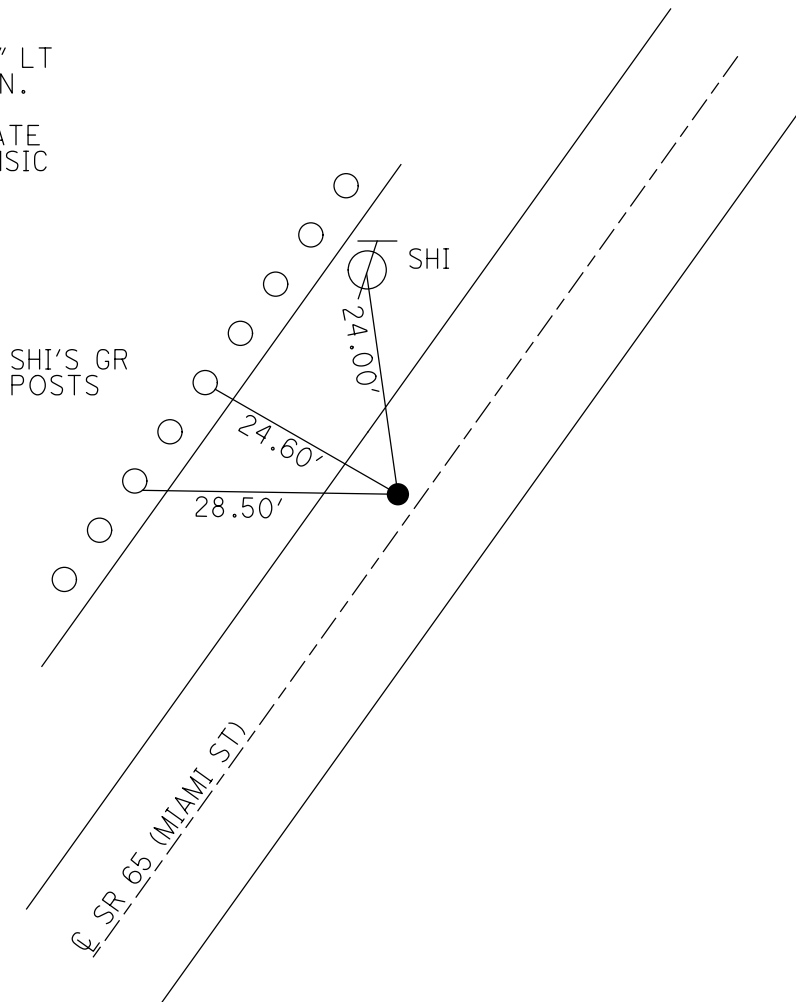

PERSONNEL	TITLE	PERSONNEL	TITLE
Tomsic			
Vanya			
Granata			
Jackson			

COUNTY LUCAS DATE Aug. 24, 1971

S. R. # 65 WEATHER Fair

SEC. \_\_\_\_\_ TEMP 85°

DESCRIPTION Reference Mon. on S.R. # 65 JOB NO. \_\_\_\_\_

