

O.D.O.T. DISTRICT 2 SURVEY OFFICE (USE ONLY)

PERSONNEL

REFERENCE NO. 9 A

SHEET 11 OF 14

NOTES JUHASZ

DATE 10/26/77

ROUTE SR 65

H.C. SZOLLOZI

WEATHER _____

COUNTY LUCAS

R.C. WILLIAMS

TEMP. _____

TOWNSHIP 12 MILE RESERVE

DWG BY NIESE PID _____

SECTION RT 87

T 3 US R E

TYPE MONUMENT STONE MONUMENT

~~ON SURFACE~~ - BELOW 12"

OFFSET \odot PAVEMENT _____ LT : RT

_____ TO _____ EDGE PAVEMENT


STATION: 74+97.6

HORZ. DATUM: _____


GEOID: _____

GRID: NORTHING: _____

EASTING: _____

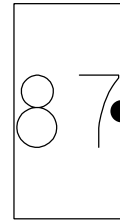

RECORD:
FD STONE MON.
12" DOWN
10/26/77, JUHASZ

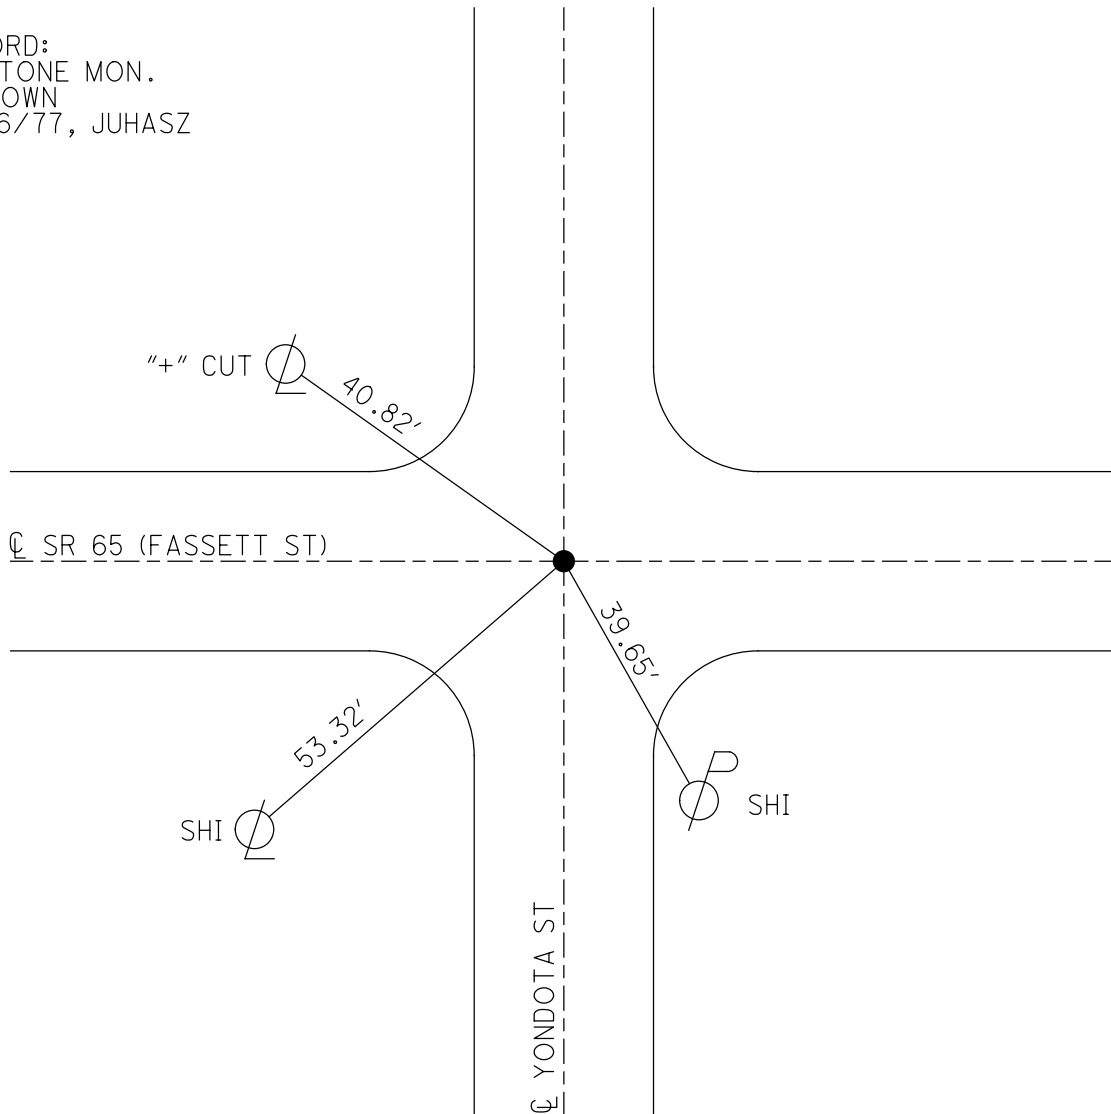

PERSONNEL	TITLE	PERSONNEL	TITLE	PROJECT	DATE
LUHASZ					10/26/77
SCOLLOZI				PROJECT LIMITS	WEATHER
WILLIAMS				FROM STA. _____ TO STA. _____	TEMP. _____

DESCRIPTION MON REF - FASSETT ST RESURF

