

O.D.O.T. DISTRICT 2 SURVEY OFFICE (USE ONLY)

PERSONNEL

REFERENCE NO. 10

SHEET 12 OF 14

NOTES LEU

DATE 5/21/18

ROUTE SR 65

H.C. LEU

WEATHER SUNNY

COUNTY LUCAS

R.C. HAGEMeyer
RHOADES, TRENKA

TEMP. 66°

TOWNSHIP CITY OF TOLEDO

DWG BY NIESE PID 102953

SECTION 12

T 10 S R 7 E

TYPE MONUMENT MONBOX W/3/4" IPIN

~~ON SURFACE~~ - BELOW ON

OFFSET \odot PAVEMENT ON LT : RT

- TO - EDGE PAVEMENT


STATION: 83+95.2

HORIZ.DATUM: NAD83 2011


GEOID: NAVD88 2012A

GRID: NORTHING: 716554.758

EASTING: 1688262.210

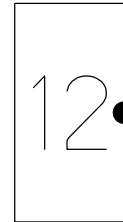

RECORD:
FD IPIN
8" DOWN
10/26/77, JUHASZ
FD MONBOX
W/ 3/4" IPIN
CP1
5/21/18, JLL

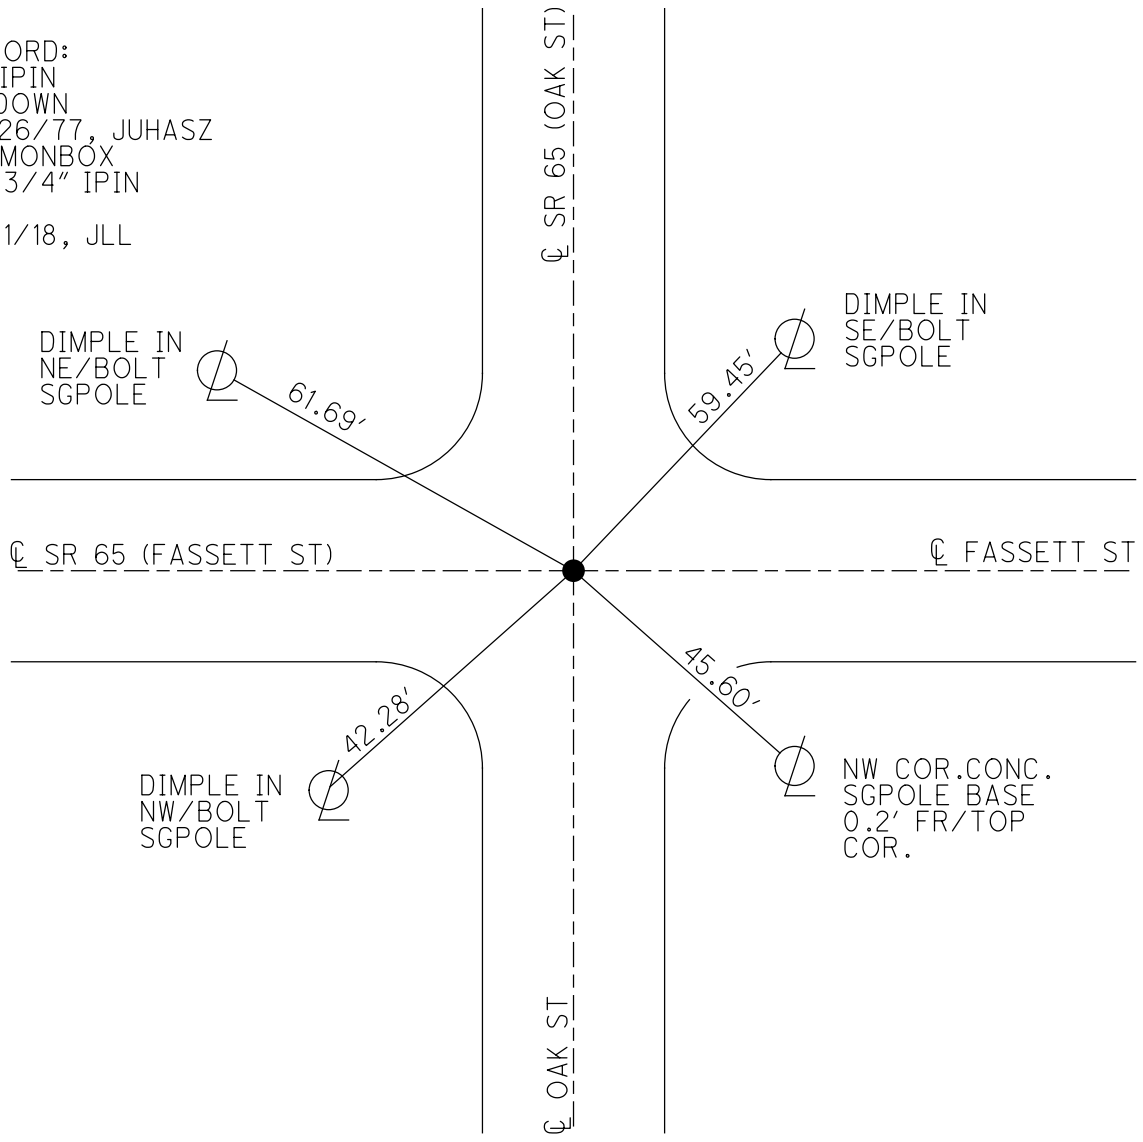

| | | | | | |
|-----------|-------|-----------|-------|---------|------|
| PERSONNEL | TITLE | PERSONNEL | TITLE | PROJECT | DATE |
|-----------|-------|-----------|-------|---------|------|

| | | | | | |
|---------------|--|--|--|--|-----------------|
| <u>LUHASZ</u> | | | | | <u>10/26/77</u> |
|---------------|--|--|--|--|-----------------|

| | | | | | |
|-----------------|--|--|--|----------------|---------|
| <u>SCOLLOZI</u> | | | | PROJECT LIMITS | WEATHER |
|-----------------|--|--|--|----------------|---------|

| | | | | | | |
|-----------------|--|--|--|-----------|---------|-------|
| <u>WILLIAMS</u> | | | | FROM STA. | TO STA. | TEMP. |
|-----------------|--|--|--|-----------|---------|-------|

DESCRIPTION MON REF - FASSETT ST RESURF

