

O.D.O.T. DISTRICT 2 SURVEY OFFICE (USE ONLY)

PERSONNEL

REFERENCE NO. 11

SHEET 13 OF 14

NOTES LEU

DATE 5/21/18

ROUTE SR 65

H.C. LEU

WEATHER SUNNY

COUNTY LUCAS

R.C. HAGEMEYER
RHOADES, TRENKA

TEMP. 66°

TOWNSHIP CITY OF TOLEDO

DWG BY NIESE PID 102953

SECTION 12

T 10 S R 7 E

TYPE MONUMENT MONBOX W/IPIN

ON SURFACE - ~~BELOW~~ ON

OFFSET 0 PAVEMENT ON LT : RT

- TO - EDGE PAVEMENT

STATION: 94+59.20

HORIZ.DATUM: NAD83 2011

GEOID: NAVD88 2012A


GRID: NORTHING: 717619.179

EASTING: 1688251.701



RECORD:
FD COVERED
MONBOX
8/25/71, TOMSIC
FD MONBOX
W/IPIN
CP2
5/21/18, JLL

SET "+" CUT
CURBS

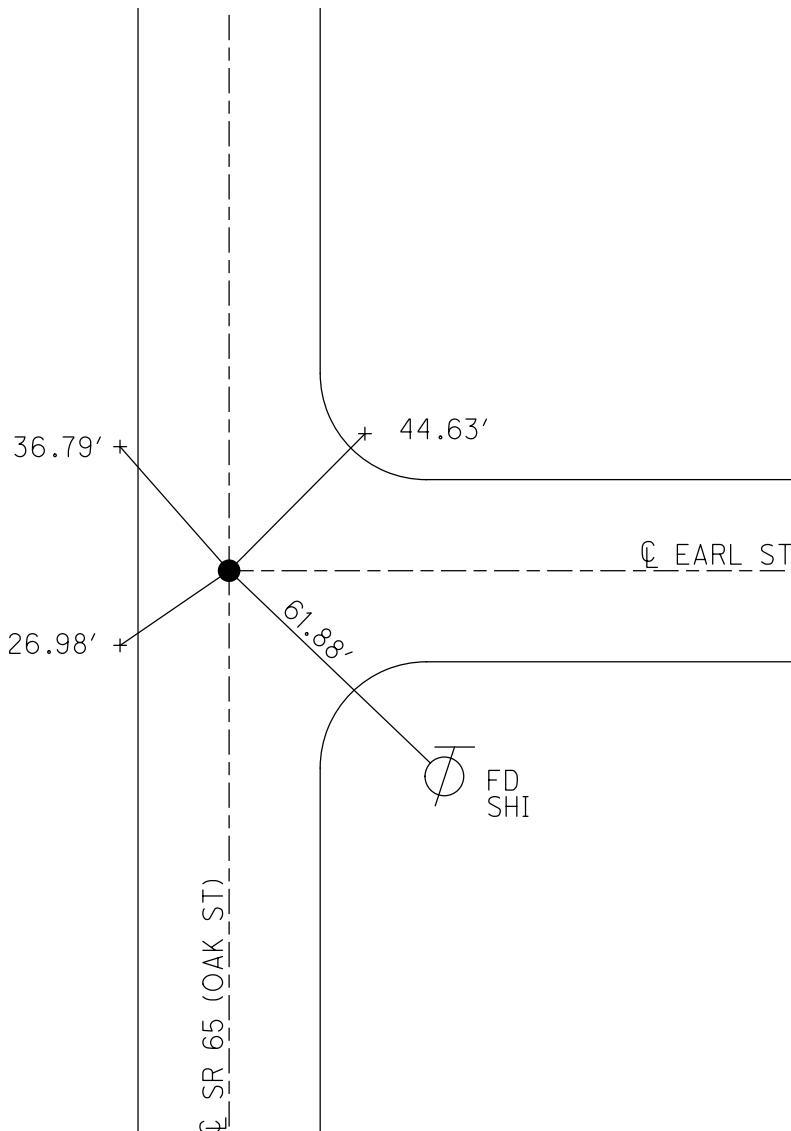

PERSONNEL	TITLE	PERSONNEL	TITLE
Tomsic			
Vanyo			
Granata			
Jackson			

COUNTY LUCAS DATE Aug, 25, 1971
 S. R. #65 WEATHER Fair
 SEC. _____ TEMP. 80's

DESCRIPTION Reference Mon. on S.R. #65 JOB NO. _____

