

O.D.O.T. DISTRICT 2 SURVEY OFFICE (USE ONLY)

PERSONNEL

REFERENCE NO. 12

SHEET 14 OF 14

NOTES LEU

DATE 5/21/18

ROUTE SR 65

H.C. LEU

WEATHER SUNNY

COUNTY LUCAS

R.C. HAGEMEYER

TEMP. 70°

TOWNSHIP CITY OF TOLEDO

RHOADES, TRENKA

SECTION 12

DWG BY NIESE PID 102953

T 10 S R 7 E

TYPE MONUMENT 1" IPIN

~~ON SURFACE~~ - BELOW 4"

OFFSET \odot PAVEMENT ON LT : RT

- TO - EDGE PAVEMENT



STATION: 110+23.19

HORIZ.DATUM: NAD83 2011

GEOID: NAVD88 2012A

GRID: NORTHING: 719182.628

EASTING: 1688237.303

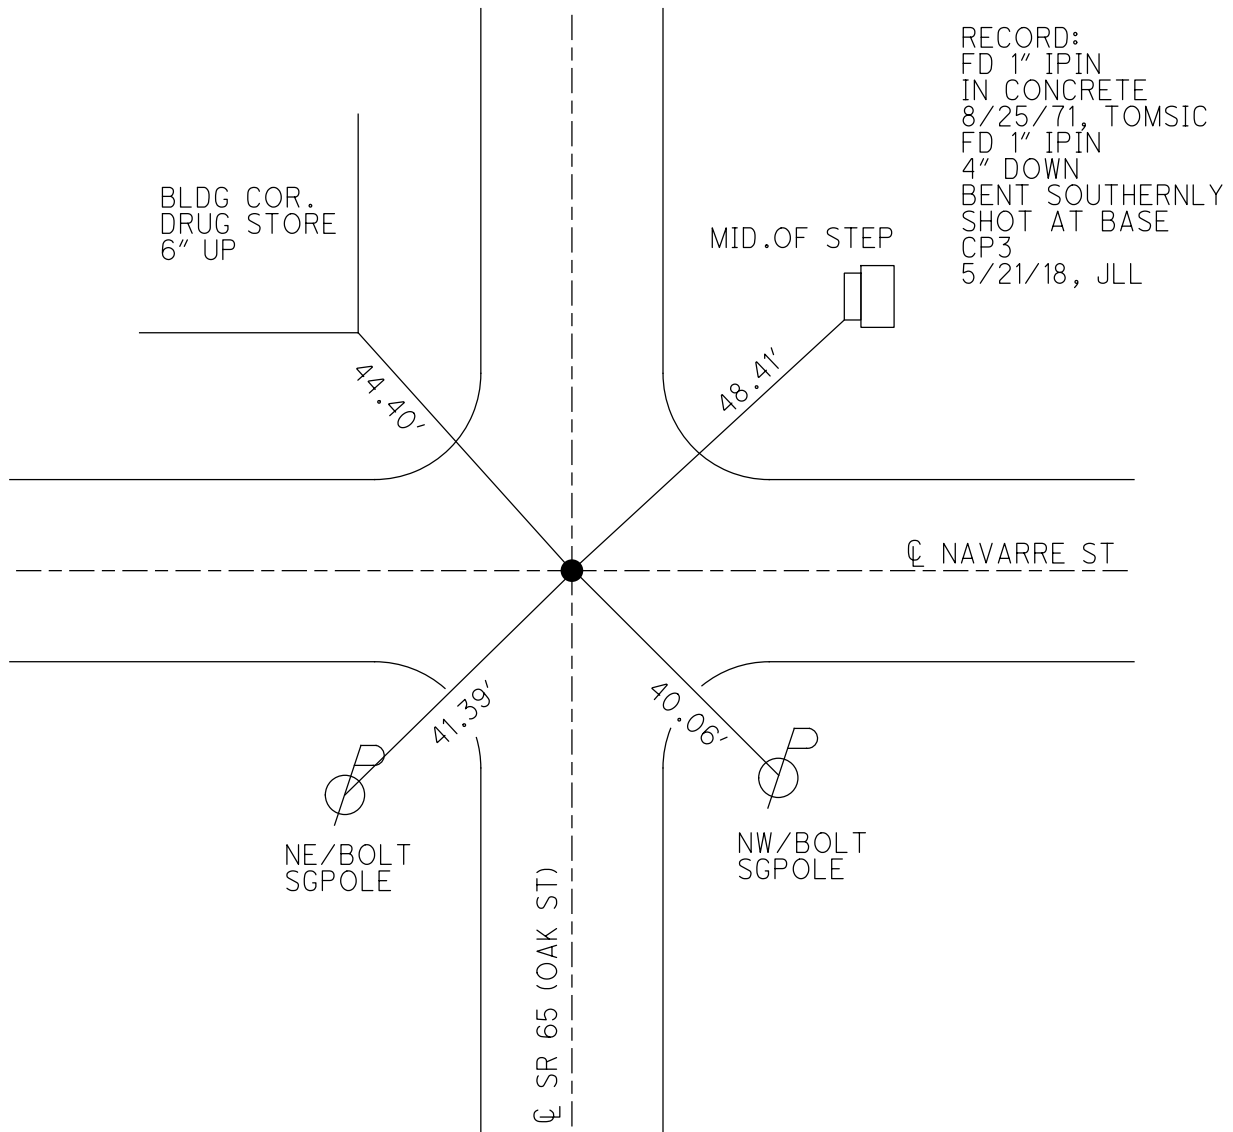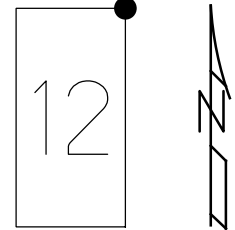

PERSONNEL	TITLE	PERSONNEL	TITLE
Tomsie			
Watts			
McGinn			
Johnson			

COUNTY LUCAS DATE Aug. 25, 1911
 S. R. # 65 WEATHER Fair
 SEC. _____ TEMP. _____

DESCRIPTION Reference Mon. on S. R. #65 JOB NO. _____

