

O.D.O.T. DISTRICT 2 SURVEY OFFICE (USE ONLY)

PERSONNEL _____

REFERENCE NO. _____

SHEET 9 OF 20

NOTES TOMSIK DATE 11/9/72

ROUTE I-75

H.C. NEUSER WEATHER _____

COUNTY LUCAS

R.C. VANYO TEMP. _____

TOWNSHIP CITY OF TOLEDO

GRANATA

SECTION 27

DWG BY NIESE PID _____

T 9 S 7 E

TYPE MONUMENT IPIN

ON SURFACE - BELOW ON


OFFSET CL PAVEMENT _____ LT : RT

- TO - EDGE PAVEMENT


STATION: 262+00

HORIZ.DATUM: _____ GEOID: _____

GRID: NORTHING: _____ EASTING: _____

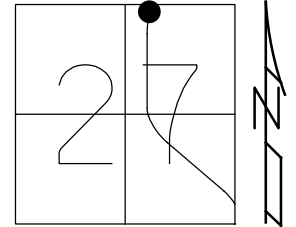

RECORD:
REFERENCE CONTROL POINT
SET BY PIERCE SURVEY
11/9/72, TOMSIK

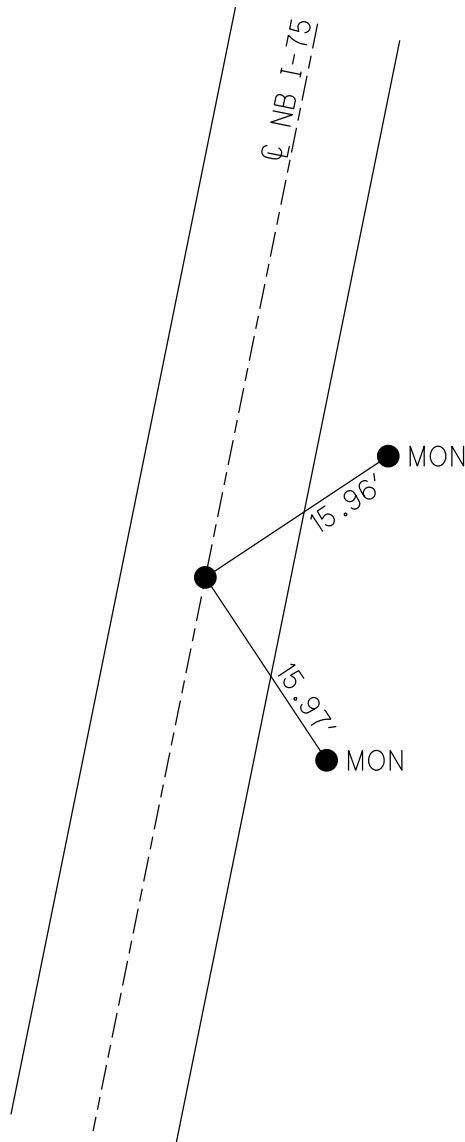

NORTH BOUND LANE

PERSONNEL	TITLE	PERSONNEL	TITLE	COUNTY	DATE
<u>Tomsic</u>				<u>Lucas</u>	<u>Nov.-9-72</u>
KEUSER				S. R.	WEATHER
<u>VANZO</u>				<u>I-75</u>	
<u>Granata</u>				SEC.	TEMP.
				<u>Central to Drexel</u>	
DESCRIPTION	Reference	Control	POINTS	(Set by Peirce Survey)	JOB NO.
	LEFT	CENTER LINE	RIGHT		<u>0516</u>

