

O.D.O.T. DISTRICT 2 SURVEY OFFICE (USE ONLY)

PERSONNEL

REFERENCE NO. _____

SHEET 10 OF 20

NOTES TOMSIK

DATE 11/9/72

ROUTE I-75

H.C. NEUSER

WEATHER _____

COUNTY LUCAS

R.C. VANYO

TEMP. _____

TOWNSHIP CITY OF TOLEDO

GRANATA

SECTION 22

DWG BY NIESE PID _____

T 9 S R 7 E

TYPE MONUMENT MONBOX

ON SURFACE - BELOW _____


OFFSET \odot PAVEMENT _____ LT : RT

- TO - EDGE PAVEMENT


STATION: 264+65.85

HORZ.DATUM: NAD83(ADJUSTED 1995) GEOID: _____

GRID: NORTHING: 734705.714 EASTING: 1675293.340

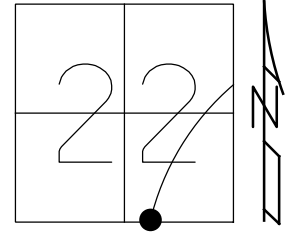

RECORD: P.C.C.
REFERENCE CONTROL POINT
SET BY PIERCE SURVEY
11/9/72, TOMSIK
MONBOX SET BY OTHERS
I-75 \odot R/W SB ALIGNMENT
PID 77254
4/24/20

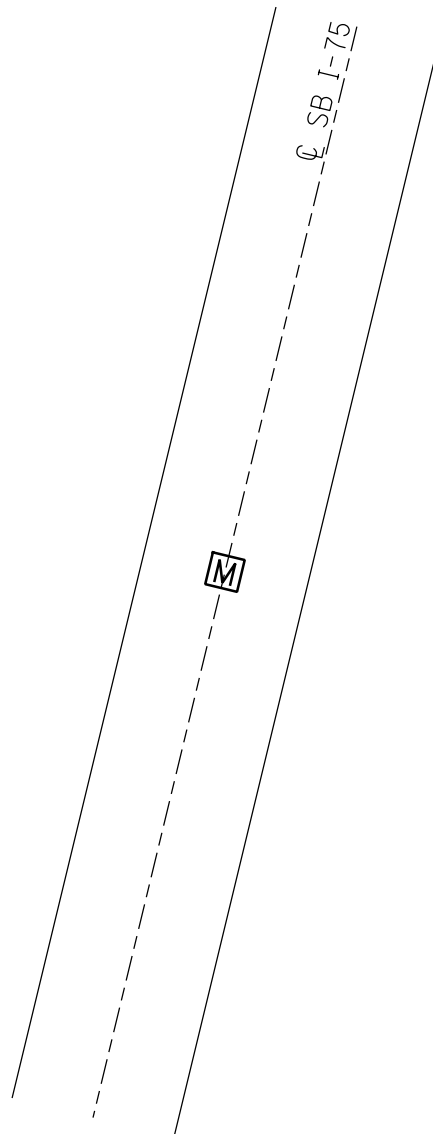

SOUTH BOUND LANE

PERSONNEL TITLE PERSONNEL TITLE

COUNTY LUCAS

DATE NOV. - 9 - 72

Tomsic

S. R. I-75

WEATHER

Neusec

Vanyo

SEC. Central To Drexel TEMP.

Granata

DESCRIPTION Reference CONTROL POINTS (SET BY PGIRCG SURVEY) JOB NO. 0516

