

O.D.O.T. DISTRICT 2 SURVEY OFFICE (USE ONLY)

PERSONNEL

REFERENCE NO. _____

SHEET 11 OF 20

NOTES TOMSIC

DATE 11/9/72

ROUTE I-75

H.C. NEUSER

WEATHER _____

COUNTY LUCAS

R.C. VANYO

TEMP. _____

TOWNSHIP CITY OF TOLEDO

GRANATA

SECTION 22

DWG BY NIESE PID _____

T 9 S R 7 E

TYPE MONUMENT MONBOX

ON SURFACE - ~~BELOW~~ ON


OFFSET Q PAVEMENT _____ LT : RT

- TO - EDGE PAVEMENT

STATION: 270+28.09


HORIZ.DATUM: NAD83(ADJUSTED 1995) GEOID: _____

GRID: NORTHING: 735291.487 EASTING: 1675800.541

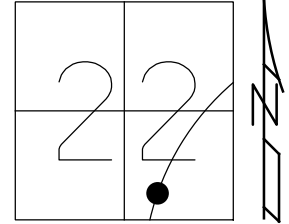

RECORD: P.C.C.
REFERENCE CONTROL POINT
SET BY PIERCE SURVEY
11/9/72, TOMSIC
MONBOX SET BY OTHERS
I-75 Q R/W NB ALIGNMENT
PID 77254
4/24/20

RECORD: P.T.
REFERENCE CONTROL POINT
SET BY PIERCE SURVEY
11/9/72, TOMSIC
MONBOX SET BY OTHERS
I-75 Q R/W NB ALIGNMENT
PID 77254
4/24/20

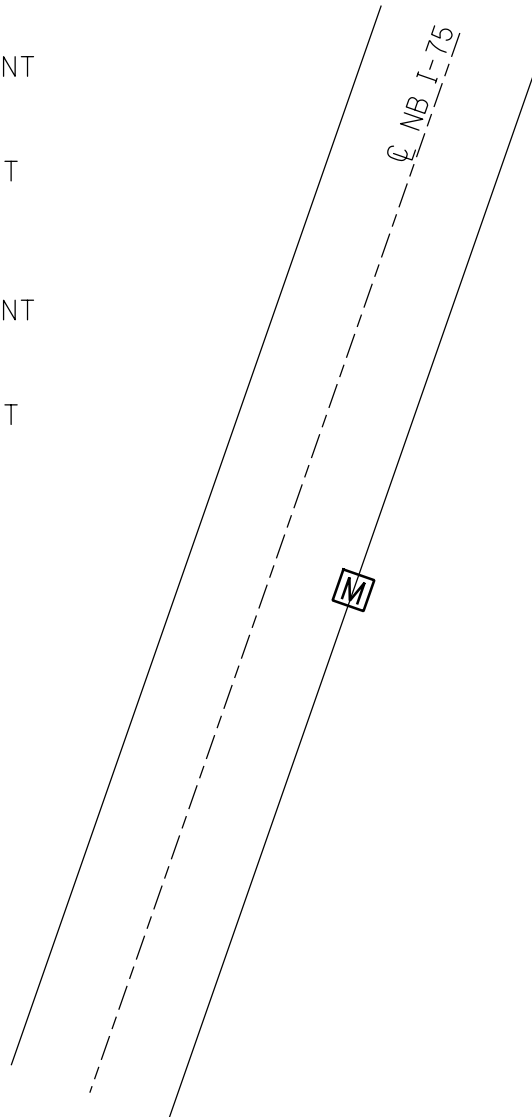

NORTH BOUND LANE

PERSONNEL	TITLE	PERSONNEL	TITLE	COUNTY	DATE
<u>Tomsic</u>				<u>Lucas</u>	<u>Nov.-9-72</u>
KEUSER				S. R.	WEATHER
<u>VANZO</u>				<u>I-75</u>	
<u>Granata</u>				SEC.	TEMP.
				<u>Central to Drexel</u>	
DESCRIPTION	Reference	Control	POINTS	(Set by Peirce Survey)	JOB NO.
	LEFT	CENTER LINE	RIGHT		<u>0516</u>

