

O.D.O.T. DISTRICT 2 SURVEY OFFICE (USE ONLY)

PERSONNEL _____

REFERENCE NO. _____

SHEET 14 OF 20

NOTES TOMSIC

DATE 11/9/72

ROUTE I-75

H.C. NEUSER

WEATHER _____

COUNTY LUCAS

R.C. VANYO

TEMP. _____

TOWNSHIP CITY OF TOLEDO

GRANATA

SECTION 22

DWG BY NIESE PID _____

T 9 S R 7 E

TYPE MONUMENT IPIN

ON SURFACE - BELOW ON


OFFSET \varnothing PAVEMENT _____ LT : RT

- TO - EDGE PAVEMENT


STATION: 284+00

HORIZ.DATUM: _____ GEOID: _____

GRID: NORTHING: _____ EASTING: _____

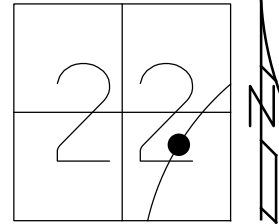

RECORD:
REFERENCE CONTROL POINT
SET BY PIERCE SURVEY
11/9/72, TOMSIC

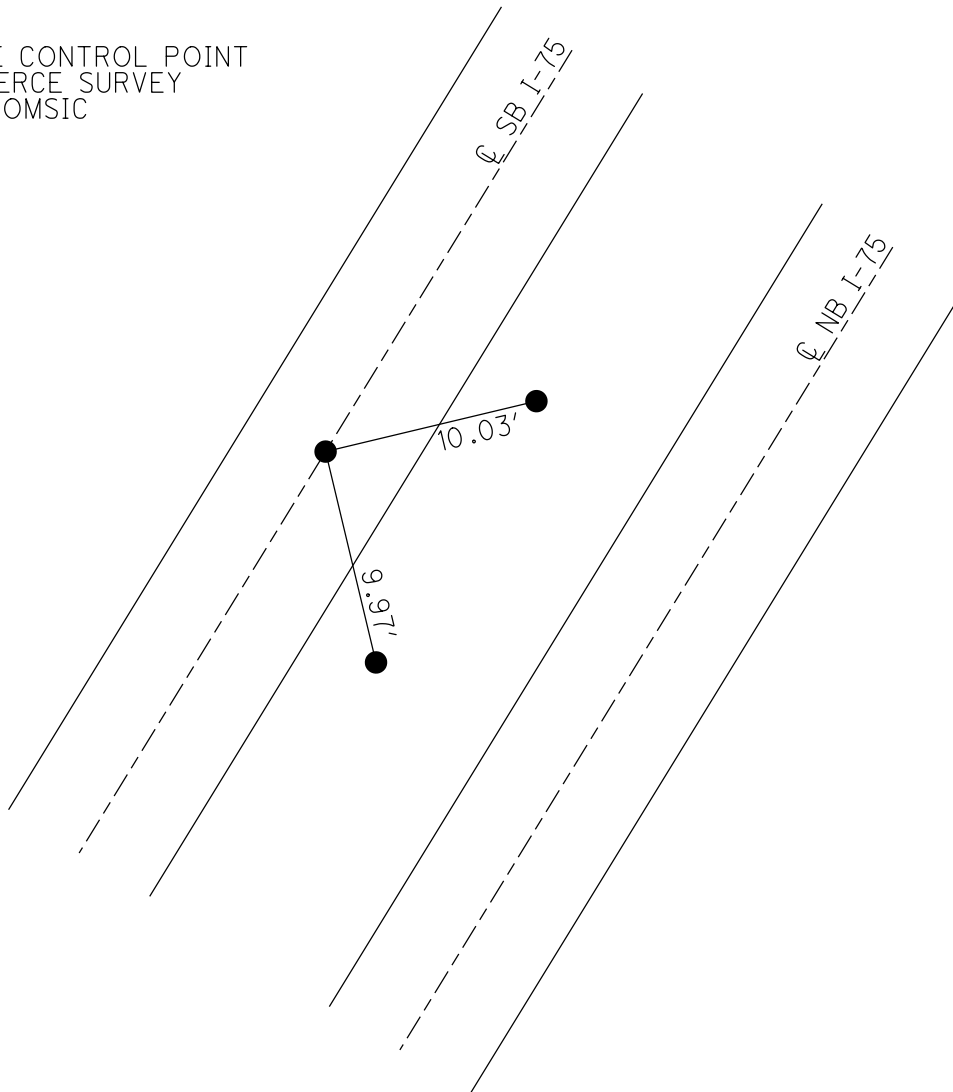

SOUTH BOUND LANE

PERSONNEL	TITLE	PERSONNEL	TITLE
Tomsic			
Neusec			
Vanyo			
Granata			

COUNTY LUCAS DATE Nov. - 9-72
 S. R. I-75 WEATHER _____
 SEC. Central to Drexel TEMP. _____

DESCRIPTION Reference CONTROL POINTS (SET BY PGIRCG SURVEY) JOB NO. 0516

