

O.D.O.T. DISTRICT 2 SURVEY OFFICE (USE ONLY)

PERSONNEL _____

REFERENCE NO. _____

SHEET 16 OF 20

NOTES TOMSIK

DATE 11/9/72

ROUTE I-75

H.C. NEUSER

WEATHER _____

COUNTY LUCAS

R.C. VANYO

TEMP. _____

TOWNSHIP CITY OF TOLEDO

GRANATA

SECTION 22

DWG BY NIESE

PID _____

T 9 S R 7 E

TYPE MONUMENT IPIN

ON SURFACE - BELOW ON

OFFSET \varnothing PAVEMENT _____ LT : RT

- TO - EDGE PAVEMENT


STATION: 289+68.50

HORZ.DATUM: _____


GEOID: _____

GRID: NORTHING: _____

EASTING: _____

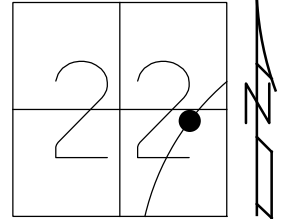

RECORD:
REFERENCE CONTROL POINT
SET BY PIERCE SURVEY
11/9/72, TOMSIK

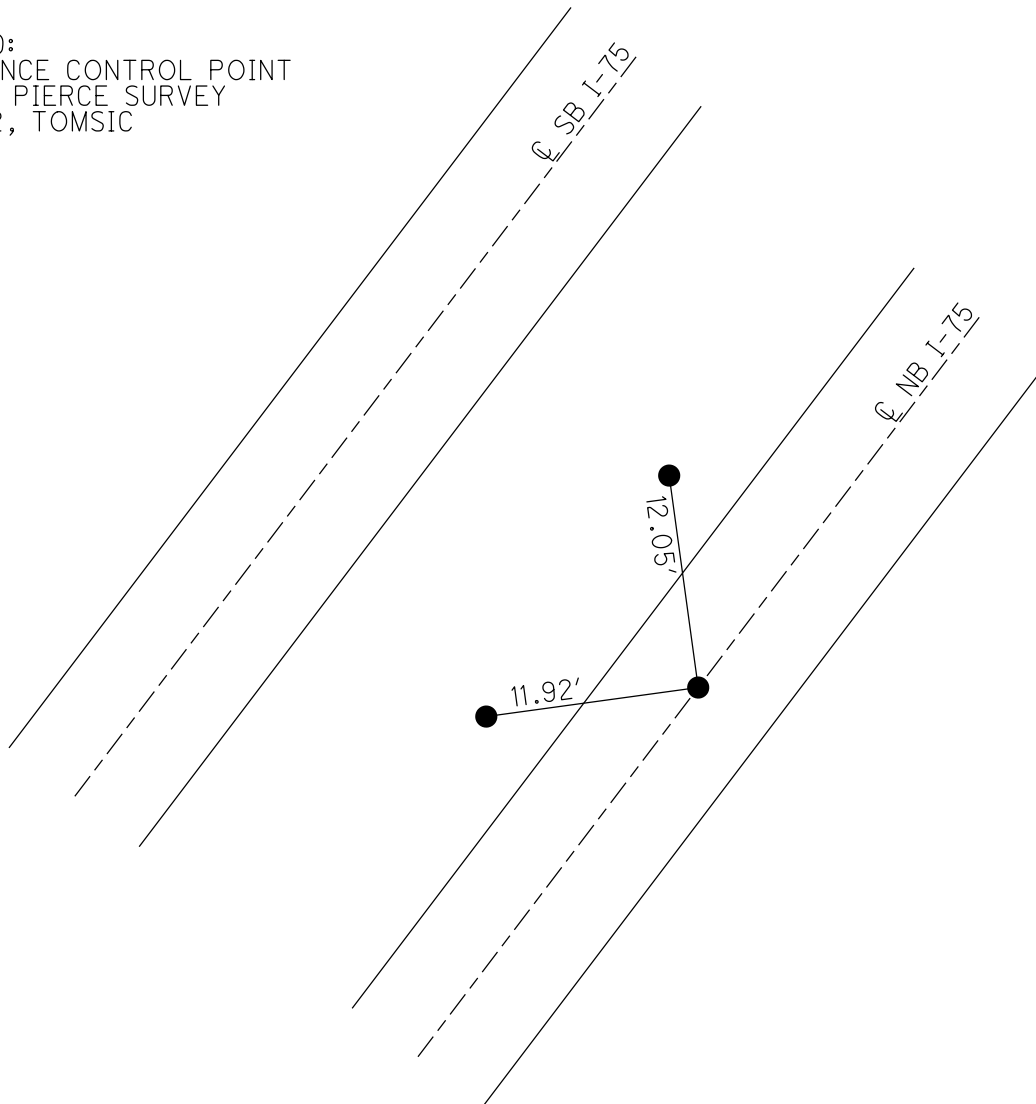

NORTH BOUND LANE

PERSONNEL	TITLE	PERSONNEL	TITLE
Tomsic			
Neuser			
Vargo			
Grant			

COUNTY LUCAS DATE Nov-9-72
 S. R. I-75 WEATHER _____
 SEC. Central to Drexel TEMP. _____

DESCRIPTION Reference CONTROL POINTS (Set by POIRCE Survey) JOB NO. 0516
 LEFT CENTER LINE RIGHT

