

O.D.O.T. DISTRICT 2 SURVEY OFFICE (USE ONLY)

PERSONNEL _____

REFERENCE NO. _____

SHEET 20 OF 20

NOTES _____

DATE 10/10/71

ROUTE I-75

H.C. _____

WEATHER _____

COUNTY LUCAS

R.C. _____

TEMP. _____

TOWNSHIP CITY OF TOLEDO

DWG BY NIESE

PID _____

SECTION 23

T 9 S R 7 E

TYPE MONUMENT IPIN

ON SURFACE - ~~BELOW~~ ON


OFFSET 0.25' ~~LT~~ : RT

- TO - EDGE PAVEMENT


STATION: 350+99.12

HORZ. DATUM: NAD83(ADJUSTED 1995) GEOID: _____

GRID: NORTHING: 738143.704 EASTING: 1682227.057

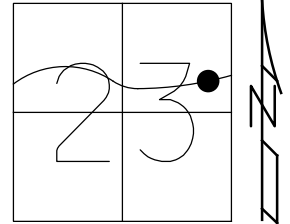

RECORD: P.C.
STA 350+99.18
11/10/71, RWB
FD IPIN
I-75 0 R/W
PROPOSED DISC
PID 77254
4/24/20

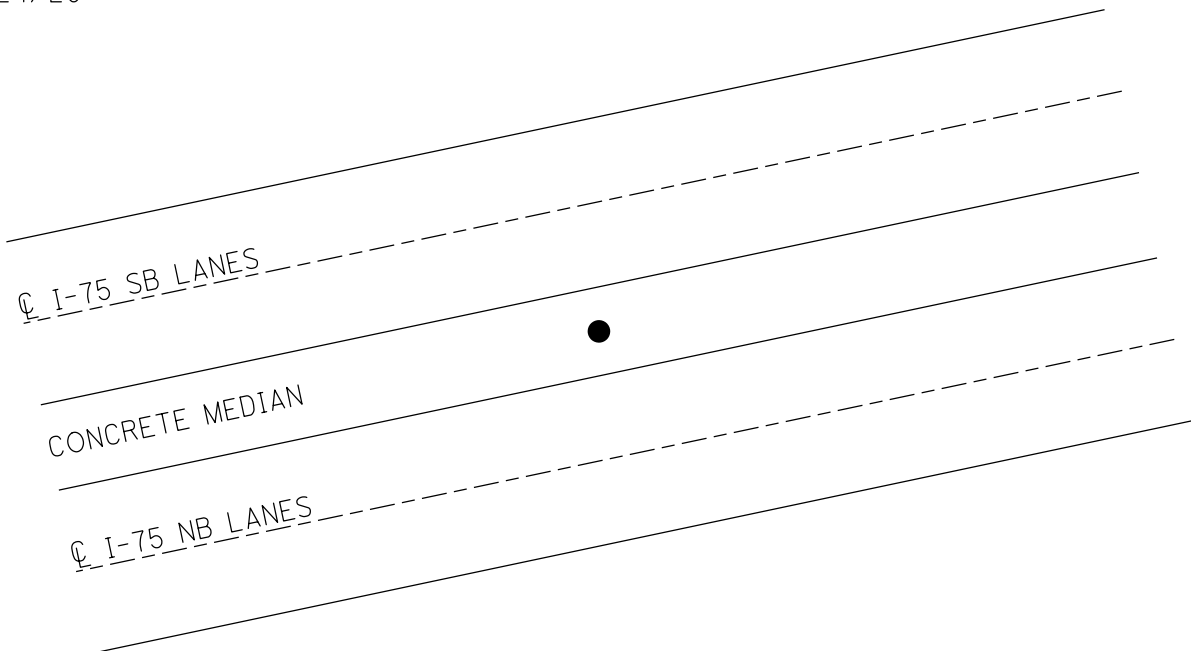

RWB

REF. NO. 4 SUBJECT CENTERLINE MONUMENTS MEASUREMENT DATE 10-10-71 INITIALS RWB

ITEM NO. 604 PROJECT NO. 8723-69 COMPUTATION DATE _____ INITIALS _____

LOCATION LU-IR-75-614

