

O.D.O.T. DISTRICT 2 SURVEY OFFICE (USE ONLY)

PERSONNEL _____

REFERENCE NO. _____

SHEET 2 OF 34

NOTES VAN DUSEN

DATE 2/3/98

ROUTE I-75

H.C. MOSER

WEATHER CLEAR

COUNTY LUCAS

R.C. HUSS
WATSON

TEMP. 35°

TOWNSHIP CITY OF TOLEDO

DWG BY NIESE

PID _____

SECTION 17

T 9 S R 8 E

TYPE MONUMENT P.K./WASHER

ON SURFACE - ~~BELOW~~ ON

OFFSET \bar{C} PAVEMENT 53.12' ~~RT~~ : RT

- TO - EDGE PAVEMENT


STATION: 415+97.34

HORZ.DATUM: _____

GEOID: _____

GRID: NORTHING: _____

EASTING: _____

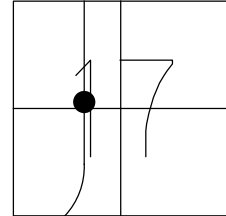


RECORD:
STA 415+97.34
SET P.K./WASHER
TRAVERSE PT#1043
N: 42528.239
E: 38939.540
2/3/98, VAN DUSEN

\bar{C} SB I-75

\bar{C} NB I-75

CONCRETE MEDIAN

SET 1/4" DRILL HOLES
IN FACE OF WALL

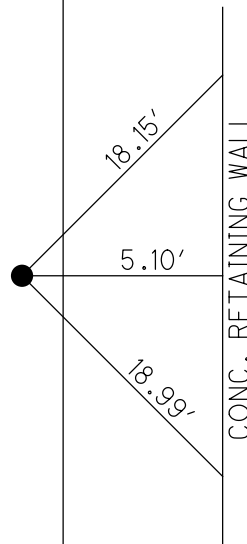

PERSONNEL	TITLE	PERSONNEL	TITLE
VAN DUSEN			
MOSEY			
HUSS			
WATSON			

COUNTY LUCAS DATE 2-3-98
 S.R. I-75 WEATHER CLEAR
 SEC. 2.83 TEMP. +35°F

DESCRIPTION REF. TIES FOR TRAVERSE PT. # 1043 STA 415+97.34 JOB NO. 023350
 LEFT CENTER LINE RIGHT

