

O.D.O.T. DISTRICT 2 SURVEY OFFICE (USE ONLY)

PERSONNEL _____

REFERENCE NO. _____

SHEET 9 OF 34

NOTES VAN DUSEN

DATE 2/3/98

ROUTE I-75

H.C. MOSER

WEATHER CLEAR

COUNTY LUCAS

R.C. HUSS

TEMP. 35°

TOWNSHIP CITY OF TOLEDO

WATSON

SECTION 8

DWG BY NIESE PID _____

T 9 S R 8 E

TYPE MONUMENT 1/4" DRILL HOLE

ON SURFACE - ~~BELOW~~ ON


OFFSET \varnothing PAVEMENT 54.66' LT : ~~RT~~

- TO - EDGE PAVEMENT


STATION: 449+84.72

HORZ.DATUM: _____ GEOID: _____

GRID: NORTHING: _____ EASTING: _____

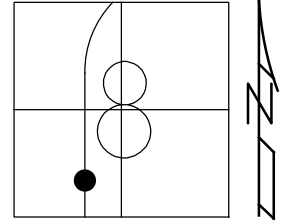

RECORD:
 SET 1/4" DRILL HOLE
 TRAVERSE PT#1034
 N: 45801.142
 E: 38060.304
 2/3/98, VAN DUSEN

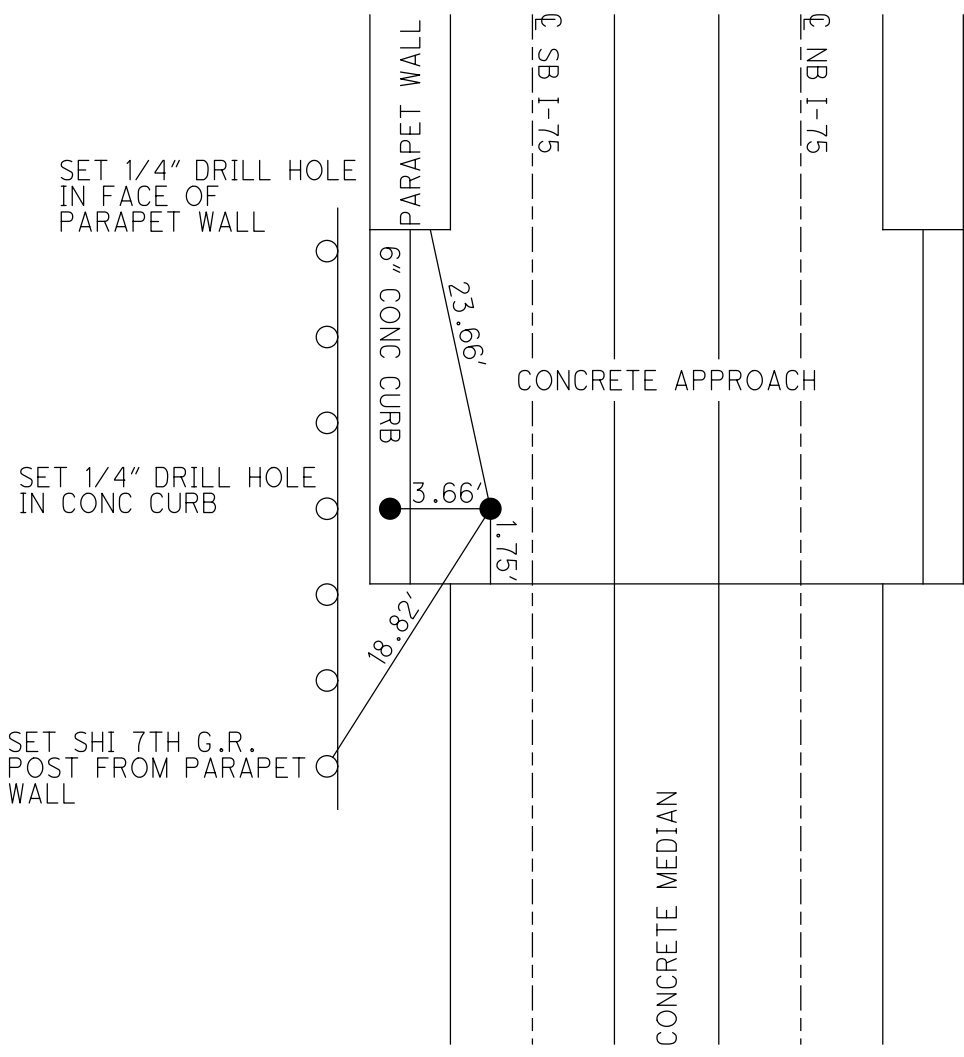

PERSONNEL	TITLE	PERSONNEL	TITLE
VAN DUSEN			
MOSEER			
HUSS			
WATSON			

COUNTY LUCAS DATE 2-3-98
 S.A. I-75 WEATHER CLEAR
 SEC. 2.83 TEMP. +35°F

DESCRIPTION REF. TIES FOR TRAVERSE PT. #1034 JOB NO. 023350

