

O.D.O.T. DISTRICT 2 SURVEY OFFICE (USE ONLY)

PERSONNEL

REFERENCE NO. \_\_\_\_\_

SHEET 29 OF 34

NOTES VAN DUSEN

DATE 1/30/98

ROUTE I-75

H.C. MOSER

WEATHER CLOUDY

COUNTY LUCAS

R.C. HUSS

TEMP. 35°

TOWNSHIP WASHINGTON

DWG BY NIESE PID \_\_\_\_\_

SECTION 5

T 9 S R 8 E


TYPE MONUMENT 1/4" DRILL HOLE

ON SURFACE - ~~BELOW~~ ON \_\_\_\_\_

OFFSET  $\odot$  PAVEMENT \_\_\_\_\_ LT : RT

\_\_\_\_\_ TO \_\_\_\_\_ EDGE PAVEMENT

STATION: 526+78

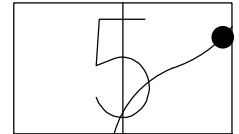


HORZ.DATUM: \_\_\_\_\_

GEOID: \_\_\_\_\_

GRID: NORTHING: \_\_\_\_\_

EASTING: \_\_\_\_\_

RECORD:  
1/4" DRILL HOLE  
IN RETAINING WALL  
PT#1002  
N: 52841.873  
E: 39959.614  
1/30/98, VAN DUSEN

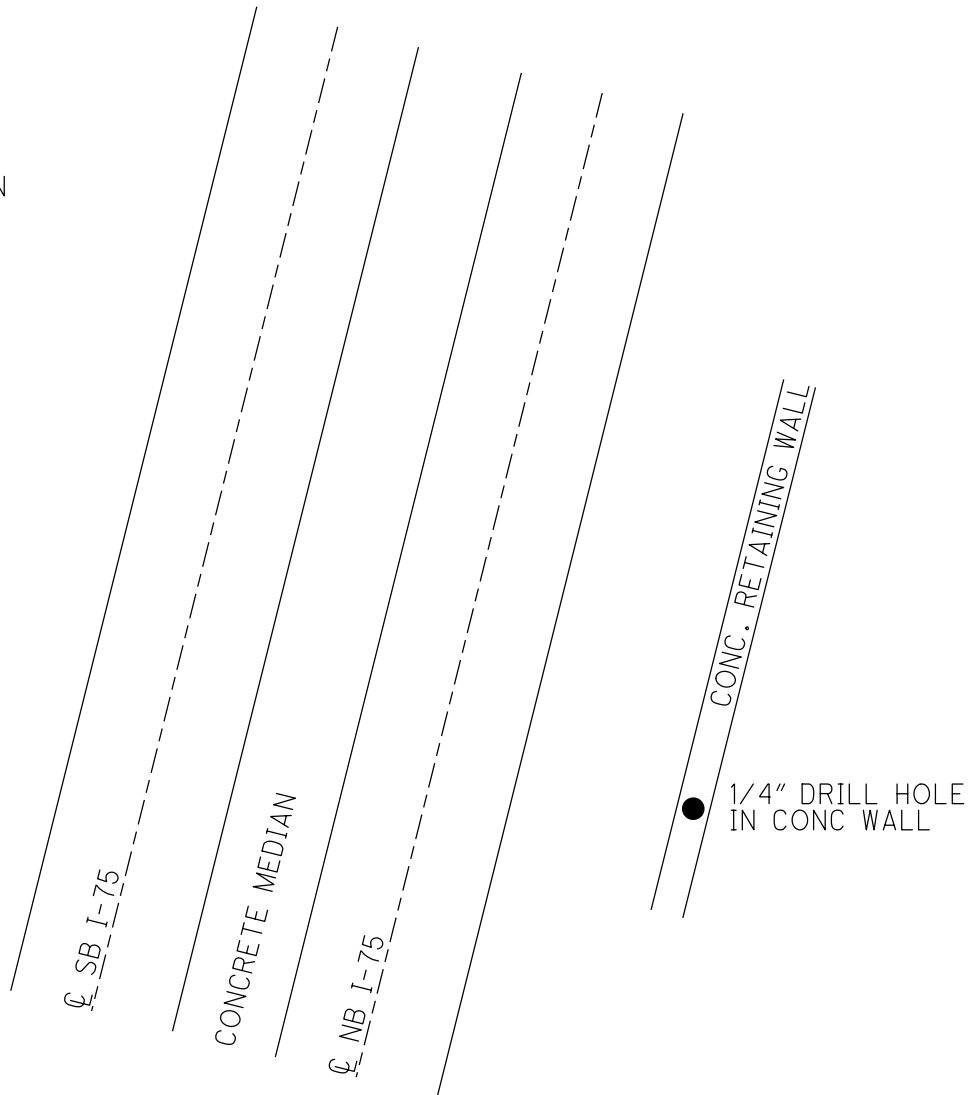

PERSONNEL	TITLE	PERSONNEL	TITLE
VAN DUSEN			
MOSEK			
HUSS			

COUNTY LUCAS DATE 1-30-98  
 S.R. I-75 WEATHER CLOUDY  
 SEC. 2.83 TEMP. +35°F

DESCRIPTION CONFIRMATION & LOCATION OF MONUMENTS JOB NO. 023350  
 LEFT CENTER LINE RIGHT

