

O.D.O.T. DISTRICT 2 SURVEY OFFICE (USE ONLY)

PERSONNEL

REFERENCE NO. _____

SHEET 31 OF 34

NOTES VAN DUSEN

DATE 1/30/98

ROUTE I-75

H.C. MOSER

WEATHER CLOUDY

COUNTY LUCAS

R.C. HUSS

TEMP. 35°

TOWNSHIP WASHINGTON

DWG BY NIESE

PID _____

SECTION 4

T 9 S R 8 E

TYPE MONUMENT P.K. NAIL

ON SURFACE - ~~BELOW~~ ON

OFFSET 0 PAVEMENT _____ LT : RT

- TO - EDGE PAVEMENT


STATION: 537+46.31

HORIZ.DATUM: _____


GEOID: _____

GRID: NORTHING: _____

EASTING: _____

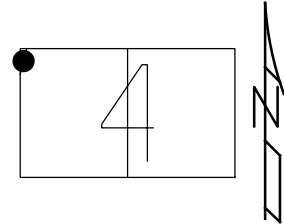

RECORD: C.S.
FD P.K. NAIL IN
PAVEMENT WITH 2
CROSS TIES. MONUMENT
PROBABLY TO BE SET @
A LATER DATE.
ON 0 SURVEY
N: 53651.46
E: 40038.22
1/30/98, VAN DUSEN

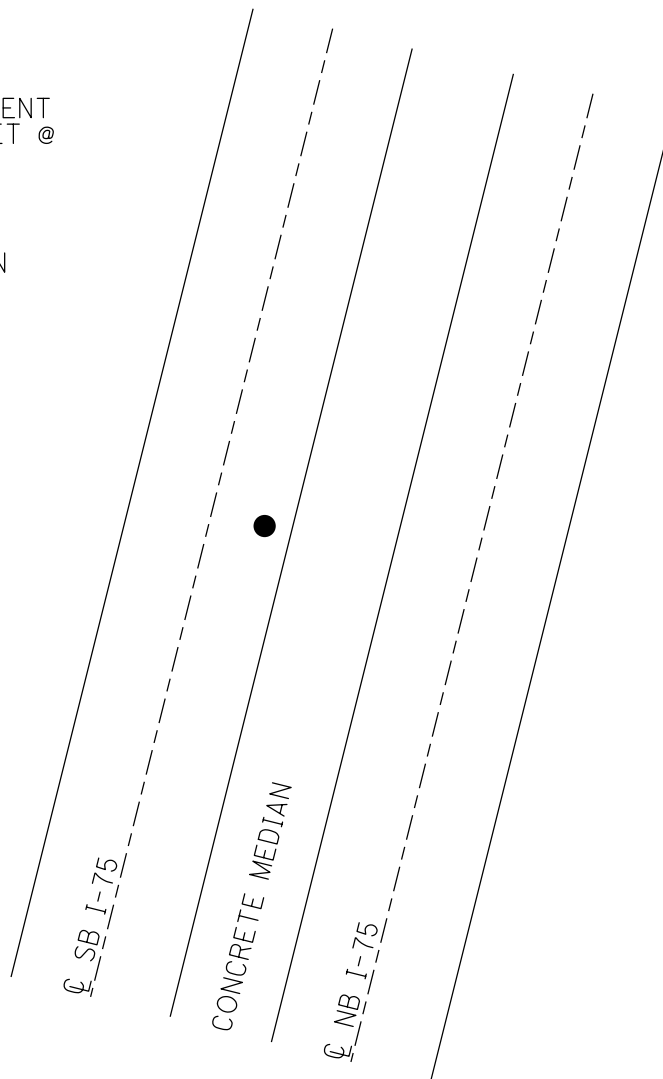

PERSONNEL	TITLE	PERSONNEL	TITLE
VAN DUSEN			
MOSEER			
HUSS			

COUNTY LUCAS DATE 1-30-98
 S.R. I-75 WEATHER CLOUDY
 SEC. 2.83 TEMP. +35°F

DESCRIPTION CONFIRMATION & LOCATION OF MONUMENTS JOB NO. 023350
 LEFT CENTER LINE RIGHT

