

O.D.O.T. DISTRICT 2 SURVEY OFFICE (USE ONLY)

PERSONNEL \_\_\_\_\_

REFERENCE NO. \_\_\_\_\_

SHEET 32 OF 34

NOTES VAN DUSEN

DATE 1/30/98

ROUTE I-75

H.C. MOSER

WEATHER CLOUDY

COUNTY LUCAS

R.C. HUSS

TEMP. 35°

TOWNSHIP WASHINGTON

SECTION 4

DWG BY NIESE PID \_\_\_\_\_

T 9 S R 8 E

TYPE MONUMENT 1/4" DRILL HOLE

ON SURFACE - ~~BELOW~~ ON

OFFSET ℄ PAVEMENT 0.11' ~~±~~ : RT

- TO - EDGE PAVEMENT


STATION: 539+46.06

HORZ. DATUM: \_\_\_\_\_

GEOID: \_\_\_\_\_


GRID: NORTHING: \_\_\_\_\_

EASTING: \_\_\_\_\_

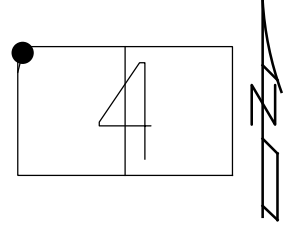

RECORD: S.T.  
SET 1/4" DRILL HOLE  
IN CONC WALL  
ORIGINAL POSITION  
OF IPIN - PRE-CONST  
1/30/98, VAN DUSEN

DIST. IPIN-1/4" D.H. = 0.25'

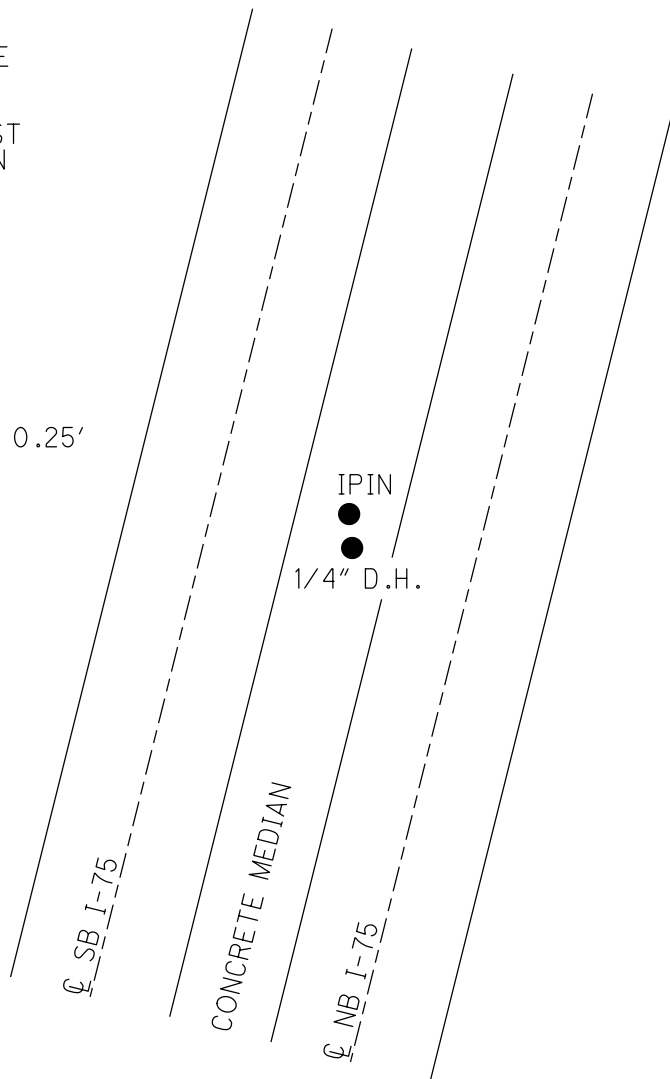

PERSONNEL	TITLE	PERSONNEL	TITLE
VAN DUSEN			
MOSEY			
HUSS			

COUNTY LUCAS DATE 1-30-28  
 S. R. I-75 WEATHER CLOUDY  
 SEC. 7.83 TEMP. +35°F

DESCRIPTION CONFIRMATION & LOCATION OF MONUMENTS JOB NO. 023350  
 LEFT CENTER LINE RIGHT

